FED. ROAD DIST. NO.	STATE	FED. AID PROJ. NO.	FISCAL YEAR	SHEET NO	TOTAL SHEETS
HAWAII	HAW.	F-090-1(10)	1964	15	58

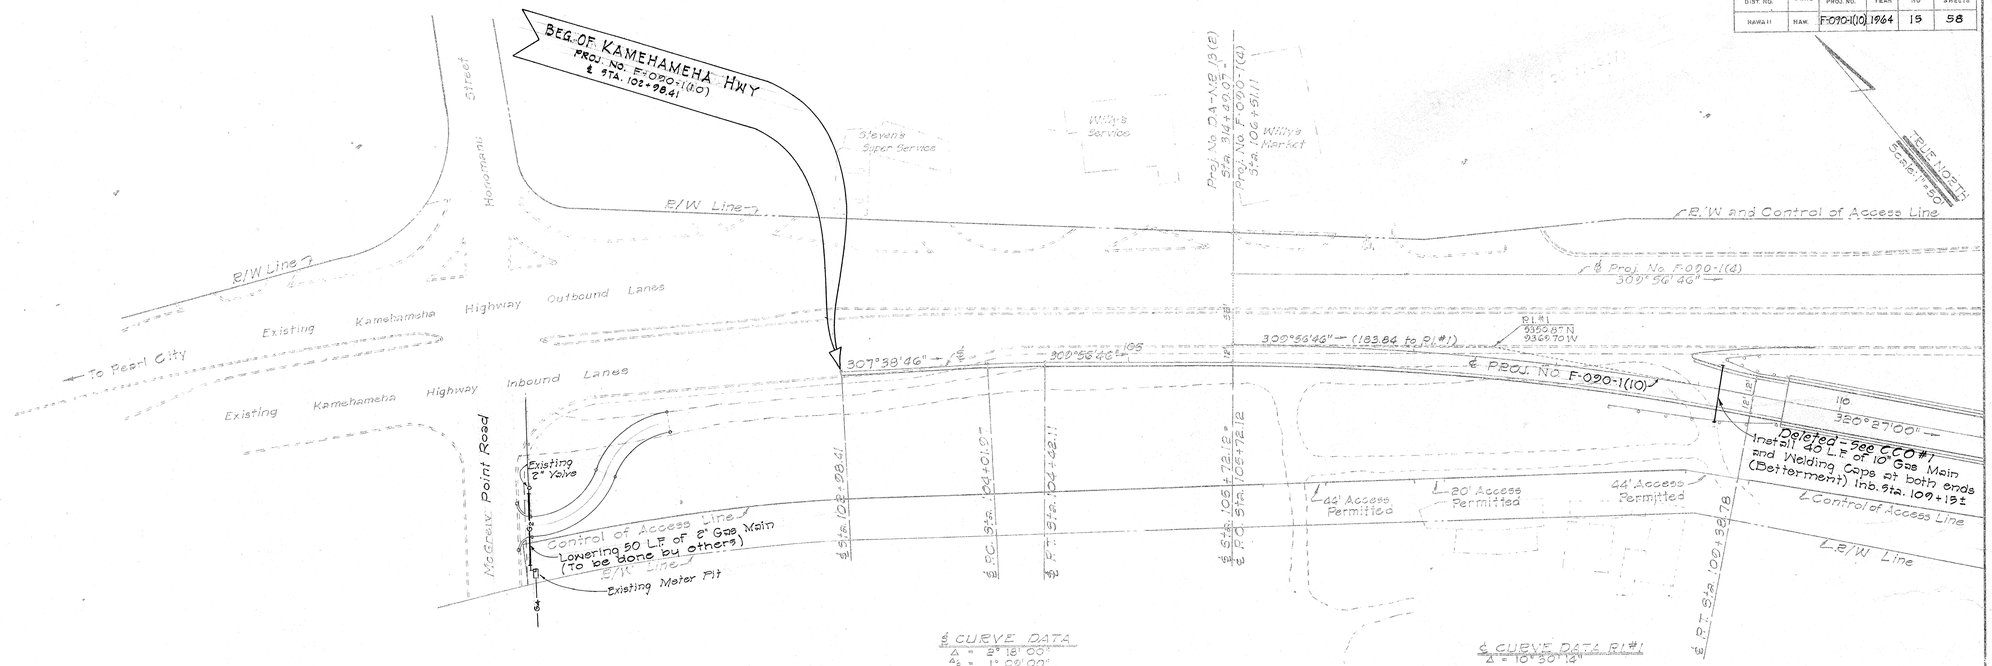

℄ CURVE DATA
Δ/2 = 1° 09' 00"
R = 1000.00
T = 80.07
L = 40.14
C = 40.14

℄ CURVE DATA P.I. #1
Δ = 10° 30' 12"
Δ/2 = 5° 15' 07"
R = 2000.00
T = 183.84
L = 366.66
C = 366.14

NOTE: For additional information concerning the adjustment of the Honolulu Gas Co., Ltd facilities, see Special Provisions.

PLAN	BY	DATE
SURVEYED		
PLOTTED		
PROJECT CHECKED		
NOTE BOOK FIELD CHECKED		
FT. OF WAY CHECKED		
NO.		

PROFILE	BY	DATE
SURVEYED		
PLOTTED		
PROJECT CHECKED		
NOTE BOOK FIELD CHECKED		
B.M.'S NOTED		
NO. STRUCTURE NOTATIONS CH'KD.		

APPROVED:

Paul C. Jones
DIRECTOR OF DEVELOPMENT
HONOLULU GAS Co., Ltd.

9/30/64
DATE

HONOLULU GAS CO.