DIST. NO.	STATE	PROJ. NO.	FISCAL YEAR	SHEET NO.	TOTAL SHEETS
OAHU	HAW.	NH-0300(175)	2021	13	73

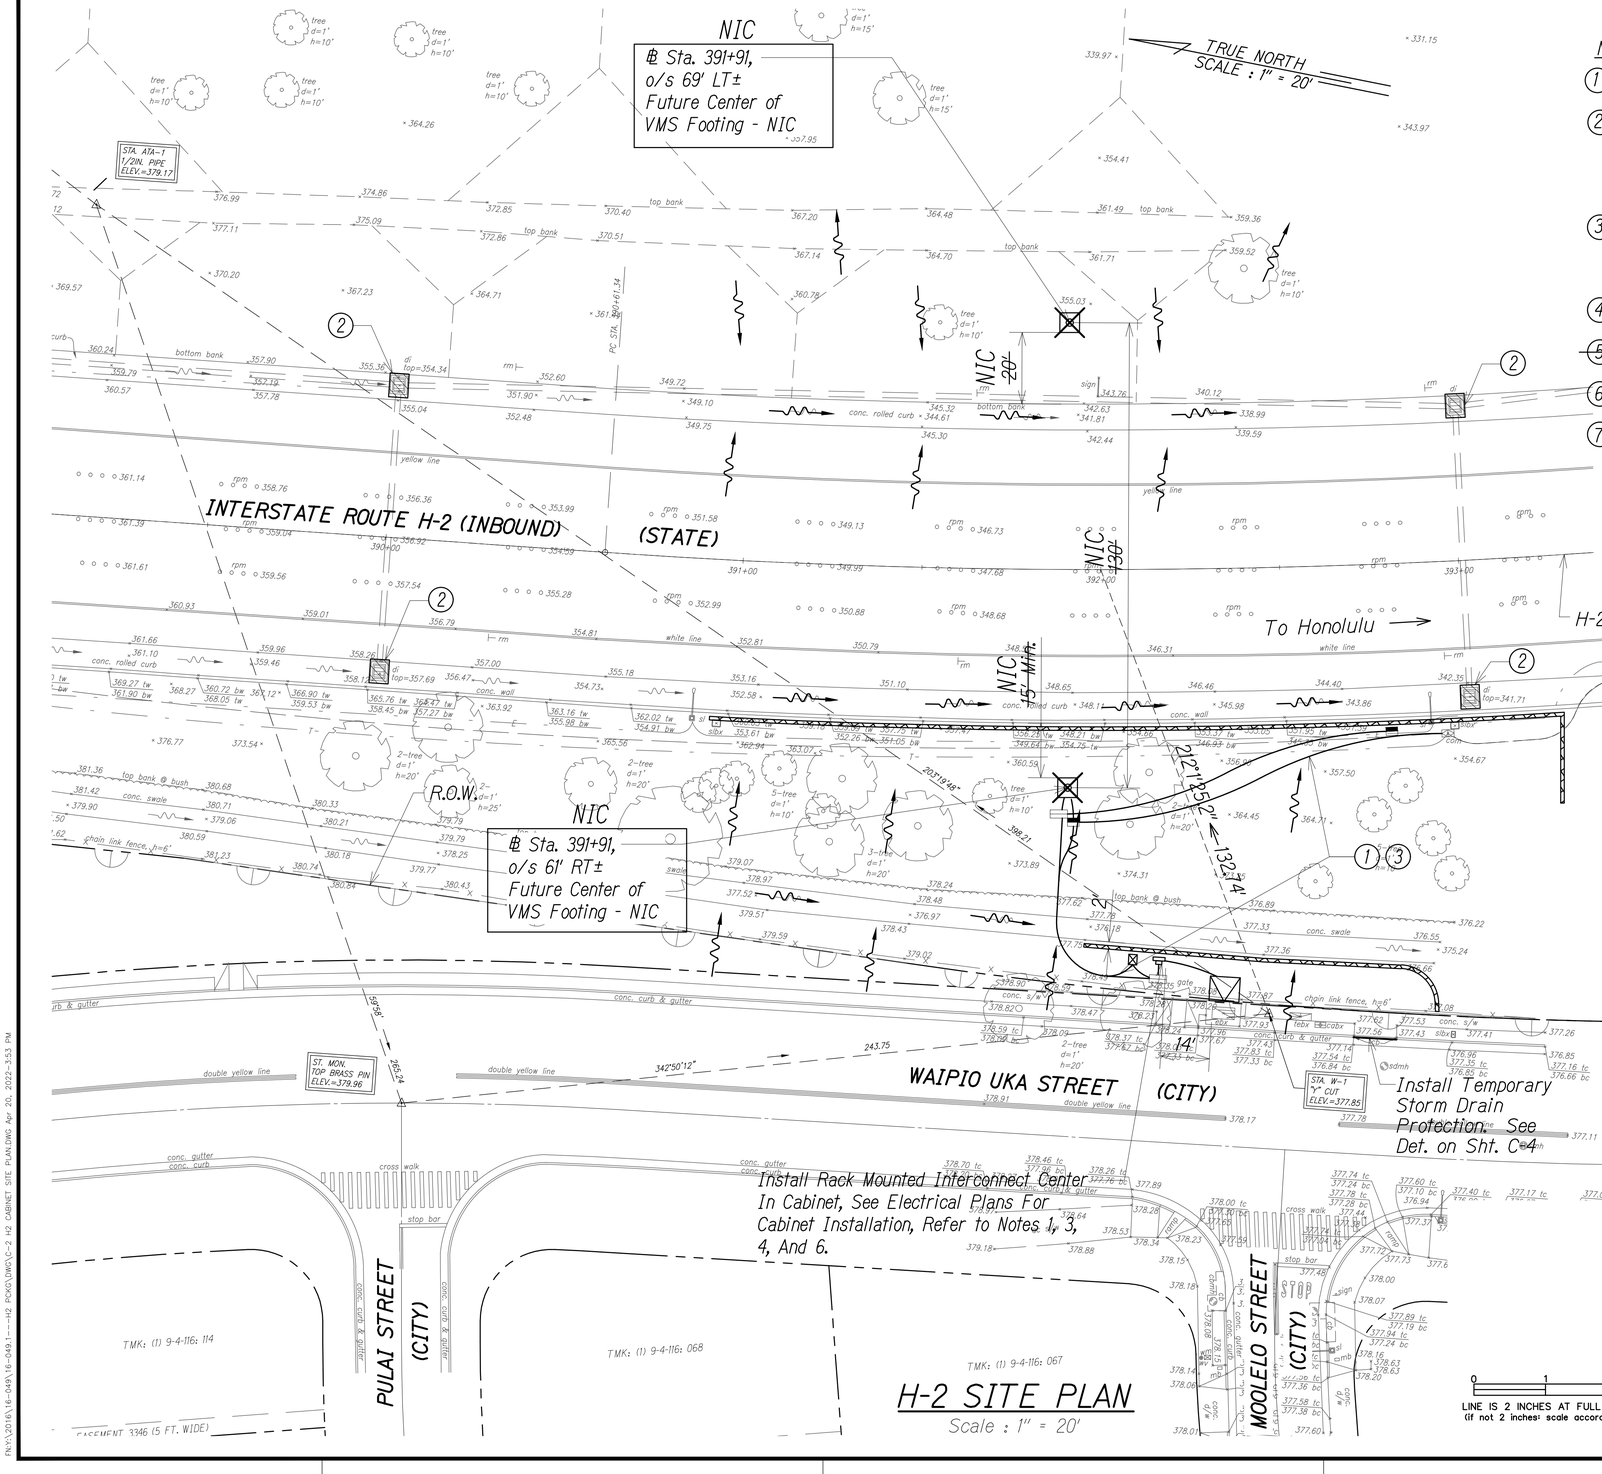

Notes:

1. *See Electrical Plans for electrical and communication service connections.*
2. *Exist. storm drain inlet or catch basin. Contractor to observe Best Management Practices and take measures required. Protect exist. storm drain inlets and catch basins located downstream of the project site with Best Management Practices. See details on Sheet C-4.*
3. *Exist. grassed area or landscaping, clear and grub as required, Contractor to observe Best Management Practices. See detail on Sheet C-4.*
4. *Avoid exist. irrigation systems.*
5. ~~*See Structural Plans for details*~~ NIC
6. *Contractor to verify existing topography elevations prior to construction.*
7. *Sediment and Erosion Control BMP measures shown in the Contract Documents are minimum BMPs requirements and do not constitute an acceptable and/or complete Sediment Control Plan. The Contractor shall incorporate additional BMPs based upon their means and methods considering site conditions and construction sequence in accordance with the Contract Documents including applicable permit documents requirements. Cost shall be included in Pay Item 209.0100, Installation, Maintenance, Monitoring, and Removal of BMP.*

LEGEND:

- *Temporary Fiber Roll*
- *Temporary Drain Inlet Protection*
- *Flow Direction*

LINE IS 2 INCHES AT FULL SIZE (if not 2 inches: scale accordingly)

0 1 2

TERRANCE S. ARASHIRO
LICENSED PROFESSIONAL ENGINEER
No. 6998-C
HAWAI'I, U.S.A.

THIS WORK WAS PREPARED BY ME OR UNDER MY SUPERVISION AND CONSTRUCTION OF THIS PROJECT WILL BE UNDER MY OBSERVATION AS DEFINED IN HAR TITLE 16, CHAPTER 115, RULES OF THE BOARD OF PROFESSIONAL ENGINEERS, ARCHITECTS AND SURVEYORS. STATE OF HAWAII

APRIL 30, 2024
LIC. EXP. DATE

STATE OF HAWAII
DEPARTMENT OF TRANSPORTATION
HIGHWAYS DIVISION

H-2 CABINET SITE PLAN

FREEWAY MANAGEMENT SYSTEM
Phase 3A
Federal Aid Project No. NH-0300(175)

Scale: As Shown Date: October 15, 2021

SHEET No. C-2 OF 4 SHEETS

ORIGINAL PLAN	SURVEY PLOTTED BY	DATE
	DRAWN BY	
NOTE BOOK	TRACED BY	
	DESIGNED BY	
No.	QUANTITIES BY	
	CHECKED BY	

P:\PW\2016\16-049\16-049.1---H2 PCKG\DWG\C-2 H2 CABINET SITE PLAN.DWG Apr 20, 2022--3:53 PM