FED. ROAD DIST. NO.	STATE	FED. AID PROJ. NO.	FISCAL YEAR	SHEET NO.	TOTAL SHEETS
HAWAII	HAW.	CMAQ-0300(96)	2004	1	153

AUG. 2004

80

99

7012

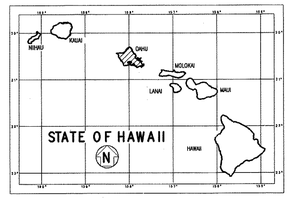

STATE OF HAWAII
DEPARTMENT OF TRANSPORTATION
HIGHWAYS DIVISION
HONOLULU, HAWAII

"AS BUILT"

PLANS FOR

PEDESTRIAN FACILITIES AND ADA COMPLIANCE
AT VARIOUS LOCATIONS ON OAHU, UNIT 5
FEDERAL AID PROJECT NO. CMAQ-0300(96)

DISTRICTS OF WAHIAWA AND EWA
ISLAND OF OAHU

INDEX TO DRAWINGS

SHEET NO.	DESCRIPTION
1	TITLE SHEET
2 – 3	DETAILED INDEX
4	STANDARD PLANS SUMMARY
5 – 14	NOTES
15 – 18	LOCATION MAPS
19 – 31	DETAILS
32 – 117	CIVIL PLANS ① ② ③ ④ ⑤ ⑥ ⑦ ⑧ ⑨ ⑩
118 – 123	TYPICAL TRAFFIC CONTROL PLANS
124 – 153	ELECTRICAL PLANS ⑪ ⑫ ⑬ ⑭ ⑮

Plan Sheet Nos. ① C.0.35, ② C.0.36, ③ ADD.38, ④ C.0.52, ⑤ C.0.80, ⑥ C.0.81, ⑦ C.0.84, ⑧ C.0.85, ⑨ ADD.85, ⑩ ADD.90, ⑪ ADD.138, ⑫ ADD.145, ⑬ ADD.146; ⑭ ADD.153 S-1 and ⑮ ADD.153 S-2 are supplementary sheets to this project, added during Addendum & "As-Built" posting.

TOTAL SHEET COUNT after Addendum & "As-Built" posting is 168 sheets.

PROJECTS SITES

① Kamehameha Hwy. (Route 99)
Mile Post 21.36 TO Mile Post 11.70

② Kamehameha Hwy. (Route 80)
Mile Post 0.11 TO Mile Post 0.47

③ Kamehameha Hwy., Wilikina Dr., and Farrrington Hwy. (Route 99)
Mile Post 8.36 TO Mile Post 9.80

④ Whitmore Ave. (Route 7012)
Mile Post 0.52 TO Mile Post 0.62

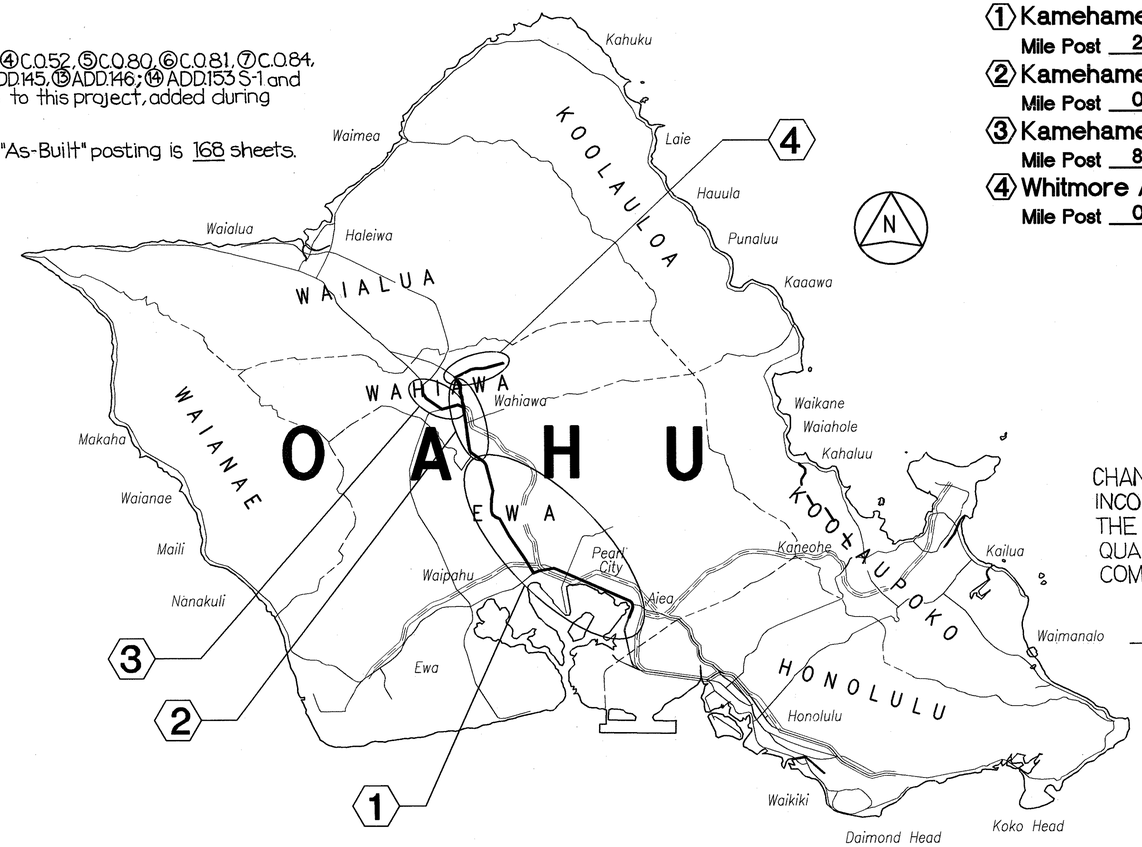

FEDERAL AID INTERSTATE PROJECTS PREVIOUSLY CONSTRUCTED OR UNDER CONSTRUCTION

CHANGES MADE DURING CONSTRUCTION HAVE BEEN INCORPORATED ON THESE PLANS EXCEPT CHANGES IN THE ORIGINAL THEORETICAL QUANTITIES. FOR ACTUAL QUANTITIES, REFER TO PROJECT LEDGER AND/OR COMPUTATION BOOK.

Marvin C. H. Lindfield
RESIDENT ENGINEER

12-06-2007
DATE

DEPARTMENT OF TRANSPORTATION
STATE OF HAWAII
APPROVED:
for DIR. OF TRANSPORTATION — 7-30-04 DATE

"AS-BUILT"

R.M. TOWILL CORPORATION — DESIGNED BY
HWY-DS — MANAGED BY
692-7545 — PHONE
JULY 2004 — DATE

ORIGINAL PLAN | SURVEY PLOTTED BY | DRAWN BY | TRACED BY | DESIGNED BY | QUANTITIES BY | CHECKED BY | DATE
NOTE BOOK No.

RMTC JOB NO.: 1-19992-0E