FED. ROAD DIST. NO.	STATE	PROJ. NO.	FISCAL YEAR	SHEET NO.	TOTAL SHEETS
HAWAII	HAW.	HWY-O-03-08M	2008	1	13

INDEX TO DRAWINGS

SHEET NO.	DESCRIPTION
1	TITLE SHEET
2	STANDARD PLANS SUMMARY
3	GENERAL NOTES AND LEGEND
4 – 5	WATER POLLUTION AND EROSION CONTROL NOTES
6 – 8	TYPICAL SECTIONS
9 – 10	ROADWAY PLANS
11	PAVEMENT MARKING LEGEND, DETAILS AND NOTES
12 – 13	PAVEMENT MARKING AND STRIPING PLAN

STATE OF HAWAII

DEPARTMENT OF TRANSPORTATION

HIGHWAYS DIVISION

HONOLULU, HAWAII

"AS-BUILT"

PLANS FOR

PAVEMENT PREVENTIVE MAINTENANCE

AT KAMEHAMEHA HIGHWAY, H-2 OVERPASS TO KARSTEN THOT BRIDGE

PROJECT NO. HWY-O-03-08M

DISTRICT OF WAHIAWA
ISLAND OF OAHU

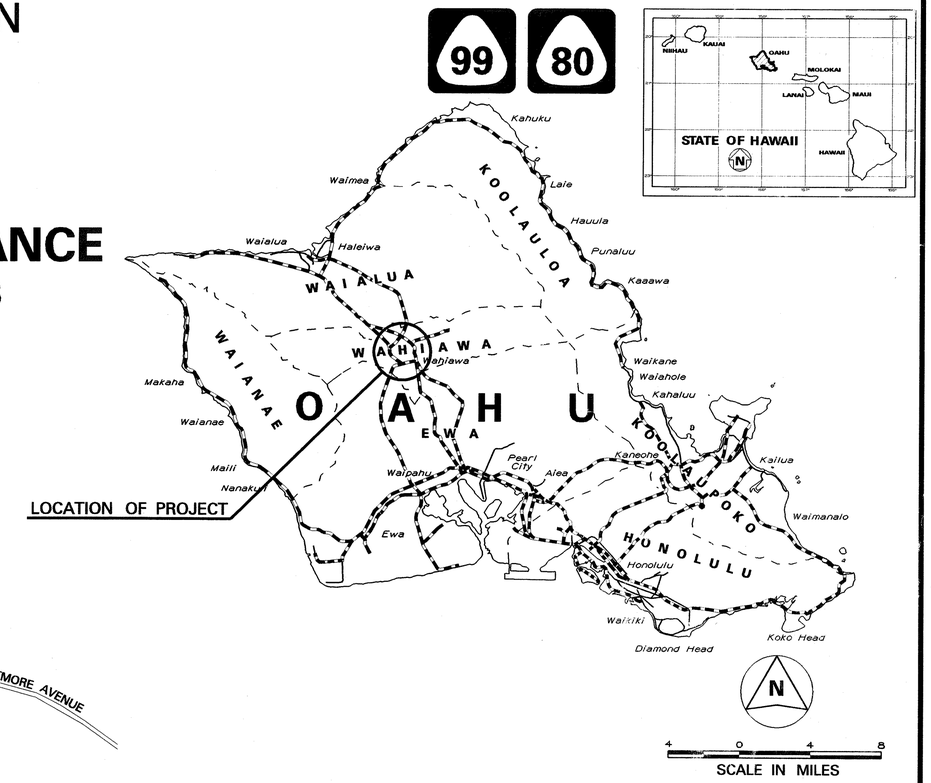

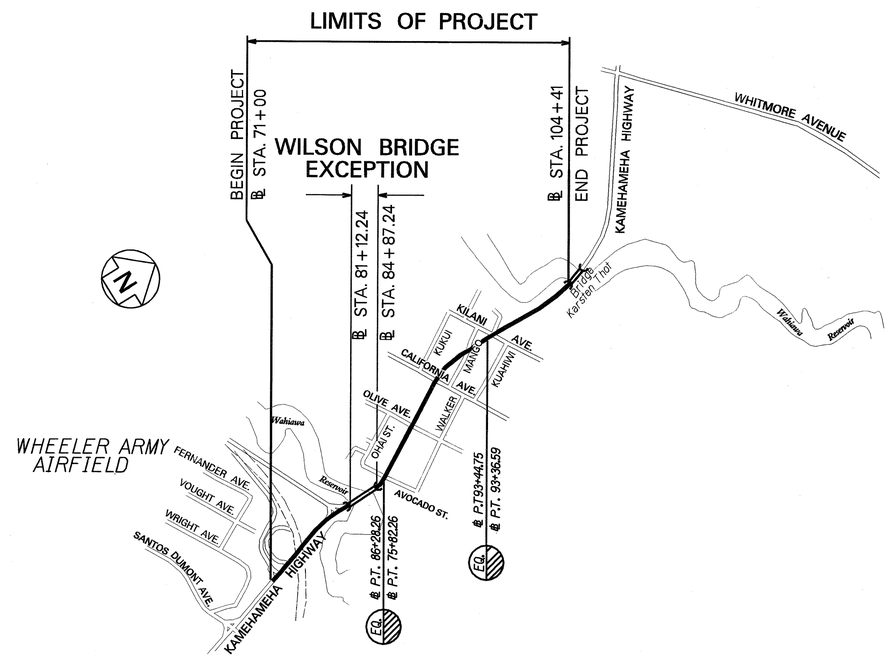

LAYOUT PLAN

LENGTH OF PROJECT. . . . . 0.81 MILE

5 0 5 10 15
SCALE IN HUNDRED FEET

FEDERAL AID PROJECTS PREVIOUSLY CONSTRUCTED OR UNDER CONSTRUCTION

KAMEHAMEHA HIGHWAY
ROUTE 99: MILE POST 9.85 TO MILE POST 9.69
ROUTE 80: MILE POST 0.00 TO MILE POST 0.65

CHANGES MADE DURING CONSTRUCTION HAVE BEEN INCORPORATED ON THESE PLANS EXCEPT CHANGES IN THE ORIGINAL THEORETICAL QUANTITIES. FOR ACTUAL QUANTITIES, REFER TO PROJECT LEDGER AND/OR COMPUTATION BOOK.

RESIDENT ENGINEER 7/23/09 DATE

DEPARTMENT OF TRANSPORTATION
STATE OF HAWAII
APPROVED:
for 2-12-08
DIR. OF TRANSPORTATION DATE

HWY-DD DESIGNED BY | HWY-DD MANAGED BY | 692-7570 PHONE | FEB., 2008 DATE