FED. ROAD DIST. NO.	STATE	PROJ. NO.	FISCAL YEAR	SHEET NO.	TOTAL SHEETS
HAWAII	HAW.	7521A-01-92	1992	1	4

INDEX TO DRAWINGS	
SHEET NO.	DESCRIPTION
1	TITLE SHEET
2	STANDARD PLANS SUMMARY
3	TYPICAL SECTIONS, GENERAL NOTES AND LEGEND
4	ROADWAY PLAN

STATE OF HAWAII

DEPARTMENT OF TRANSPORTATION

HIGHWAYS DIVISION

HONOLULU, HAWAII

"AS-BUILT"

PLANS FOR

PAUOA ROAD

PEDESTRIAN SAFETY IMPROVEMENTS

PROJECT NO. 7521A-01-92

DISTRICT OF HONOLULU

ISLAND OF OAHU

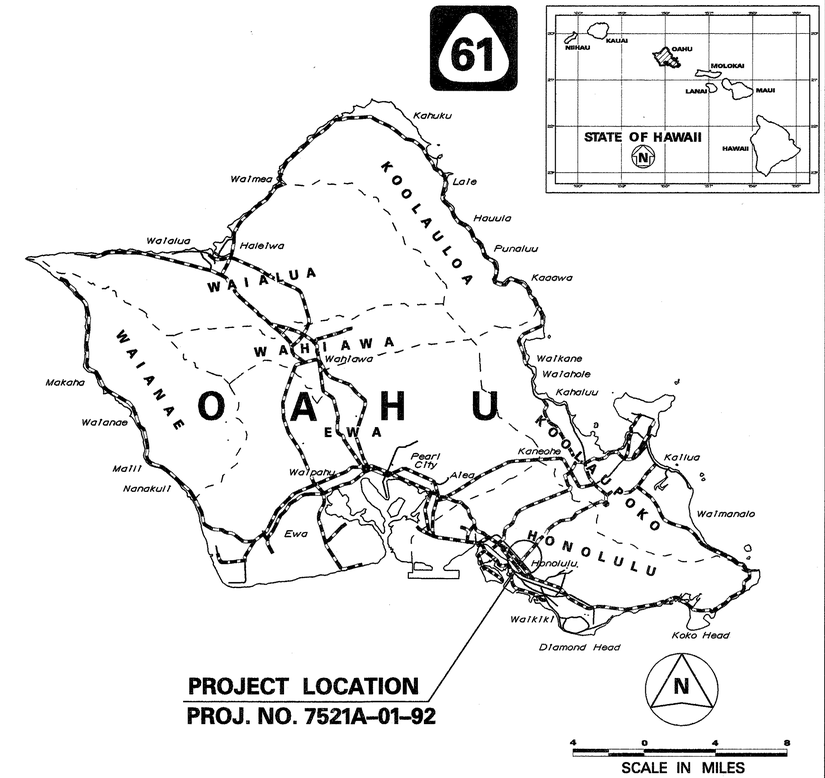

PROJECT LOCATION
PROJ. NO. 7521A-01-92

FEDERAL AID PROJECTS PREVIOUSLY CONSTRUCTED OR UNDER CONSTRUCTION

MILE POST _____ TO MILE POST _____

CHANGES MADE DURING CONSTRUCTION HAVE BEEN INCORPORATED ON THESE PLANS EXCEPT CHANGES IN THE ORIGINAL THEORETICAL QUANTITIES. FOR ACTUAL QUANTITIES, REFER TO PROJECT LEDGER AND/OR COMPUTATION BOOK.

RESIDENT ENGINEER — DATE 3/23/99

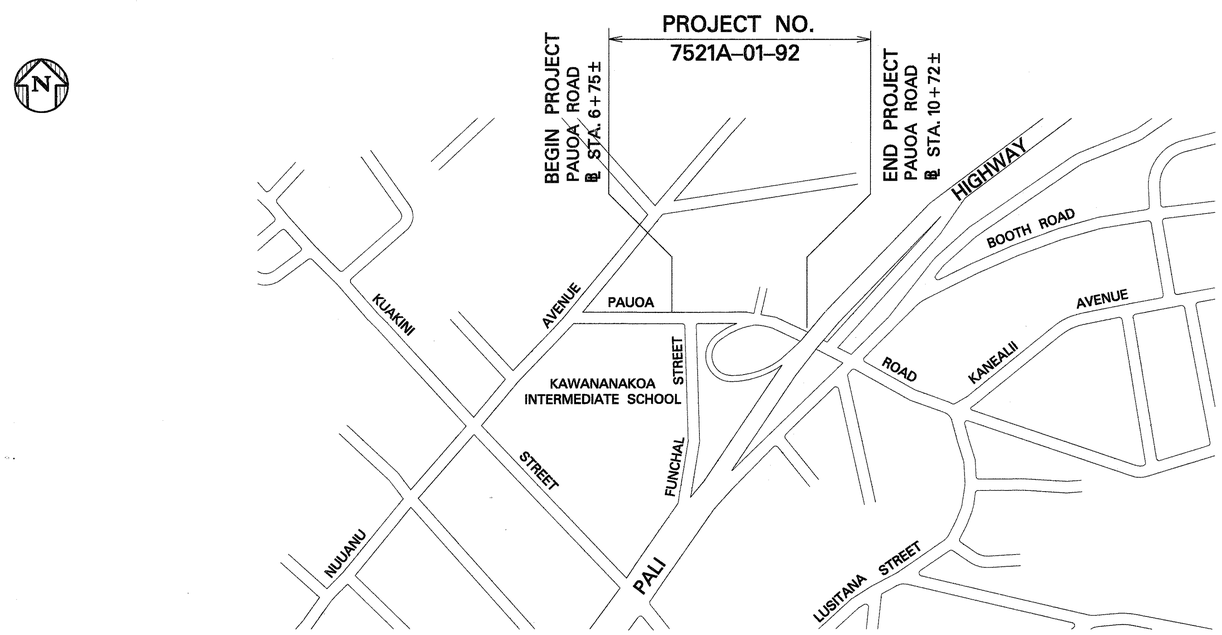

PROJECT LOCATION

1 0 1 2
SCALE IN FIVE HUNDRED FEET

LENGTH OF PROJECT .... 0.075 MI.

HWY-T	R. TAKAESU	587-2249	MAR., 1992
DESIGNED BY	P. S. & E. BY HWY-DD	PHONE	DATE

DEPARTMENT OF TRANSPORTATION STATE OF HAWAII	
APPROVED:	
DIR. OF TRANSPORTATION	DATE 5/14/92

1mlsdtstt.dgn 5/5/92