FED. ROAD DIST. NO.	STATE	FED. AID PROJ. NO.	FISCAL YEAR	SHEET NO.	TOTAL SHEETS
HAWAII	HAW	S-0610(1)	1955	1	84

TERRITORY OF HAWAII
TERRITORIAL HIGHWAY DEPARTMENT
HONOLULU, OAHU, T. H.

PLANS OF
PALI ROAD
PORTAL 4 TO HAIRPIN TURN
FEDERAL AID SECONDARY PROJECT NO. S-0610(1)

DISTRICT OF KOOLAUPOKO

ISLAND OF OAHU

INDEX TO DRAWINGS

SHEET NO.	DESCRIPTION
1	TITLE SHEET
2	TYPICAL SECTIONS
3	TYPICAL SECTIONS AND MISCELLANEOUS DETAILS
4-6	PLAN & PROFILE
7	SOIL PROFILE
8-8A	HIGHWAY LIGHTING AND TRAFFIC SIGNAL SYSTEMS
9-14	STANDARD DETAILS
15-27	BRIDGE NO. 4
28-39	BRIDGE NO. 5
40-45	BRIDGE NO. 6
46-55	BRIDGE NO. 7
56-66	BRIDGE NO. 8

SHEET NO.	DESCRIPTION
67	STANDARD BRIDGE DETAILS
68-84	CROSS SECTIONS

CONVENTIONAL SIGNS

Centerline
Boundary Lines, or
Fences (Named)
Existing Roadways
Circular Culvert
Box Culvert
Bridge
Telephone Pole
Electric Power Pole
Water Main (W4, 8, 12, Etc.)
Storm Drain (SD18, 24, Etc.)
Concrete Drop Intake
Standard Catch Basin
Standard Manhole
Sewer Manhole
Telephone Manhole
Fire Hydrant
Tree (Large, named) Mango Coco
Railroad
Haw'n Telephone Underground Cable HTC
Water Meter WM

SCALES

PLAN		1 IN. =	50 FT.
PROFILE	HOR.	1 IN. =	50 FT.
	VERT.	1 IN. =	20 FT.
CROSS SECTION	HOR.	1 IN. =	10 FT.
	VERT.	1 IN. =	10 FT.

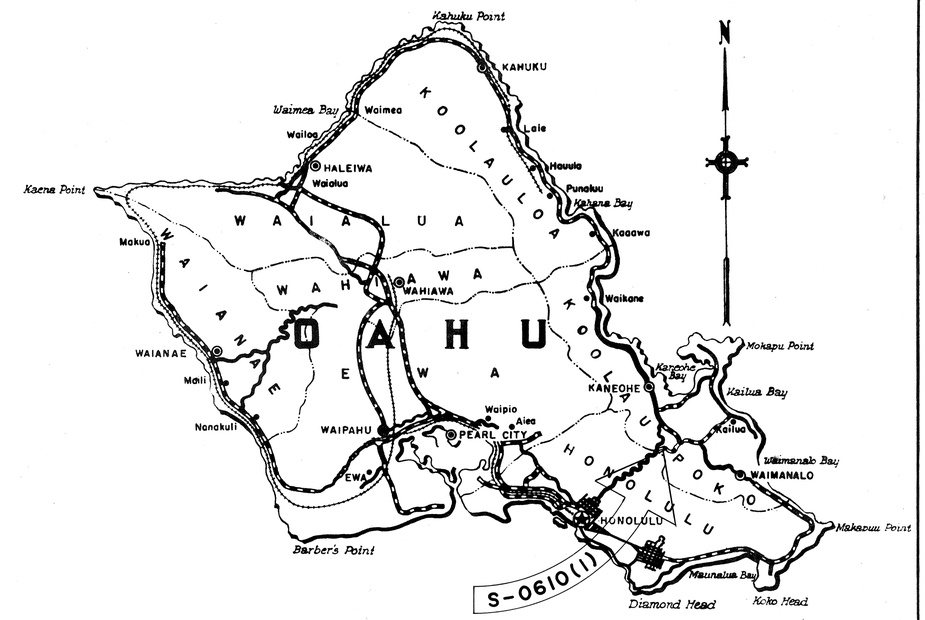

Federal Aid Projects Previously Constructed Or Under Construction

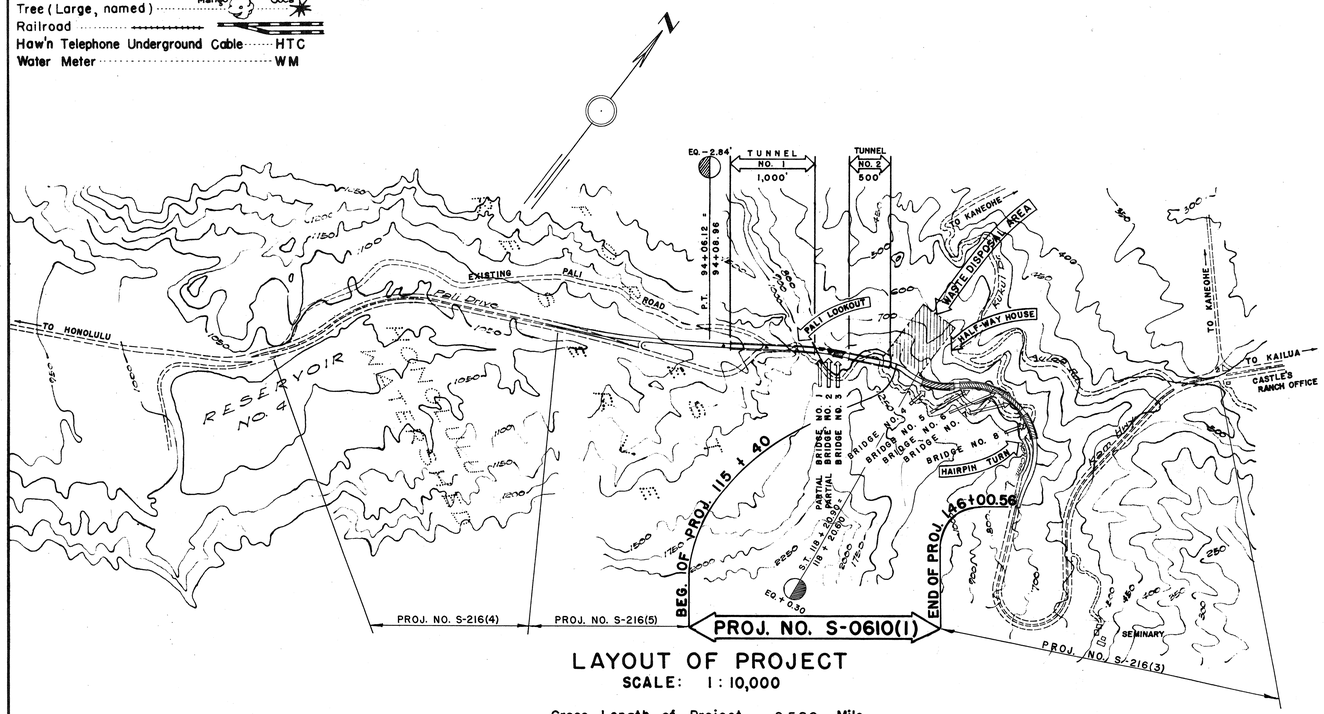

LAYOUT OF PROJECT
SCALE: 1 : 10,000

Gross Length of Project	0.580	Mile
Bridges Over 20' 0" Span	0.303	Mile
Net Length of Roadway	0.277	Mile

AS BUILT PLANS

ALL CHANGES MADE DURING CONSTRUCTION HAVE BEEN NOTED IN RED ON THESE TRACINGS AND CHECKED BY:

R. W. Hendry
DISTRICT ENGINEER

May 20, 1959
DATE

ORIGINAL PLAN		DATE
	SURVEY PLOTTED BY	
	DESIGNED BY	
	DRAWN BY	
	TRACED BY	
NOTE BOOK	QUANTITIES CHECKED BY	
	QUANTITIES CHECKED BY	
No.	CHECKED BY	

APPROVED DATE 9-29-55
Ben. E. Nutter
TERRITORIAL HIGHWAY ENGINEER

DEPARTMENT OF COMMERCE
BUREAU OF PUBLIC ROADS
APPROVED:
[redacted]
DISTRICT ENGINEER DATE

5752.1