FED. ROAD DIST. NO.	STATE	FED. AID PROJ. NO.	FISCAL YEAR	SHEET NO.	TOTAL SHEETS
HAWAII	HAW.	BU-061-1(7) UNIT 5	1960	1	176

INDEX TO DRAWINGS	
SHEET NO.	DESCRIPTION
1	TITLE SHEET
2 - 8	TYPICAL SECTIONS
9 - 12	PLAN & PROFILE
13	PROFILE OF RAMPS
14 - 23	DETAIL PLAN OF ROADWAY
24 - 27	STORM DRAIN DETAILS & MISCELLANEOUS DETAILS
28 - 29	AUWAI SIPHON
30 - 35	RETAINING WALLS
36 - 53	UTILITIES
54 - 58	HIGHWAY LIGHTING SYSTEM
59	TRAFFIC SIGNAL SYSTEM
60 - 69	TRAFFIC & DESTINATION SIGNS
70 - 73	LANDSCAPE PLANS
74 - 76	SPRINKLER SYSTEM
77 - 88	STANDARD DETAILS
89 - 138	CROSS SECTIONS
139 - 141	STRUCTURE NO. 7
142 - 147	STRUCTURE NO. 12
148 - 157	STRUCTURE NO. 3
158 - 159	STRUCTURE NO. 8
160 - 167	STRUCTURE NO. 4
168 - 174	STRUCTURE NO. 5
175 - 176	STANDARD BRIDGE DETAILS

STATE OF HAWAII
DEPARTMENT OF TRANSPORTATION
DIVISION OF HIGHWAYS
HONOLULU, HAWAII

AS BUILT
PLANS OF

PALI HIGHWAY

FEDERAL AID PROJECT NO. BU-061-1(7)
UNIT 5
DISTRICT OF HONOLULU
ISLAND OF OAHU

SCALES

Plan ..... 1"=50' & 1"=20'
Profile ..... Horiz. 1"=50'
Profile ..... Vert. 1"=10'
X Section ..... Horiz. 1"=10'
X Section ..... Vert. 1"=10'

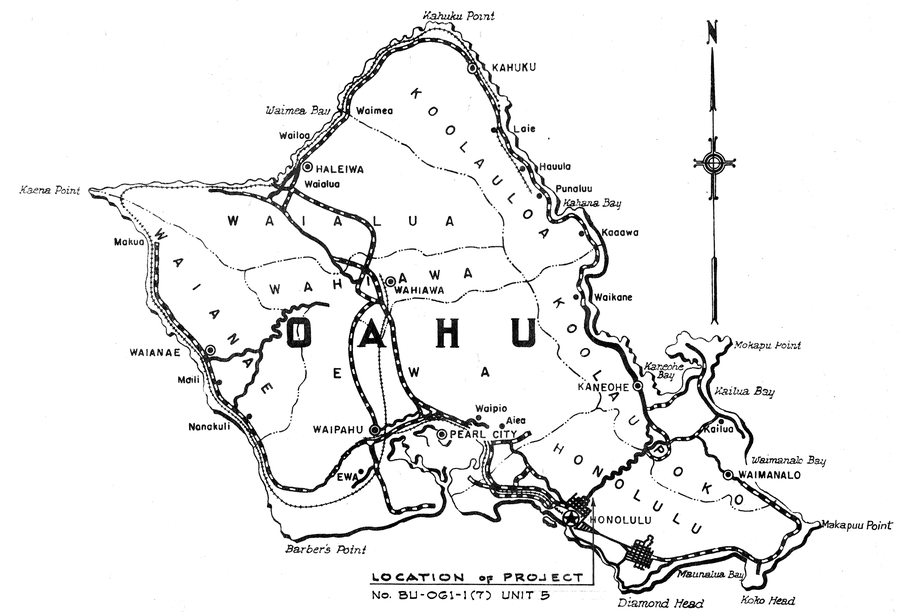

LOCATION OF PROJECT
No. BU-061-1(7) UNIT 5

Federal Aid Projects Previously Constructed Or Under Construction

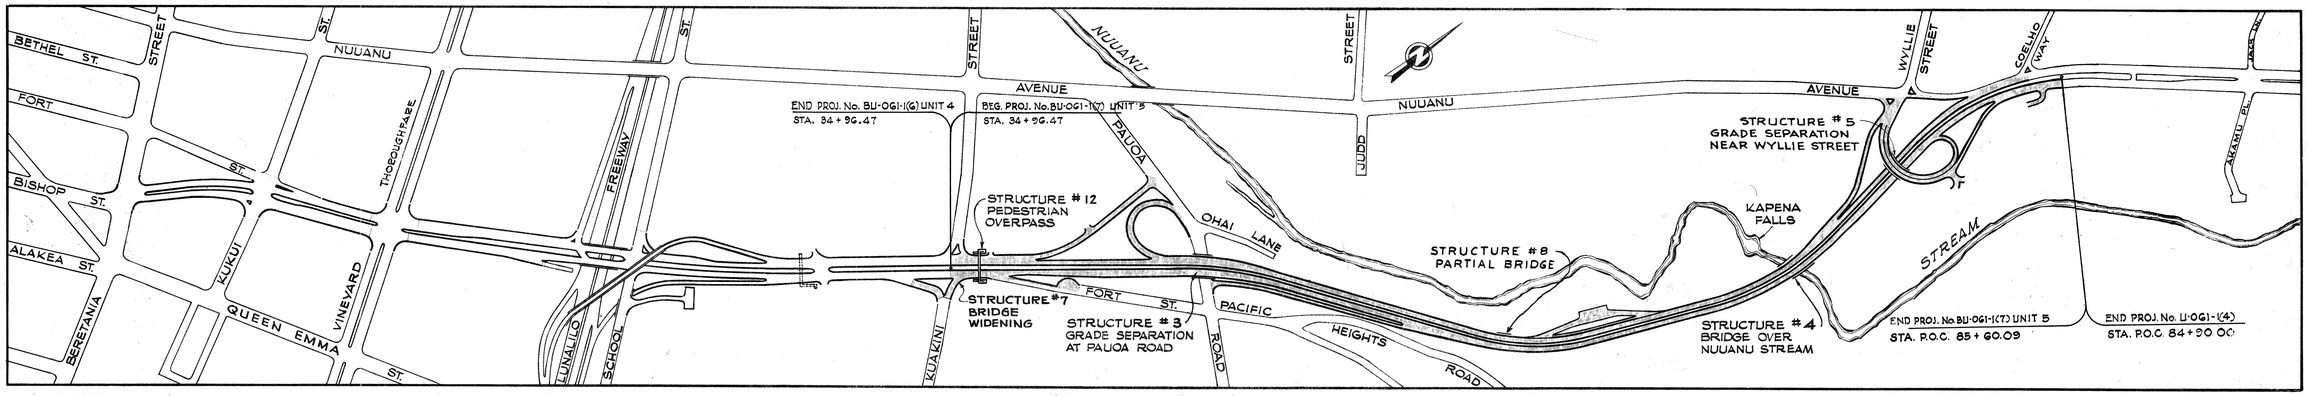

LAYOUT PLAN
SCALE: 1"=300'

GROSS LENGTH OF PROJECT	=	0.959	Mi.
BRIDGE	=	0.030	Mi.
NET LENGTH OF PROJECT	=	0.929	Mi.

NOTE:
ALL CHANGES MADE DURING CONSTRUCTION HAVE BEEN NOTED ON THESE TRACINGS IN RED AND CHECKED BY:

James Sugimura
PROJECT ENGINEER
3/21/74
DATE

APPROVED DATE 5/16/60
DIRECTOR OF TRANSPORTATION

DEPARTMENT OF COMMERCE
BUREAU OF PUBLIC ROADS
APPROVED:
[redacted]
DIVISION ENGINEER DATE

SHEET No. 1 OF 1 SHEETS

ORIGINAL PLAN	SURVEY PLOTTED BY	DATE
	DESIGNED BY	
	DRAWN BY	
NOTE BOOK	TRACED BY	
	QUANTITIES BY	
	QUANTITIES CHECKED BY	
No.	CHECKED BY	

DD-1-2

James B. Wilson 379

B.S147.1