


FED. ROAD DIST. No.	STATE	FED. AID PROJ. No.	FISCAL YEAR	SHEET No.	TOT SHEETS
HAWAII	HAW.	BF-OGI-1(1)	1960	8	24

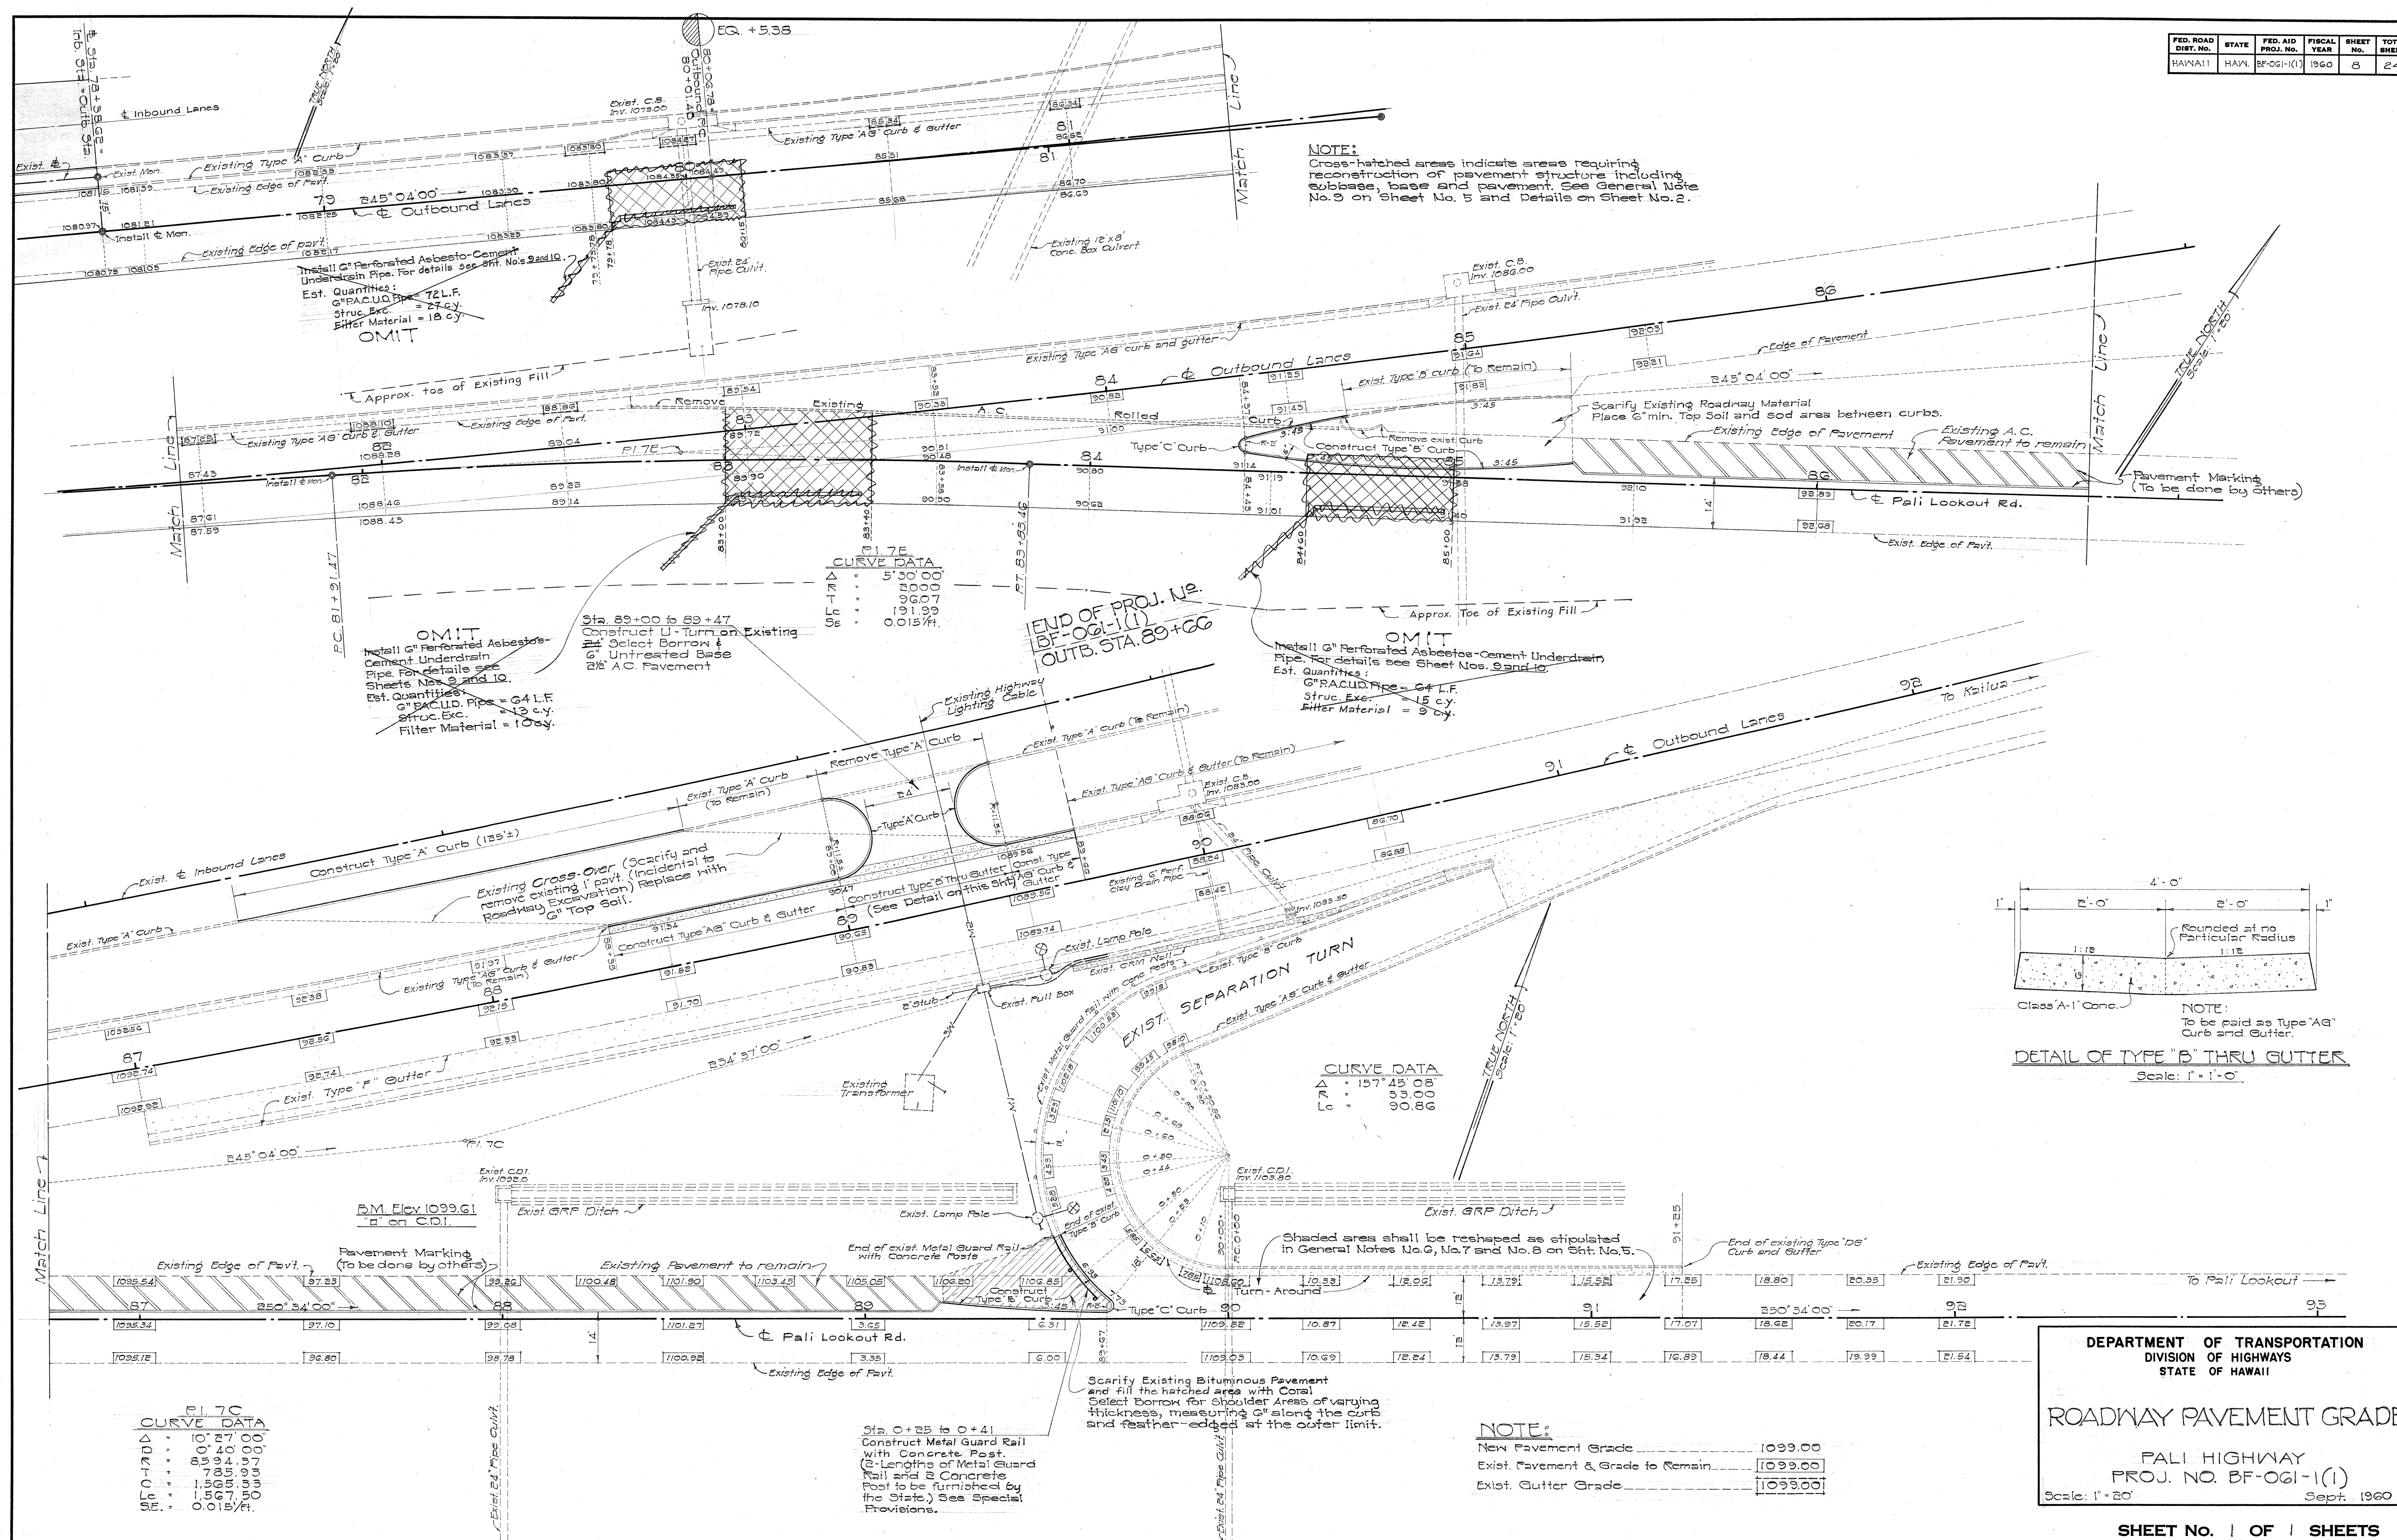

ORIGINAL PLAN	SURVEY PLOTTED BY _____ DATE _____	
NOTE BOOK	DESIGNED BY _____	_____
	DRAWN BY _____	_____
	TRACED BY _____	_____
	QUANTITIES BY _____	_____
No. _____	QUANTITIES CHECKED BY _____	_____
	CHECKED BY _____	_____