
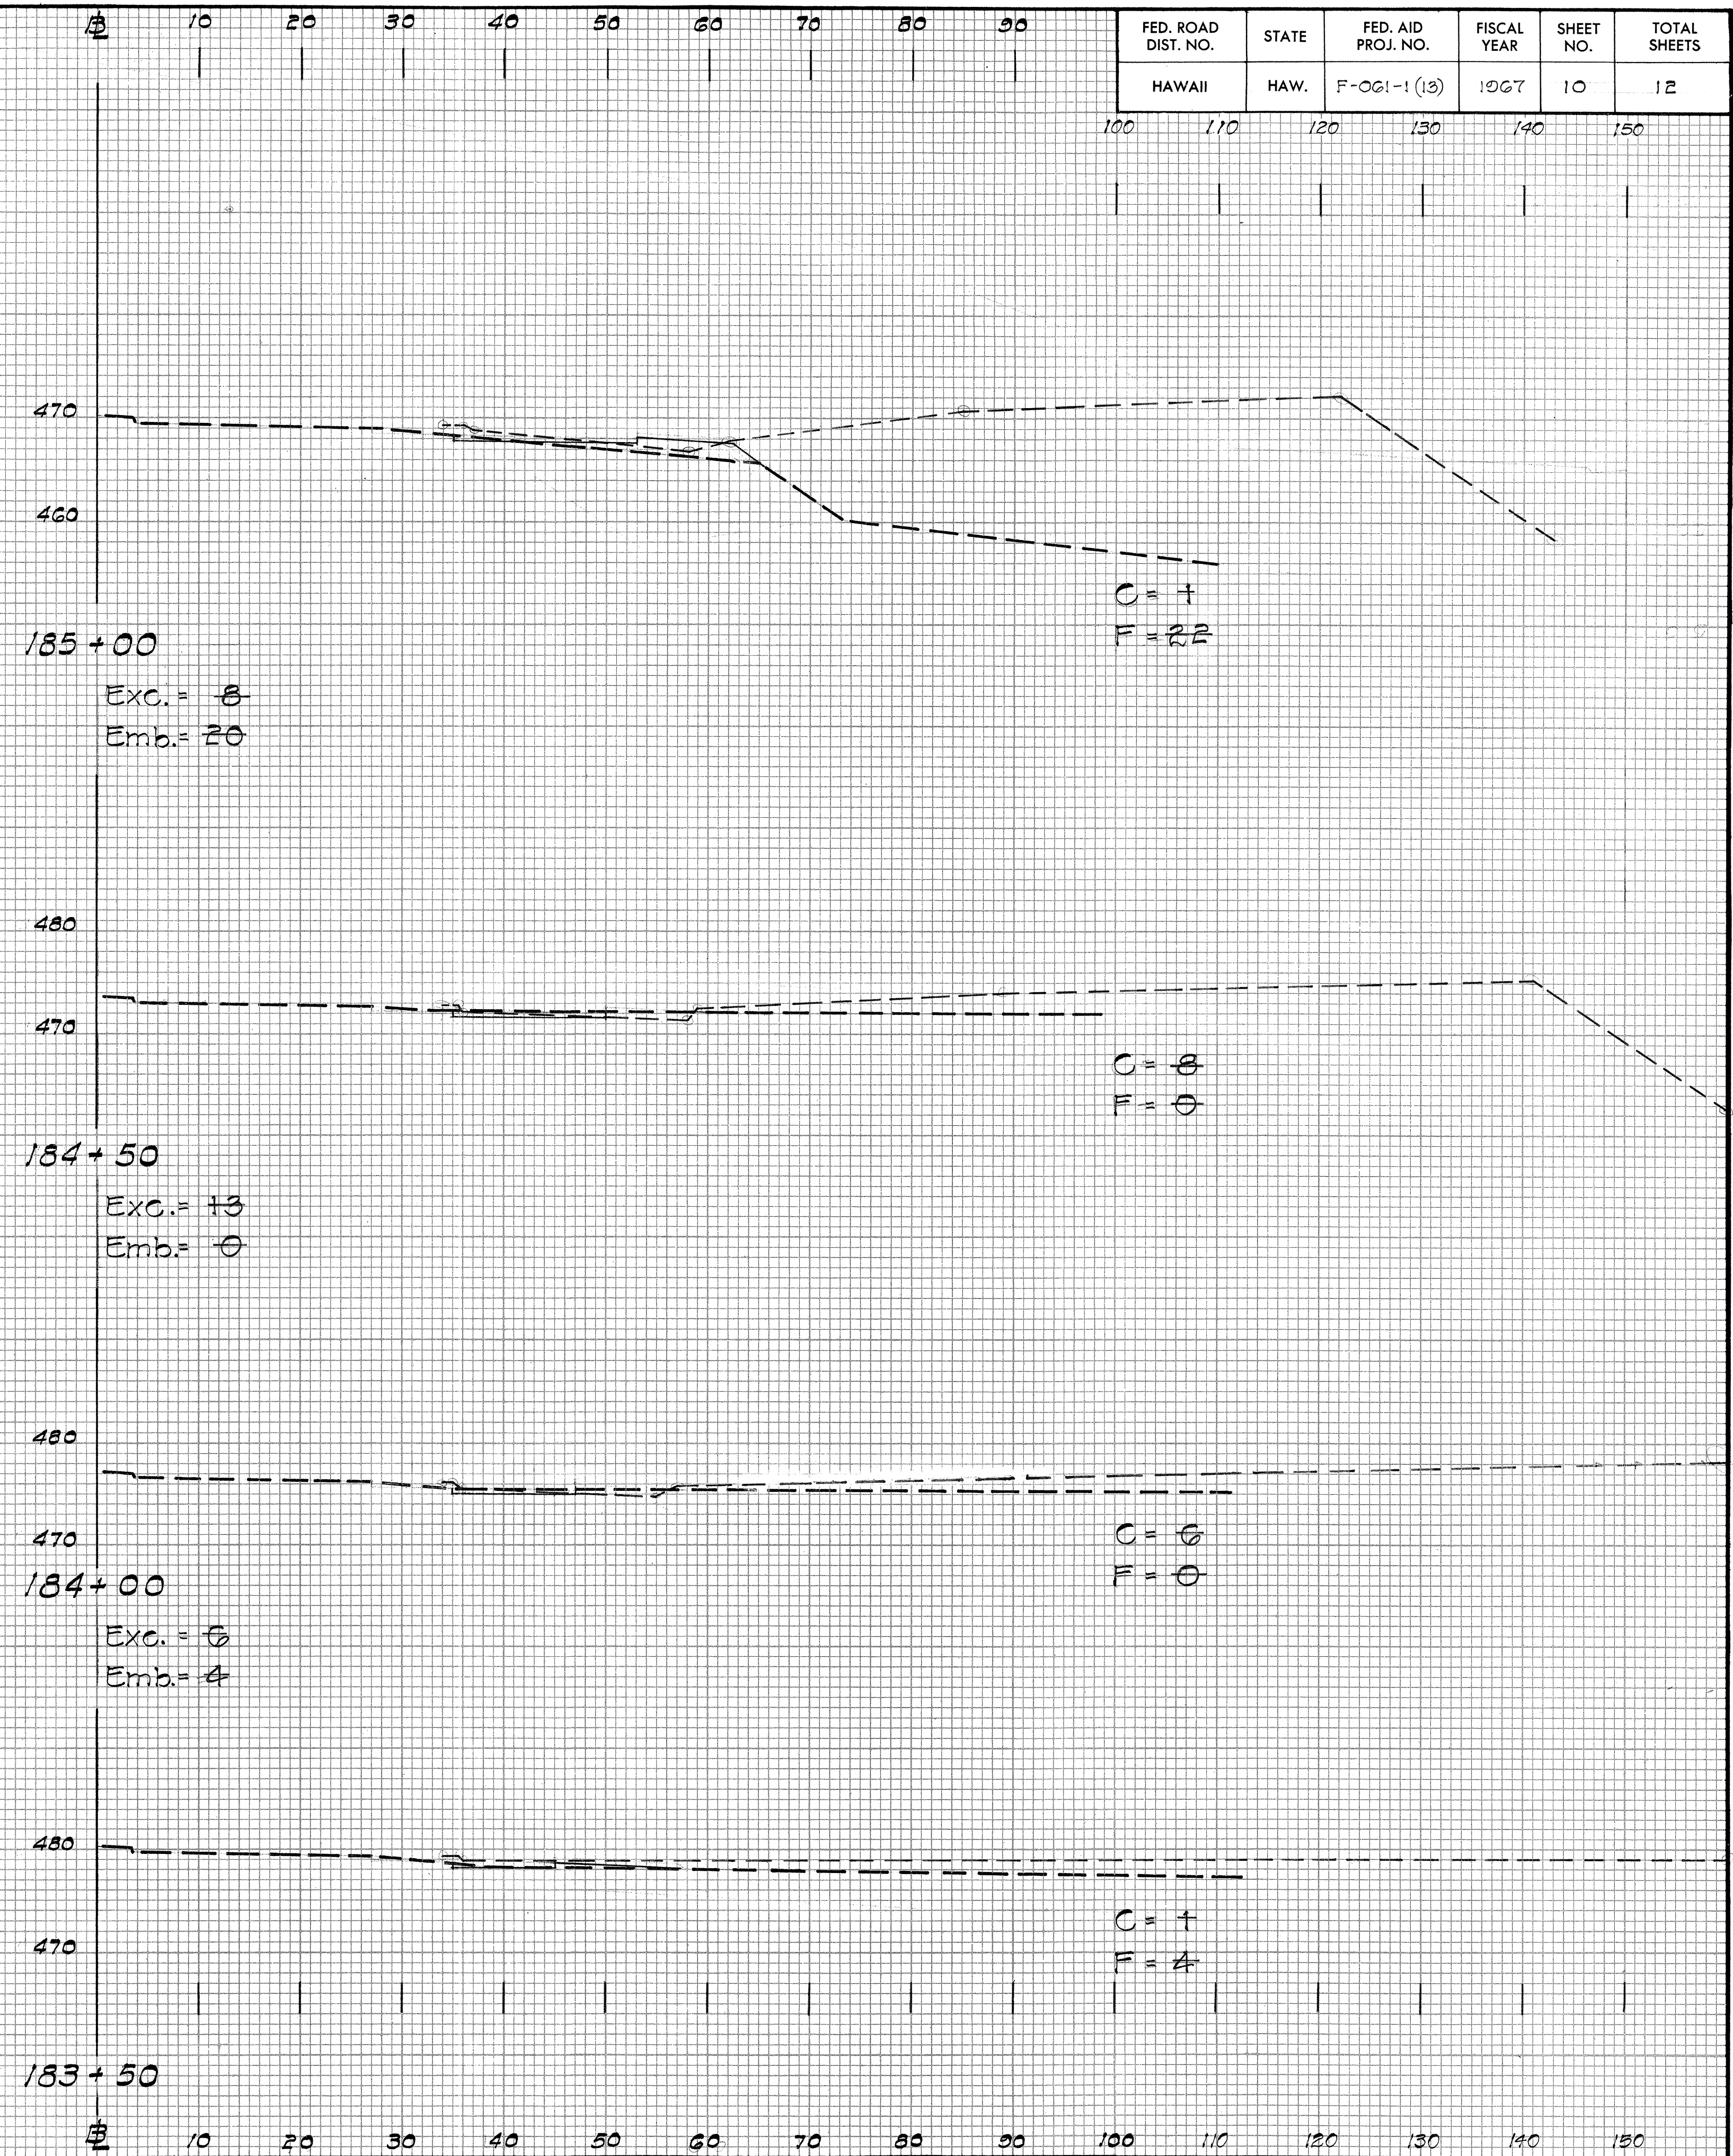


DATE	
BY	
FINAL SURVEY	
SURVEYED	
PLOTTED	
NOTE BOOK	
NO.	

DATE	
BY	
ORIGINAL SURVEY	
SURVEYED	
PLOTTED	
NOTE BOOK	
NO.	

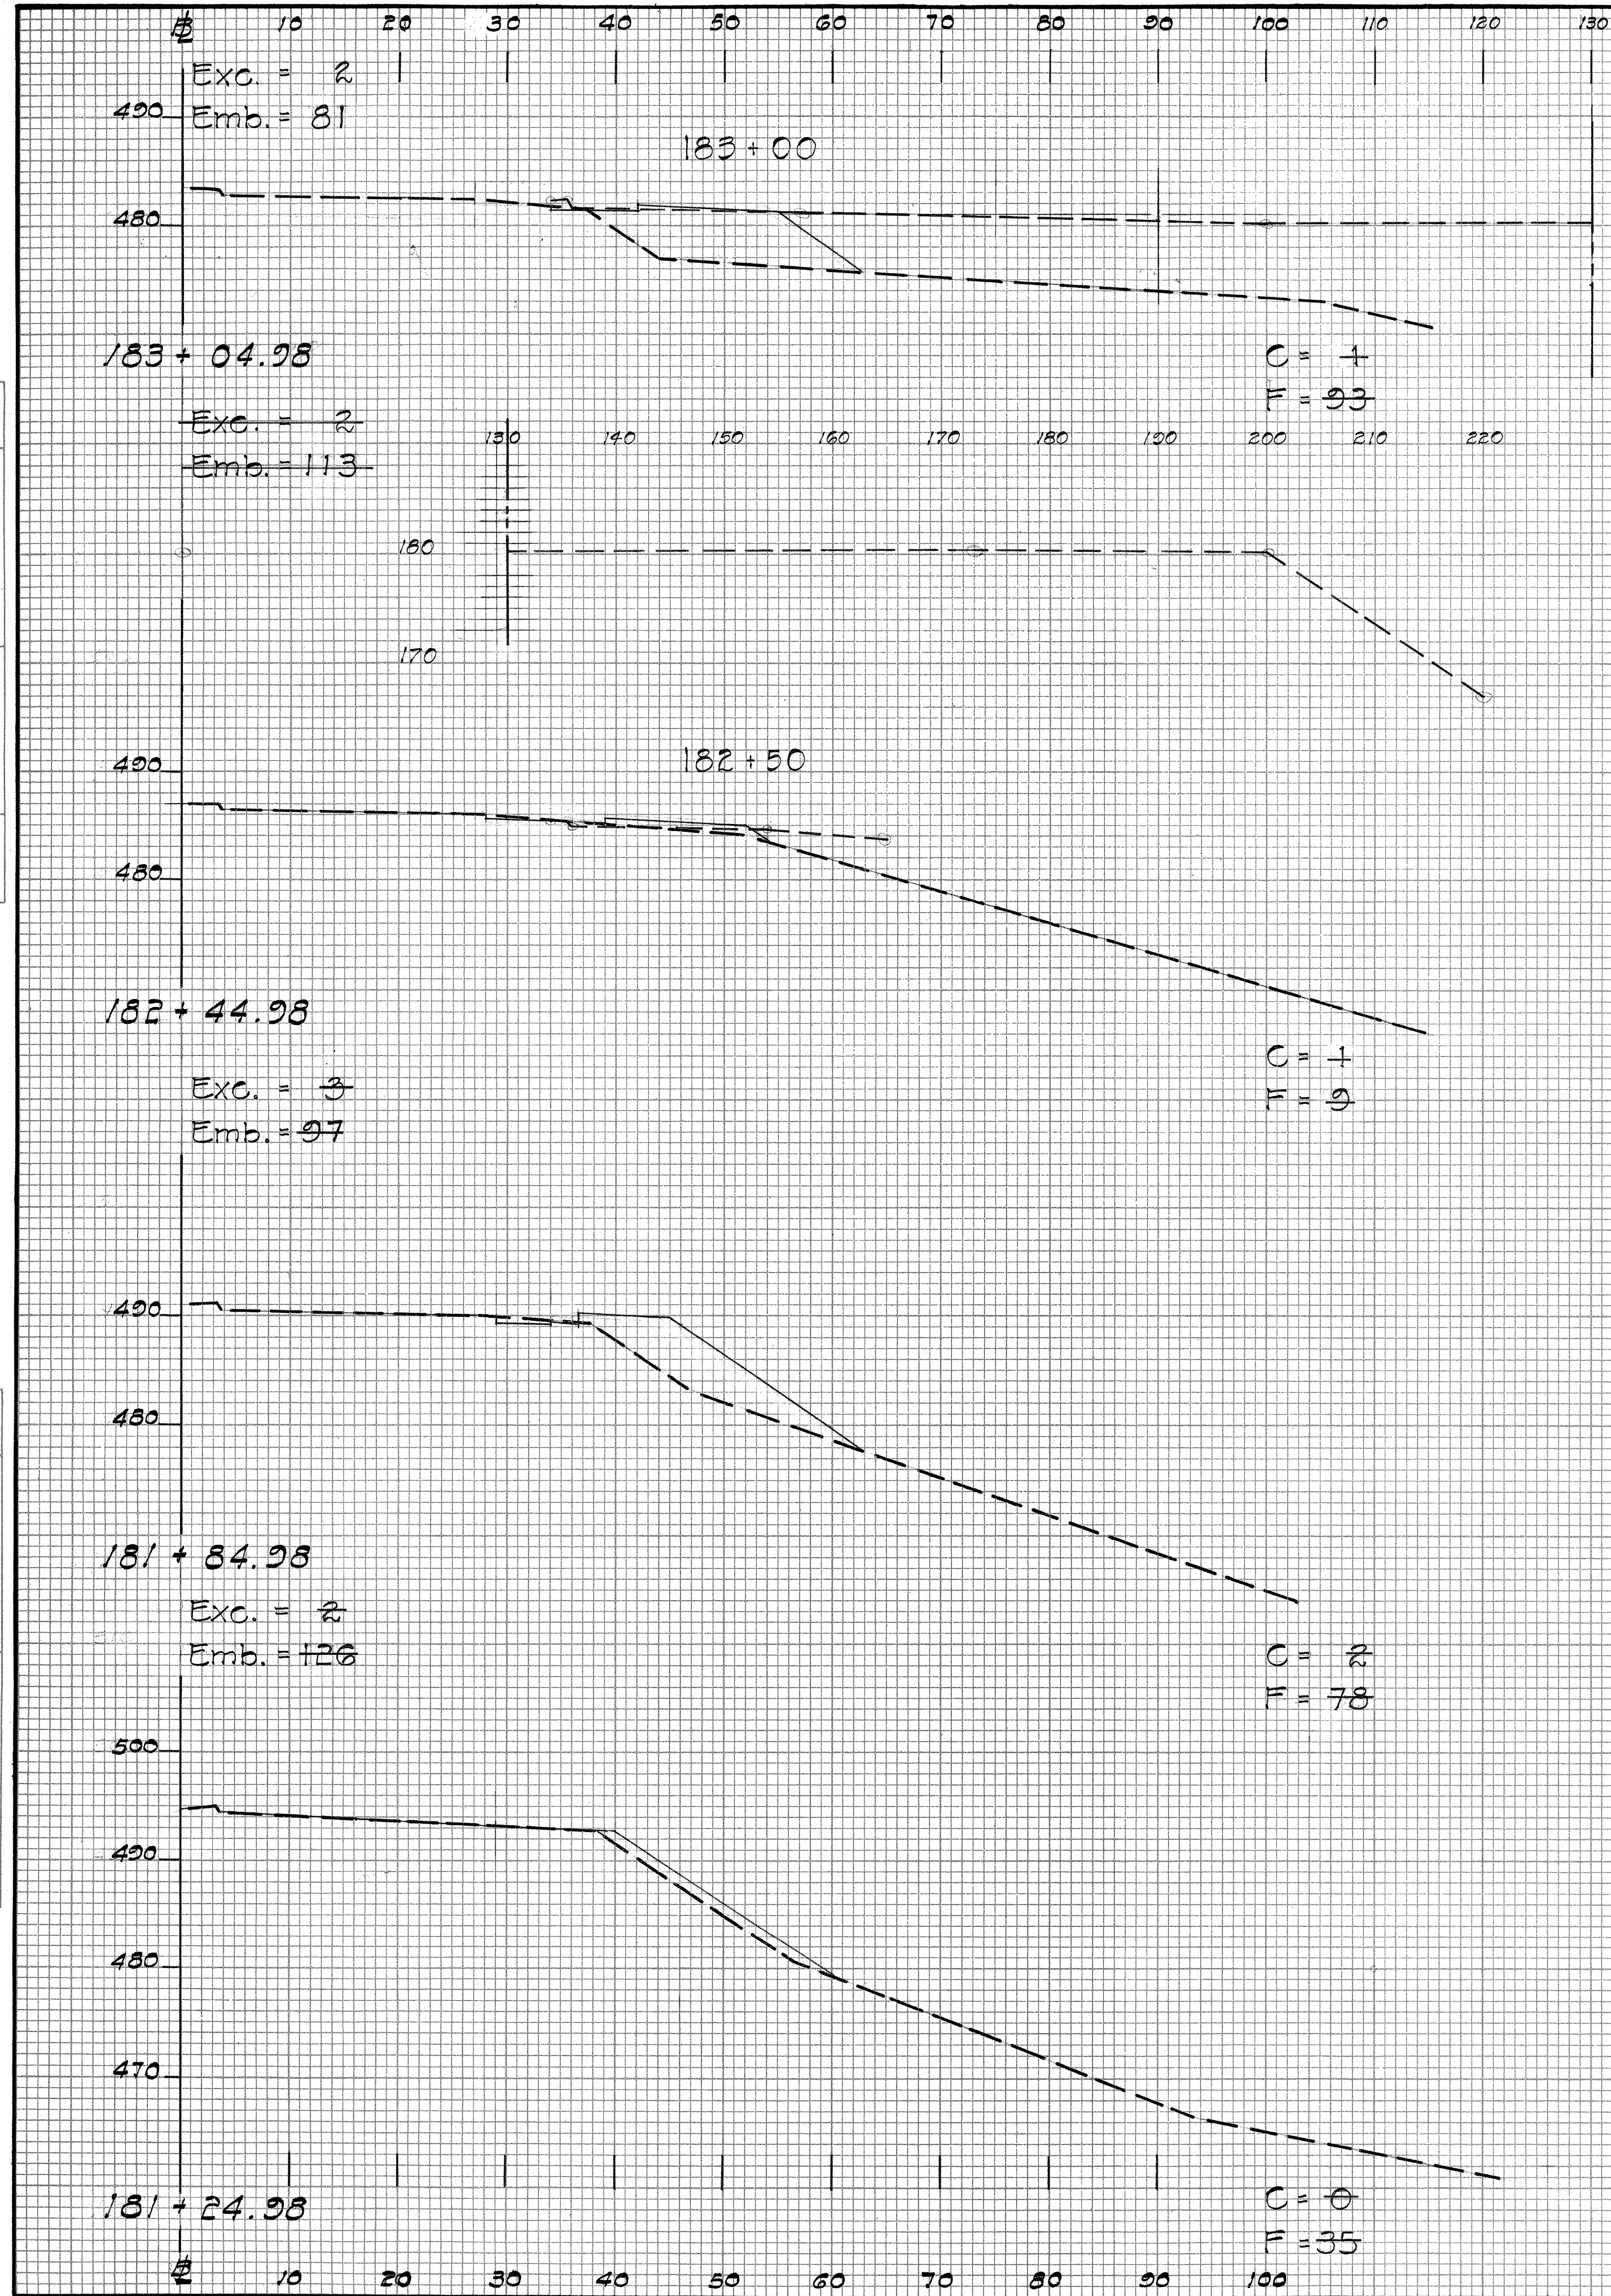


FED. ROAD DIST. NO.	STATE	FED. AID PROJ. NO.	FISCAL YEAR	SHEET NO.	TOTAL SHEETS
HAWAII	HAW.	F-061-1(13)	1967	10	12

FED. ROAD DIST. NO.	STATE	FED. AID PROJ. NO.	FISCAL YEAR	SHEET NO.	TOTAL SHEETS
HAWAII	HAW.	F-061-1(12)	1967	11	12

FINAL SURVEY NO.	DATE	
	BY	
	SURVEYED	
	NOTE BOOK	
	PLATE	
	AREAS	
	CHECKED	

ORIGINAL SURVEY NO.	DATE	
	BY	
	SURVEYED	
	NOTE BOOK	
	PLATE	
	AREAS	
	CHECKED	

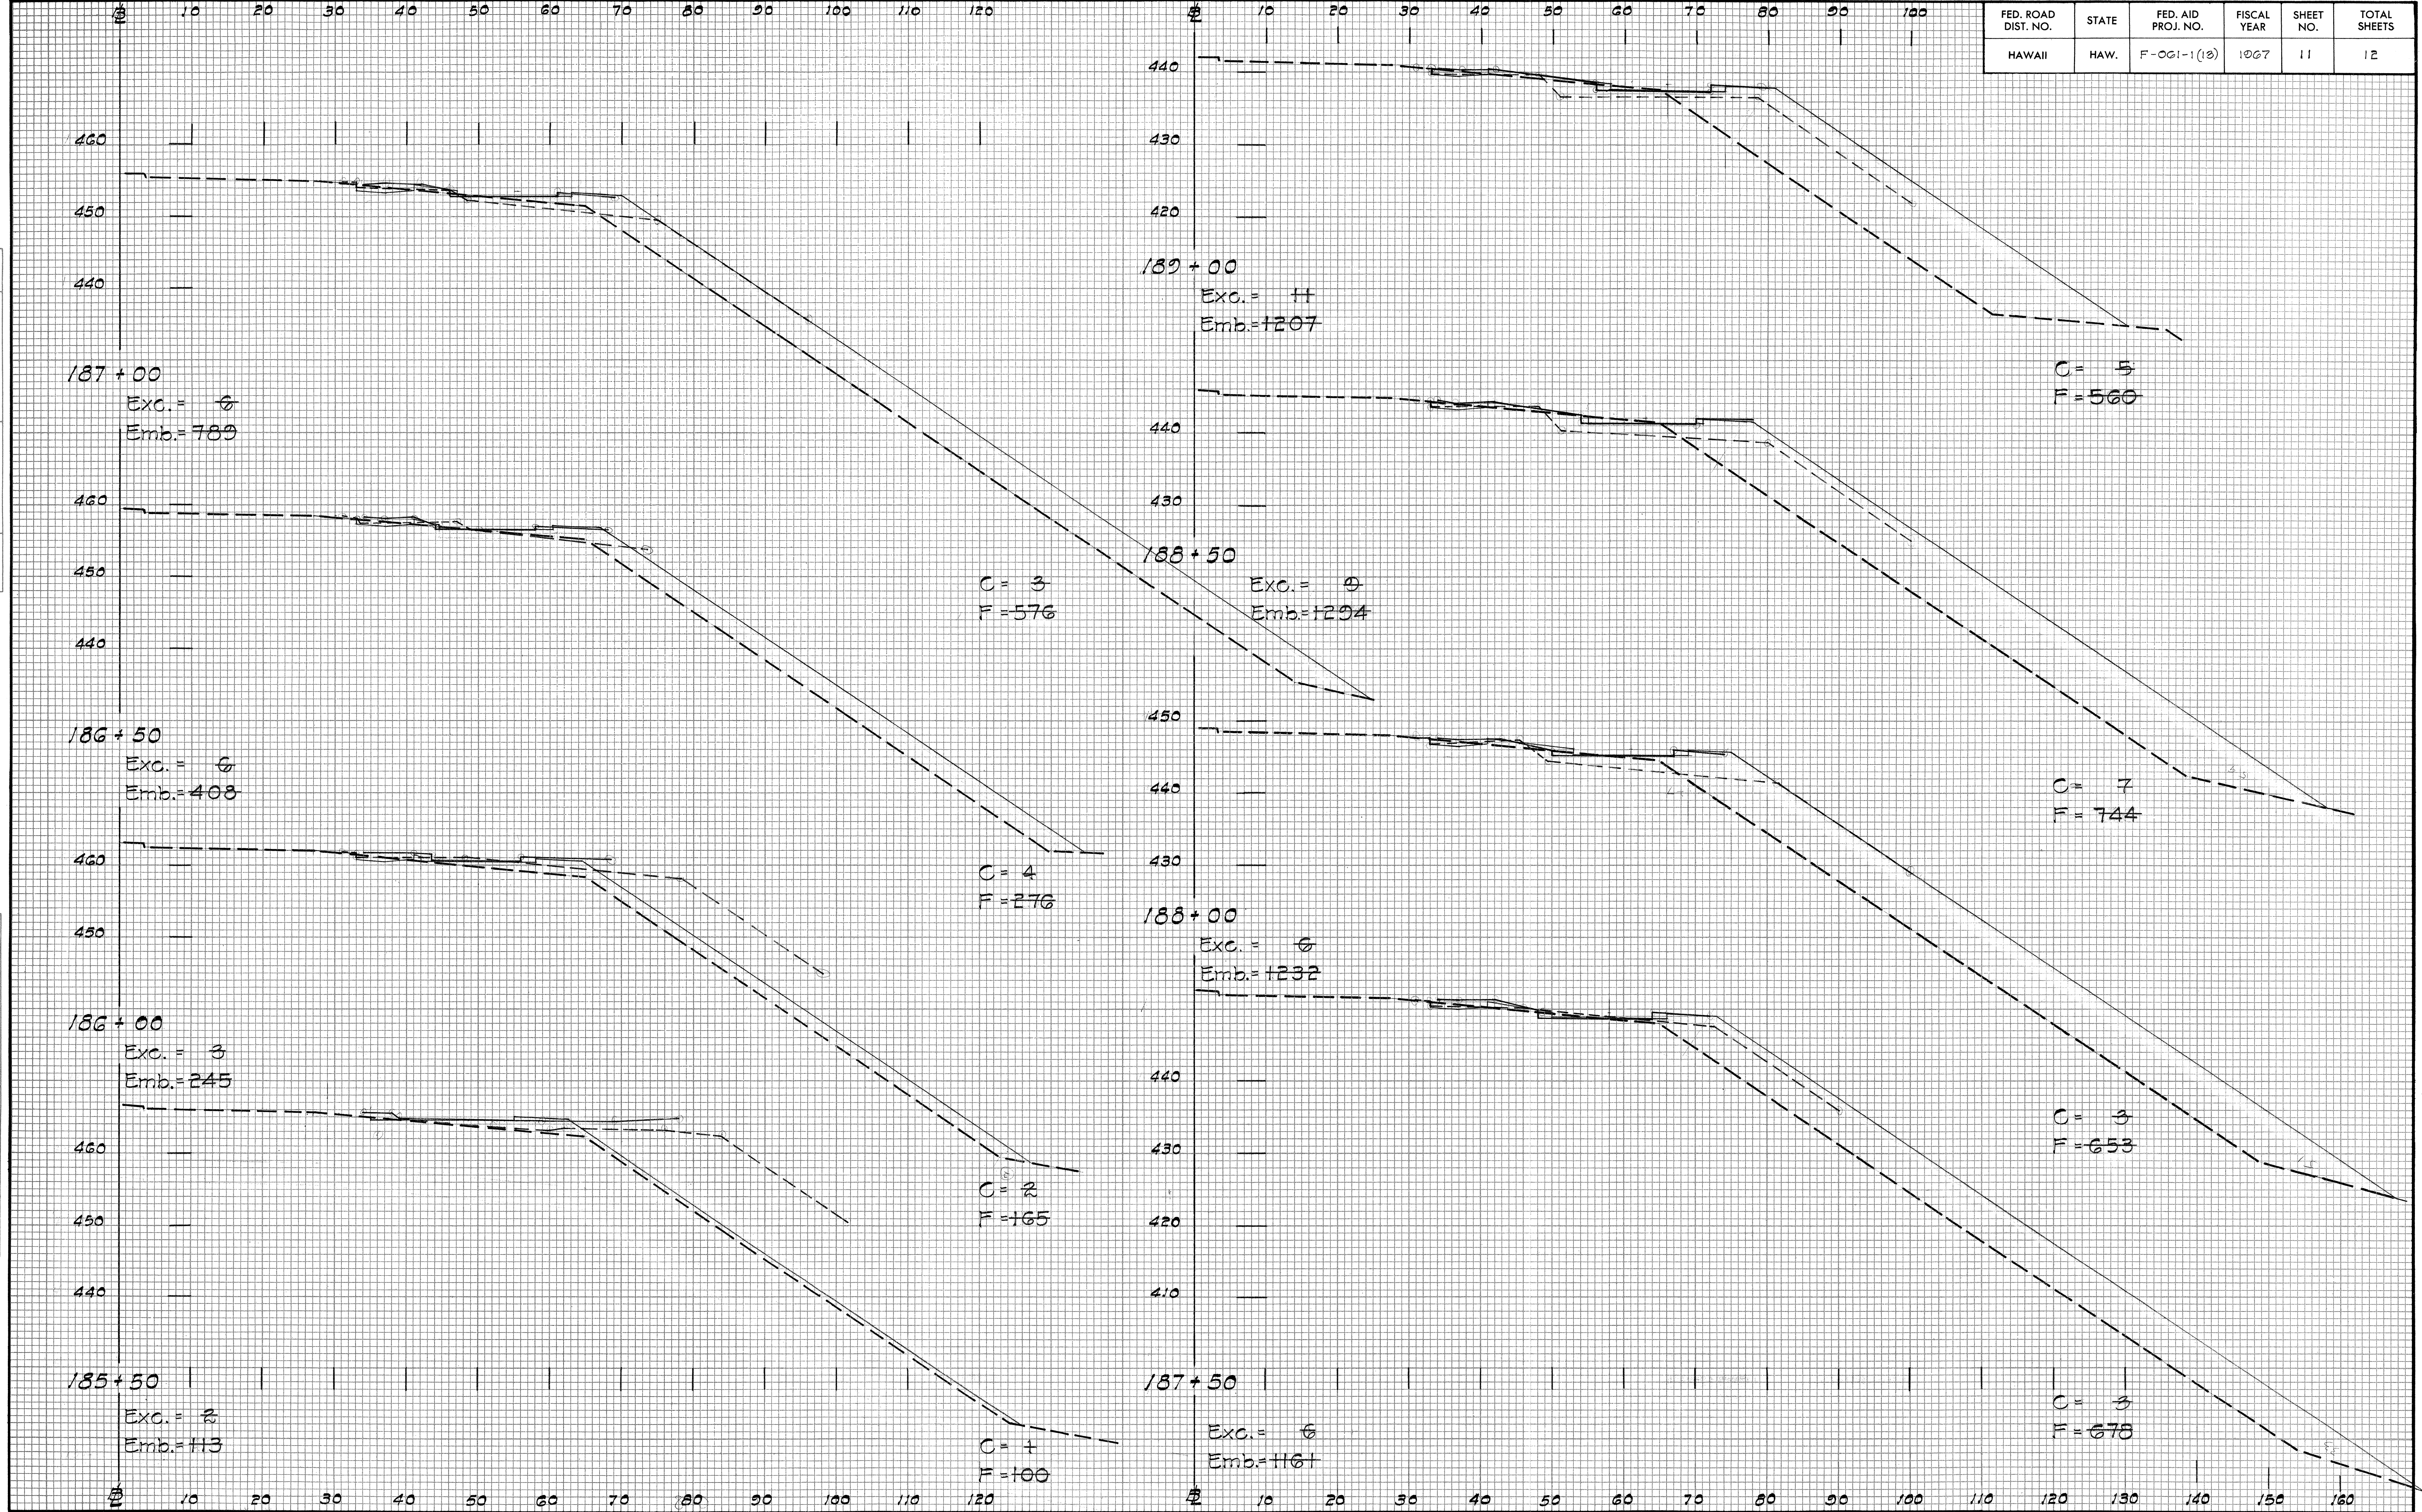

FED. ROAD DIST. NO.	STATE	FED. AID PROJ. NO.	FISCAL YEAR	SHEET NO.	TOTAL SHEETS
HAWAII	HAW.	F-00-1(13)	1967	12	12

