FED. ROAD DIST. NO.	STATE	FED. AID PROJ. NO.	FISCAL YEAR	SHEET NO.	TOTAL SHEETS
HAWAII	HAW.	61B-05-70	1969	1	11

INDEX TO DRAWINGS

SHEET NO.	DESCRIPTION
1	TITLE SHEET
	LAYOUT PLAN
	TYPICAL SECTIONS
2 - 4	PLANS
5 11	STANDARD DETAILS

STATE OF HAWAII
DEPARTMENT OF TRANSPORTATION
HIGHWAYS DIVISION
HONOLULU, HAWAII

FOR

REMOVE AND INSTALL GUARD RAILS AND APPURTENANCES ON PALI HIGHWAY, CARTER'S CORNER TO PALI TUNNEL

PROJECT NO. 61B-05-70

DISTRICT OF HONOLULU
ISLAND OF OAHU

AS BUILT PLANS

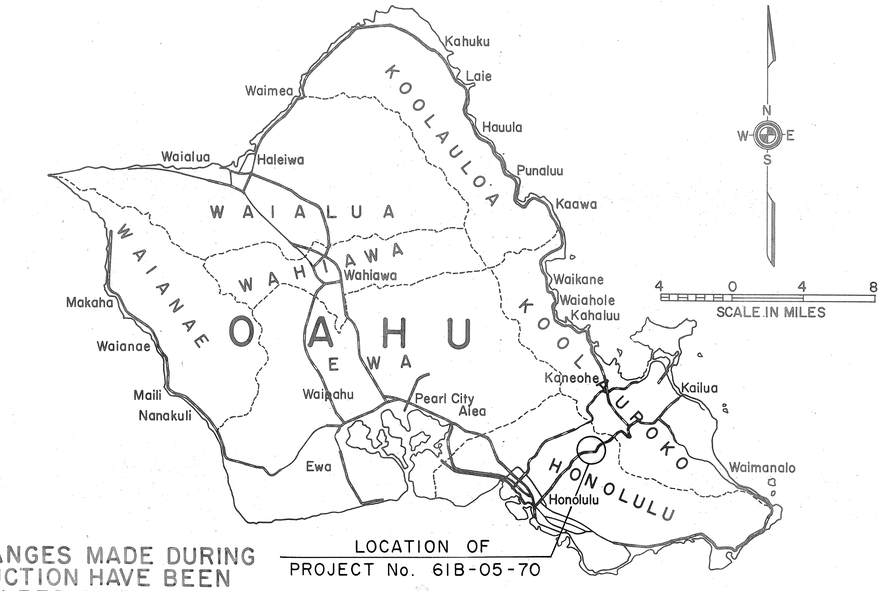

NOTE:
ALL CHANGES MADE DURING CONSTRUCTION HAVE BEEN NOTED IN RED ON THESE TRACINGS AND CHECKED BY:

PROJECT ENGINEER
Nov. 15, 1971
DATE

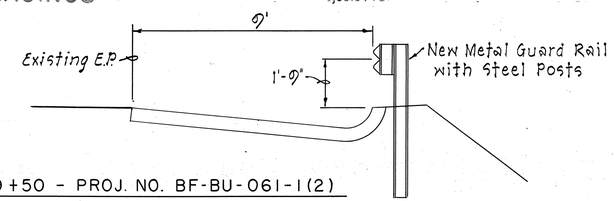

STA. 26+00 to STA. 109+50 - PROJ. NO. BF-BU-061-1(2)

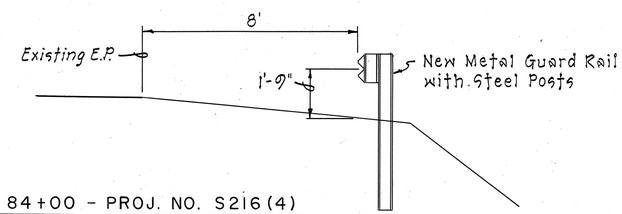

STA. 41+98.64 to STA. 84+00 - PROJ. NO. S216(4)

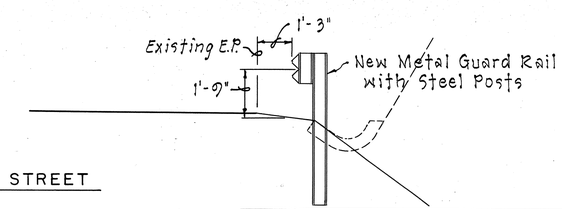

WAOKANAKA STREET

TYPICAL GUARD RAIL LAYOUT SECTIONS
Scale: 3/8" = 1'-0"

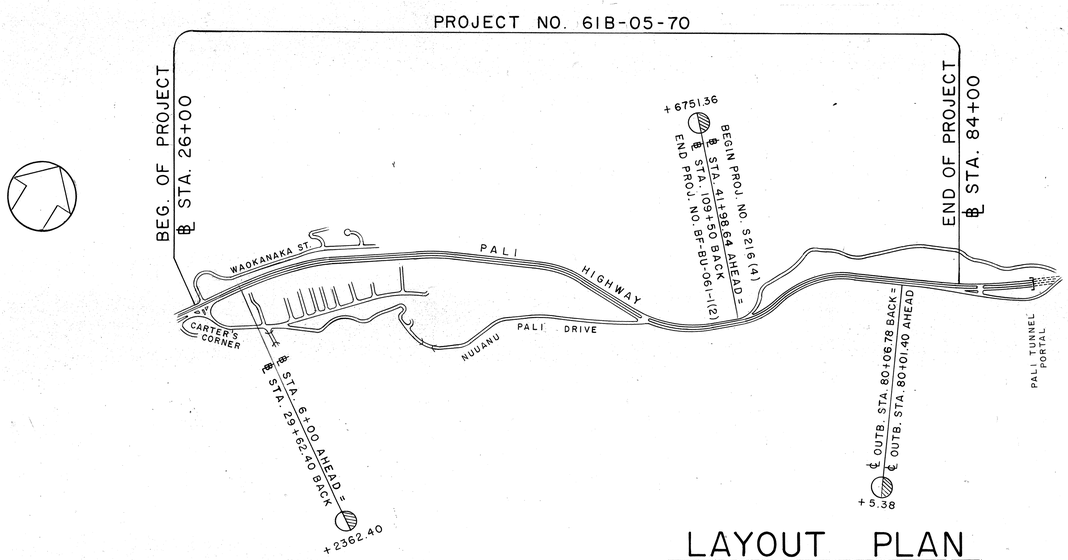

LAYOUT PLAN

SCALE IN MILES
0 0.5 1

LENGTH OF PROJECT.... 2.825 Miles

DEPARTMENT OF TRANSPORTATION
STATE OF HAWAII
APPROVED:
E. Alvey Wright 12/11/69
for DIR. OF TRANSPORTATION DATE

D. BEVIER September, 1969

D-6-6