FED. ROAD DIST. NO.	STATE	PROJ. NO.	FISCAL YEAR	SHEET NO.	TOTAL SHEETS
HAWAII	HAW.	0-05-72 PHASE II	72	1	10

INDEX TO DRAWINGS

SHEET NO.	DESCRIPTION
1	TITLE SHEET
2	PLAN & DETAILS
3	TYPICAL ROAD SECTION AND MISCELLANEOUS DETAILS
4-10	STANDARD DETAILS

STATE OF HAWAII

DEPARTMENT OF TRANSPORTATION
HIGHWAYS DIVISION

HONOLULU, HAWAII

"AS BUILT" PLANS FOR

DOUBLE LEFT TURN LANES
KAMEHAMEHA HWY at CASTLE JUNCTION

PROJECT NO. HWY-0-05-72
(PHASE II)
DISTRICT OF KOOLAUPOKO
ISLAND OF OAHU

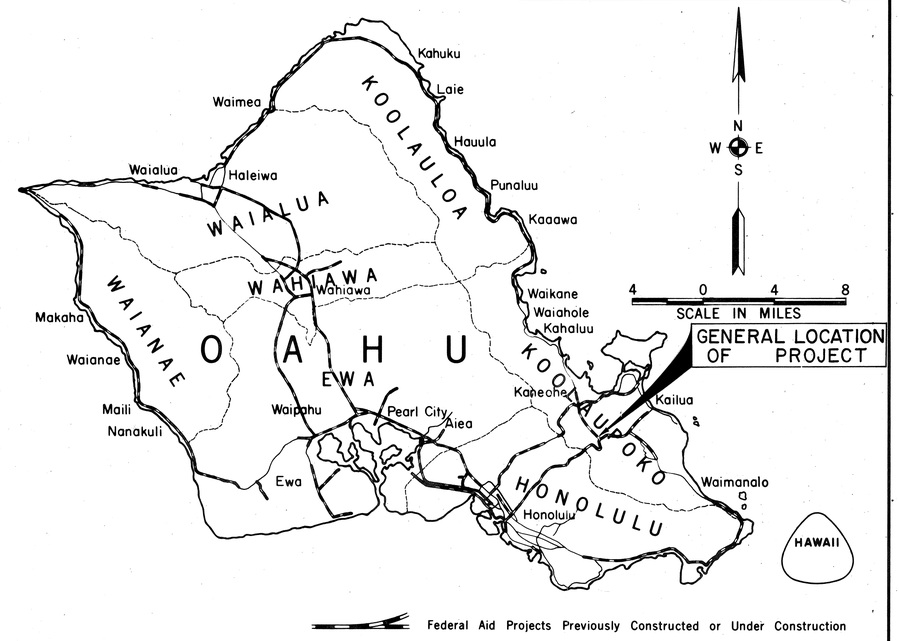

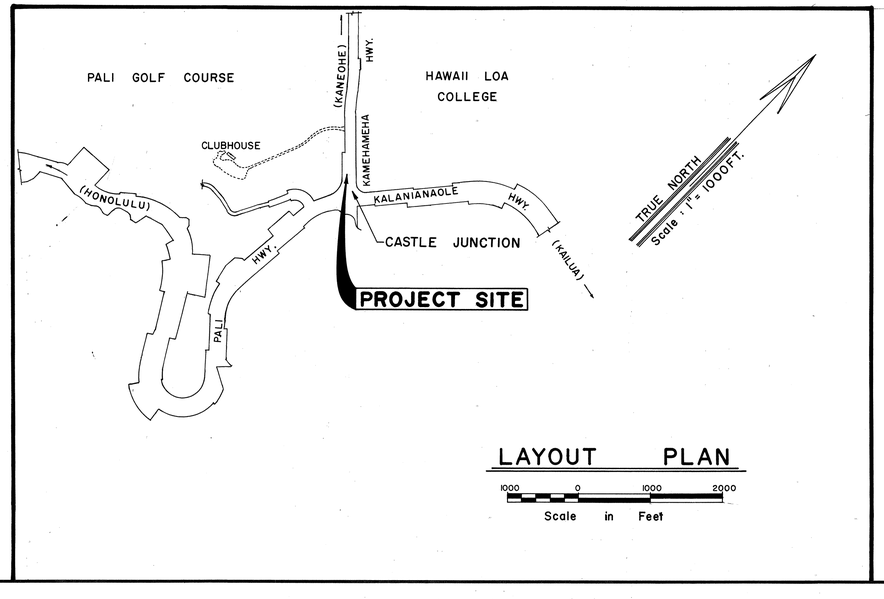

NOTE:
ALL CHANGES MADE HAVE BEEN INCORPORATED ON THESE PLANS.

Phillip J. Alencastre
PROJECT ENGINEER
10-6-72
DATE

HENRY TUCK AU
REGISTERED PROFESSIONAL ENGINEER
No. 556
HAWAII, U.S.A.

THIS WORK WAS PREPARED BY ME OR UNDER MY SUPERVISION.
Henry Tuck Au
556-E
February 25, 1972

DEPARTMENT OF TRANSPORTATION
STATE OF HAWAII
APPROVED:
Murray Lee
FOR DIR. OF TRANSPORTATION
4/18/72
DATE

Henry Tuck Au	T. K. Chun	9487532	4-11-72
DESIGNED BY	P. S. & E. BY	PHONE	DATE

D-8-4