| FED. ROAD DIST. NO. | STATE | PROJ. NO. | FISCAL YEAR | SHEET NO. | TOTAL SHEETS |
|---|---|---|---|---|---|
| HAWAII | HAW. | 61B-02-72 | 1974 | 1 | 13 |

## INDEX TO DRAWINGS


| SHEET NO. | DESCRIPTION |
|---|---|
| 1 | TITLE SHEET |
| 2 | HIGHWAY LIGHTING PLAN STA. 147+00 TO STA. 160+00 |
| 3 | HIGHWAY LIGHTING PLAN STA. 160+00 TO STA. 177+00 |
| 4 | HIGHWAY LIGHTING PLAN STA. 177+00 TO STA. 193+00 |
| 5 | HIGHWAY LIGHTING PLAN STA. 193+00 TO STA. 212+00 |
| 6 | HIGHWAY LIGHTING PLAN STA. 212+00 TO STA. 242+00 |
| 7 | HIGHWAY LIGHTING PLAN STA. 242+00 TO STA. 272+90 |
| 8 | HIGHWAY LIGHTING PLAN STA. 272+00 TO STA. 287+00 |
| 9 | HIGHWAY LIGHTING PLAN STA. 287+00 TO STA. 303+00 |
| 10 | STREET LIGHT STANDARDS & DETAILS |
| 11 | FLOOD LIGHT DETAILS & MISC. DETAILS |
| 12 | ELECTRIC POLE DETAILS, & SINGLE LINE DIAGRAM |
| 13 | PULL BOX DETAILS |


STATE OF HAWAII

DEPARTMENT OF TRANSPORTATION
HIGHWAYS DIVISION

HONOLULU, HAWAII

"AS BUILT"

PLANS FOR

# HIGHWAY LIGHTING IMPROVEMENT ON PALI AND KALANIANAOLE HIGHWAYS BETWEEN PALI TUNNEL & WAIMANALO JUNCTION

# PROJECT NO. 61B-02-72

## DISTRICT OF KOOLAUPOKO
## ISLAND OF OAHU

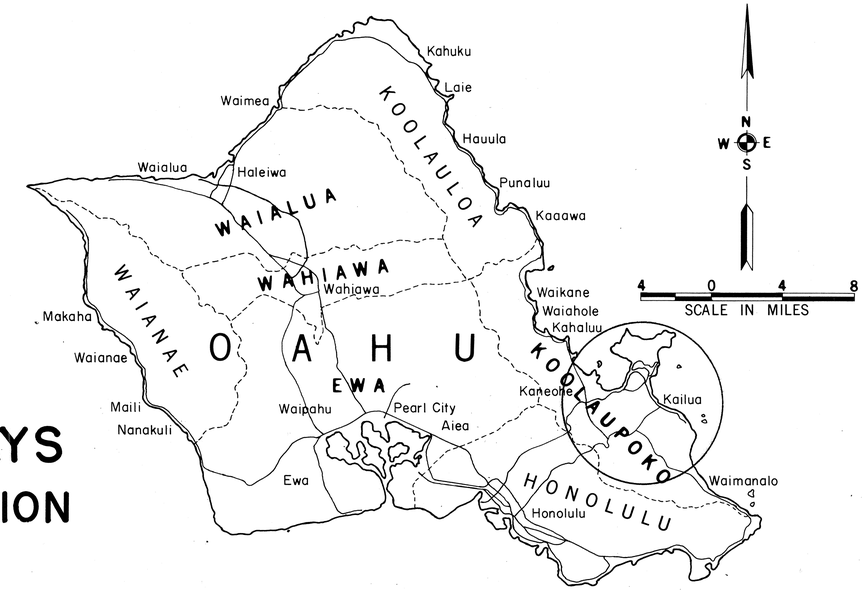


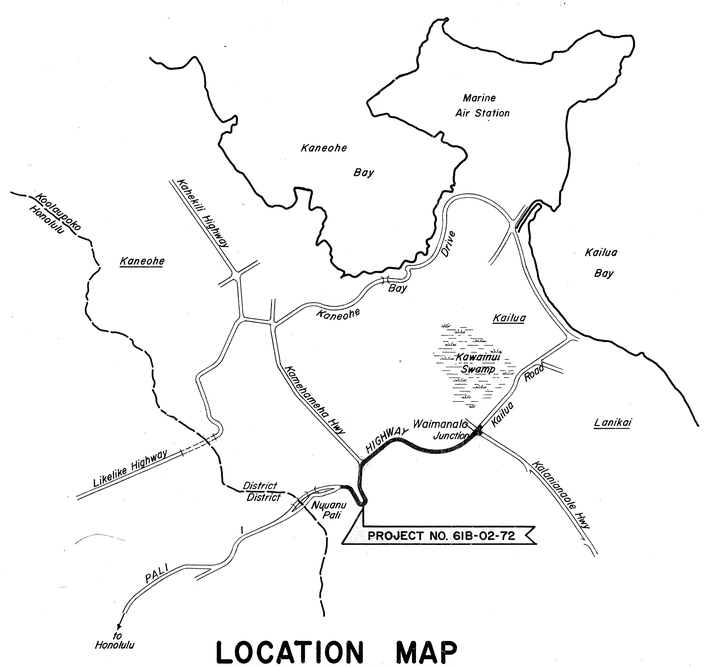


## LOCATION MAP

NOTE:

ALL CHANGES MADE DURING CONSTRUCTION HAVE BEEN INCORPORATED ON THESE PLANS EXCEPT CHANGES IN THE ORIGINAL THEORETICAL QUANTITIES.

Dennis T. Hagn
PROJECT ENGINEER

2/22/77
DATE

| DEPARTMENT OF TRANSPORTATION STATE OF HAWAII | |
|---|---|
| APPROVED: Murray Lee | 1/4/74 |
| FOR DIR. OF TRANSPORTATION | DATE |

| DESIGNED BY | DRAWN BY | PHONE | DATE |
|---|---|---|---|
| ALBERT S.C. CHONG | FRED ABESHIMA P. S. & E. | 548-4042 | 9/4/73 |