


FED. ROAD DIST. NO.	STATE	FED. AID PROJ. NO.	FISCAL YEAR	SHEET NO.	TOTAL SHEETS
HAWAII	HAW.	61B-01-76M	1976	15-1	1

DATE	BY	FINAL SURVEY	NOTE BOOK	AREAS CHECKED

DATE	BY	ORIGINAL SURVEY	NOTE BOOK	AREAS CHECKED

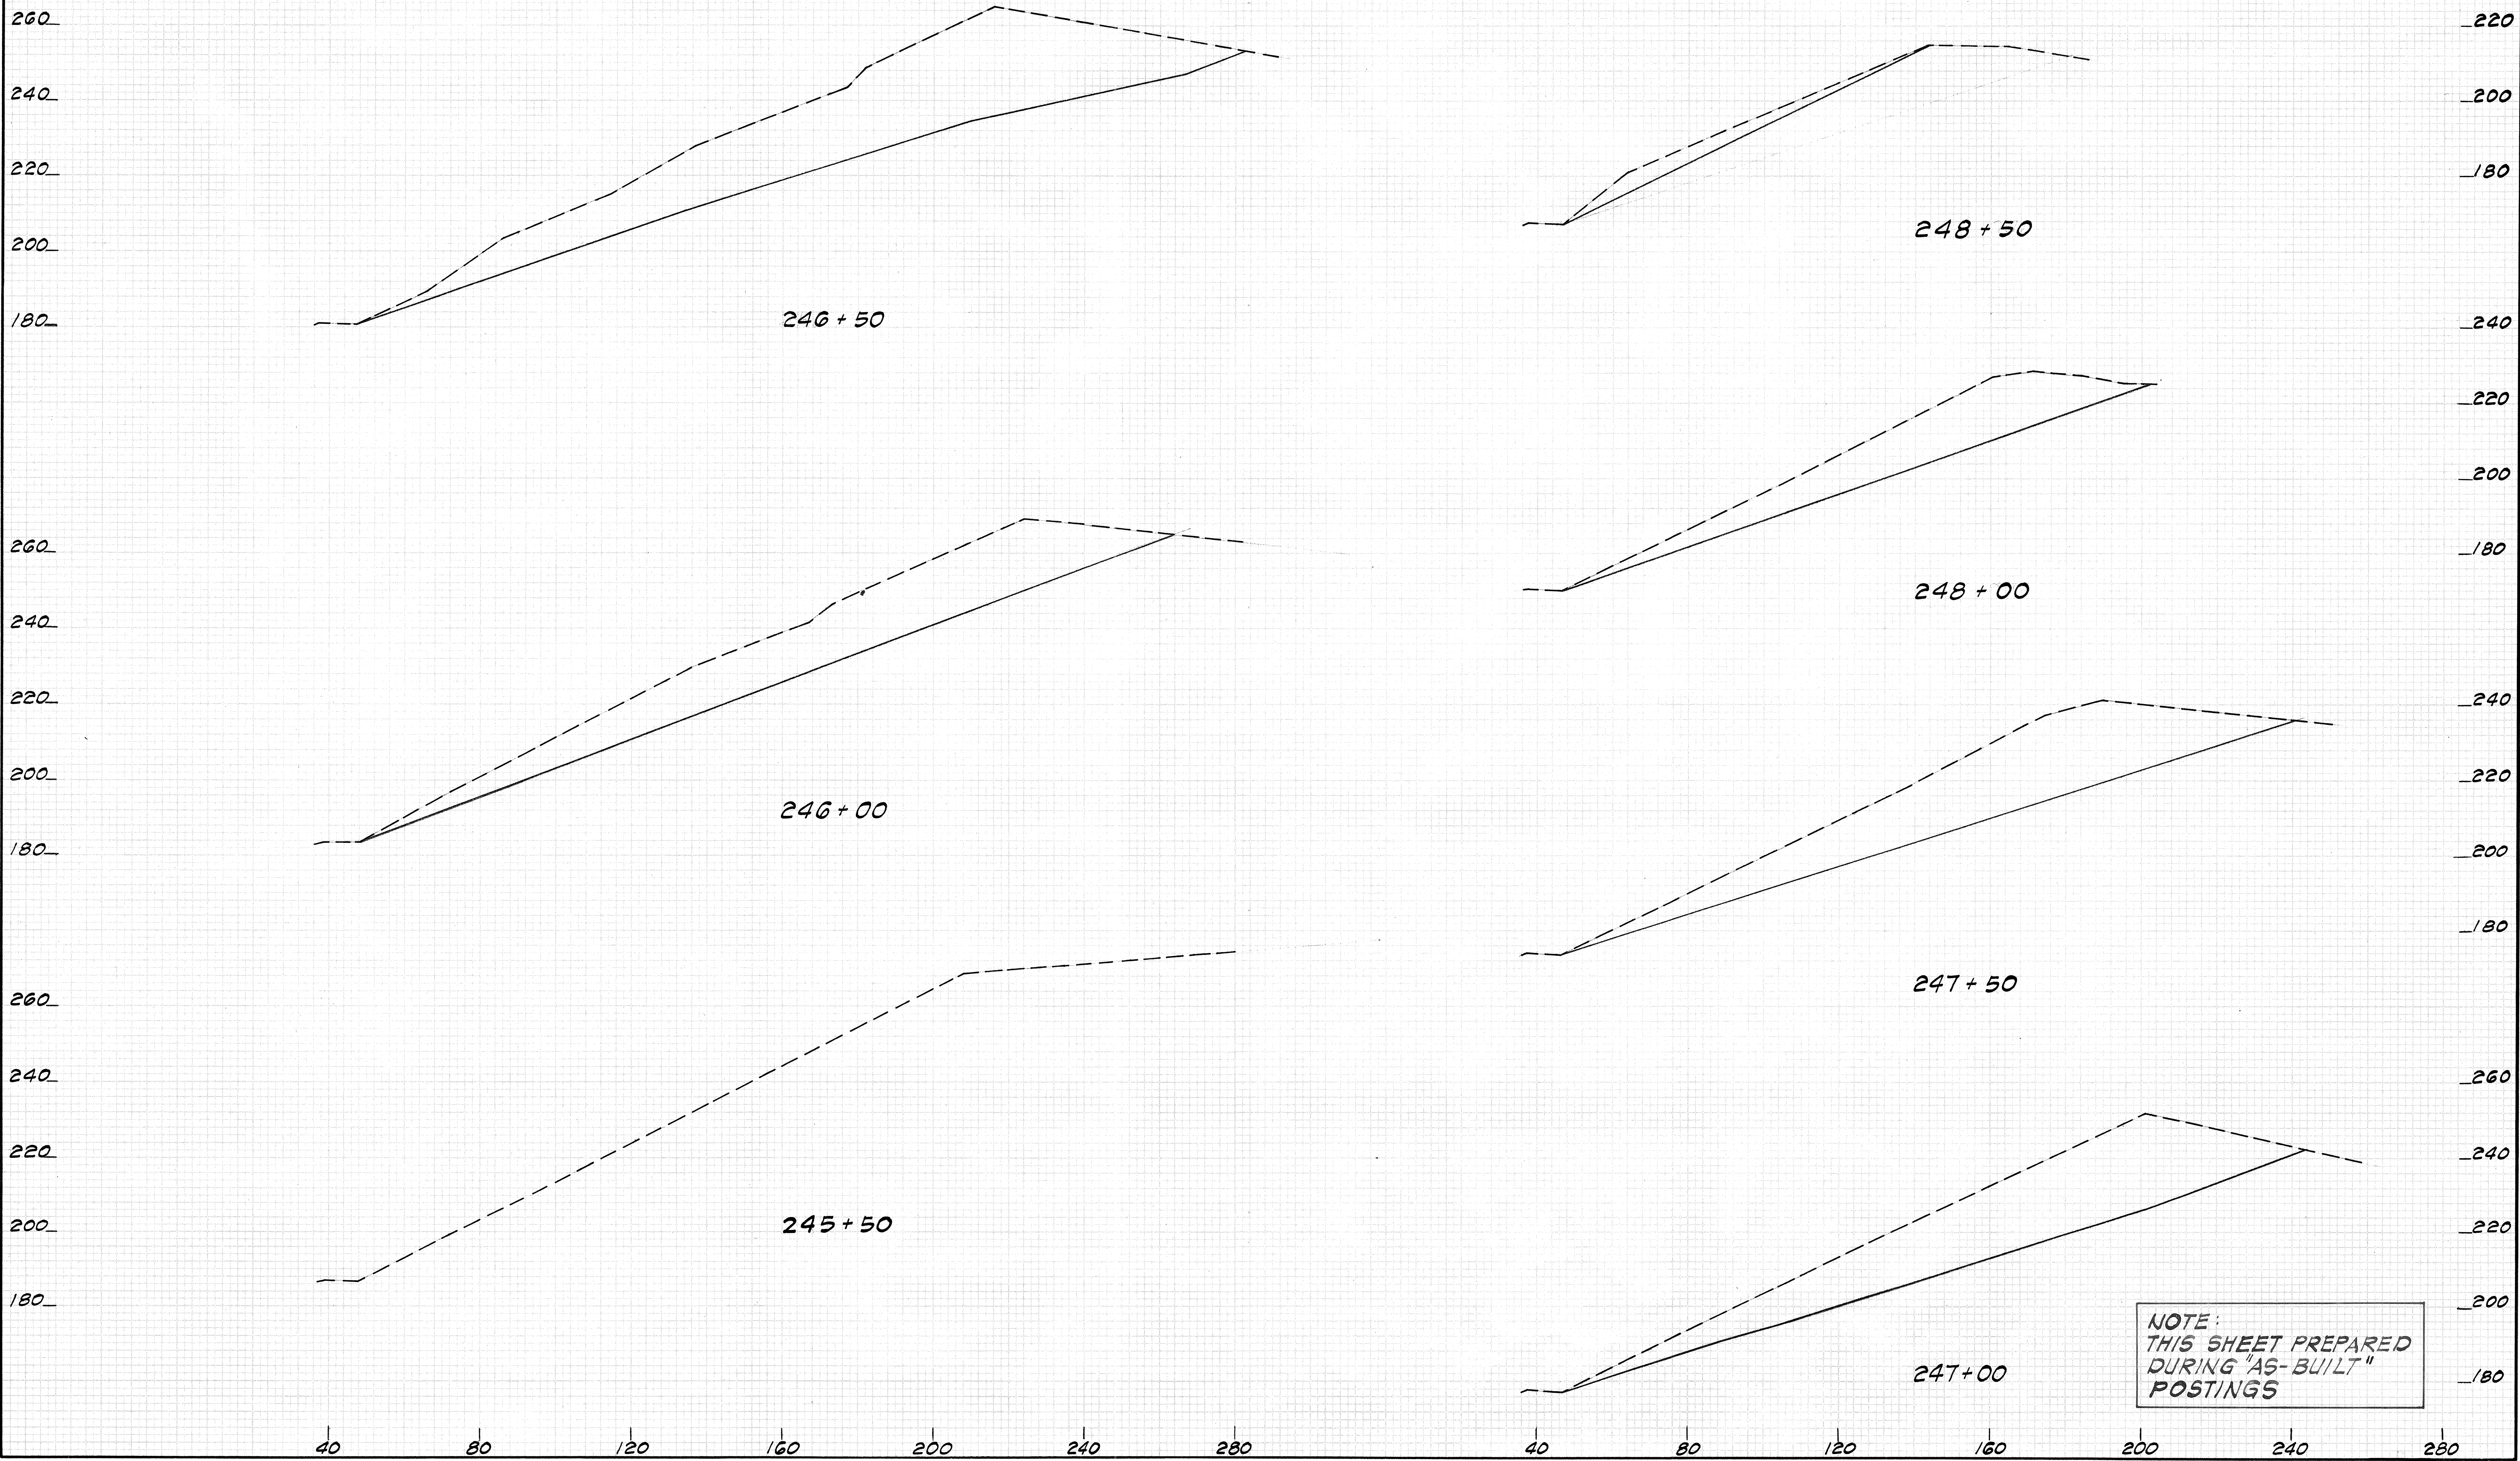

NOTE:
THIS SHEET PREPARED
DURING "AS-BUILT"
POSTINGS