INDEX TO DRAWINGS	
SHEET NO.	DESCRIPTION
1	TITLE SHEET
2-3	TYPICAL SECTIONS, GEN. NOTES, RECONSTRUCTION DETAILS
4-7	PLANS
8-11	PAVEMENT MARKING
12-17	STANDARD AND MISC. DETAILS

FED. ROAD DIST. NO.	STATE	FED. AID PROJ. NO.	FISCAL YEAR	SHEET NO.	TOTAL SHEETS
HAWAII	HAW.	FR-061-1(24)	1980	1	17

STATE OF HAWAII

DEPARTMENT OF TRANSPORTATION
HIGHWAYS DIVISION

"AS BUILT"

PLANS FOR

PALI HIGHWAY RESURFACING

Vineyard Boulevard to Kuakini Street
and
Hinalo Place to Waokanaka Street
FEDERAL AID PROJECT NO. FR-061-1(24)

DISTRICT OF HONOLULU
ISLAND OF OAHU

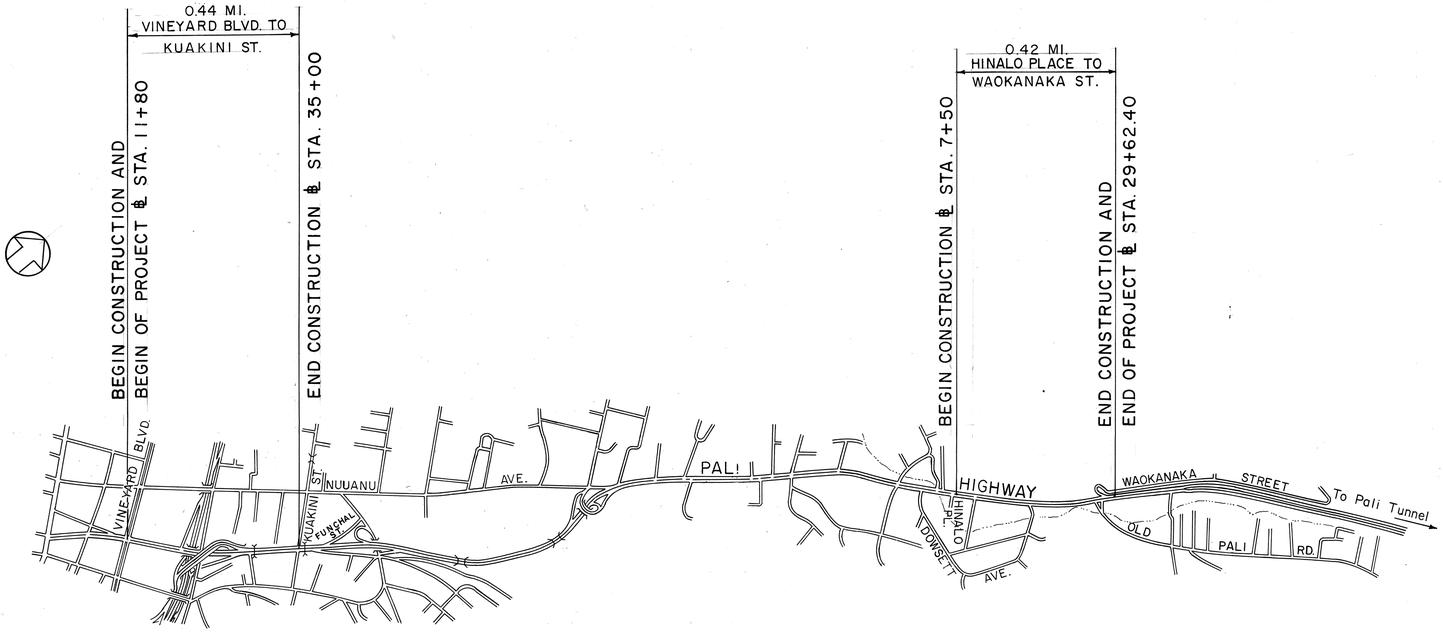

LAYOUT PLAN
SCALE IN MILES
0 0.5 1

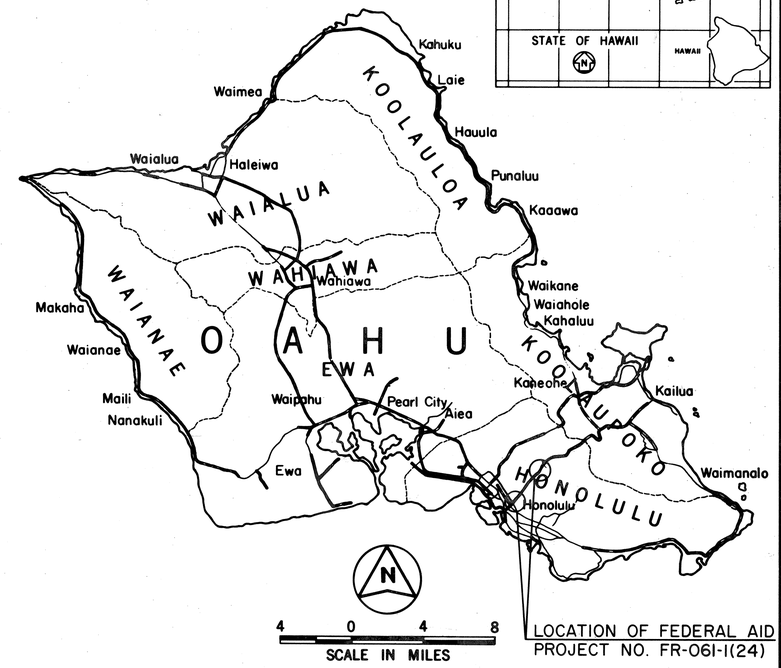

LOCATION OF FEDERAL AID PROJECT NO. FR-061-1(24)

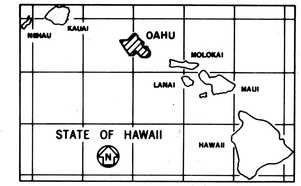

FEDERAL AID PROJECTS PREVIOUSLY CONSTRUCTED OR UNDER CONSTRUCTION

DESIGN DESIGNATION

ADT (1980)	48,000
DESIGN ADT (2000)	64,200
DHV	7,400
D	85/15
T	1.5%
T_{24}	2.5%
K	11.5%

ALL CHANGES MADE DURING CONSTRUCTION HAVE BEEN INCORPORATED ON THESE PLANS EXCEPT CHANGES IN THE ORIGINAL THEORETICAL QUANTITIES

Robert P. Nishi — RESIDENT ENGINEER
29 July 1981 — DATE

DESIGNED BY	PHONE	DATE
MIKE MIURA	548-7490	4-28-80
"C" P. S. & E. BY		

DEPARTMENT OF TRANSPORTATION FEDERAL HIGHWAY ADMINISTRATION	
APPROVED:	
for DIVISION ADMINISTRATOR	5.14.80 DATE

DEPARTMENT OF TRANSPORTATION STATE OF HAWAII	
APPROVED:	
James R. Canas DIR. OF TRANSPORTATION	4/28/80 DATE