FED. ROAD DIST. NO.	STATE	PROJ. NO.	FISCAL YEAR	SHEET NO.	TOTAL SHEETS
HAWAII	HAW.	61B-01-81M	1981	1	14

INDEX TO DRAWINGS

SHEET NO.	DESCRIPTION
1	TITLE SHEET
2-3	GENERAL NOTES, TYPICAL SECTIONS AND DETAILS
4-6	PLAN
7-8	DRAINAGE DETAILS
9-14	TYPICAL AND STANDARD DETAILS

STATE OF HAWAII

DEPARTMENT OF TRANSPORTATION
HIGHWAYS DIVISION

"AS-BUILT"
PLANS FOR

PALI HIGHWAY RESURFACING
WAOKANAKA STREET TO RESERVOIR NO. 4

PROJECT NO. 61B-01-81M

DISTRICT OF HONOLULU
ISLAND OF OAHU

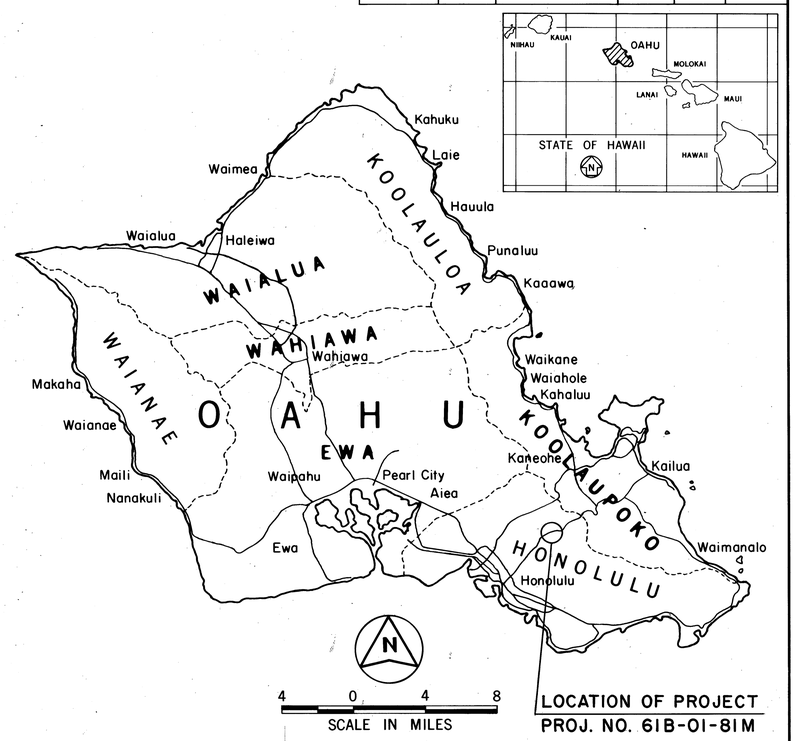

LOCATION OF PROJECT
PROJ. NO. 61B-01-81M

ALL CHANGES MADE DURING CONSTRUCTION HAVE BEEN INCORPORATED ON THESE PLANS IN RED EXCEPT CHANGES IN THE ORIGINAL THEORETICAL QUANTITIES. FOR ACTUAL QUANTITIES, REFER TO PROJECT LEDGER AND/OR COMPUTATION BOOK.

RESIDENT ENGINEER — 1/3/82 DATE

PALI HIGHWAY RESURFACING
PROJ. NO. 61B-01-81M

Outbound Lanes Limits
Inbound Lanes Limits

BEGIN PROJECT ℄ STA. 6 + 00
℄ STA. 66 + 00
℄ STA. 89 + 00 END PROJECT

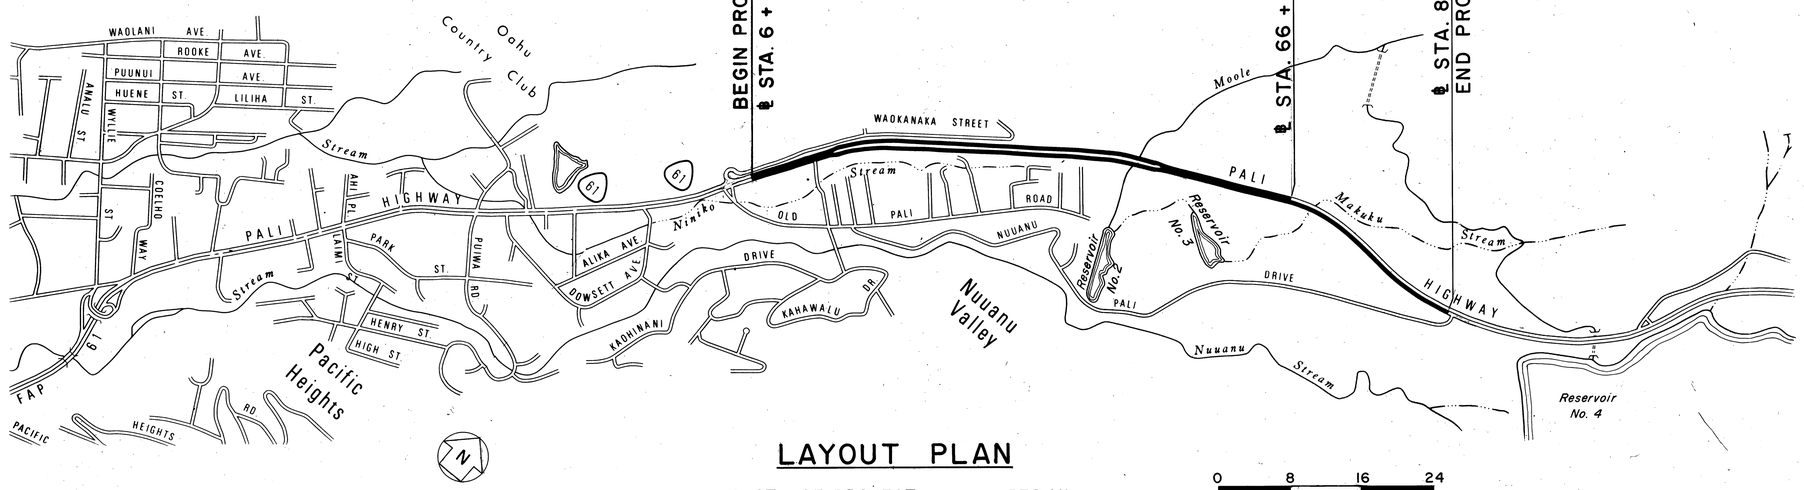

LAYOUT PLAN

LENGTH OF PROJECT .....1.572 MI.

0 8 16 24
SCALE IN HUNDRED FEET

DATE	REVISION
5/27/81	Revised title, proj. no., & proj. limit. Removed FHWA approval block & Design Designation.

DEPARTMENT OF TRANSPORTATION
STATE OF HAWAII

APPROVED: Ryokichi Higashionna — 5/3/81
DIR. OF TRANSPORTATION — DATE

UNIT "C" DESIGNED BY — UNIT "C" P. S. & E. BY — 548-7490 PHONE — APR., 1981 DATE

ADD 1