FED. ROAD DIST. NO.	STATE	FED. AID PROJ. NO.	FISCAL YEAR	SHEET NO.	TOTAL SHEETS
HAWAII	HAW.	HES-061-1(26)	1984	1	10

INDEX TO DRAWINGS

SHEET NO.	DESCRIPTION
1	TITLE SHEET
2	PLAN
3-4	TYPICAL DETAILS OF WHEEL CHAIR RAMPS
5	TRAFFIC SIGNAL PLAN
6	LEGEND AND NOTES
7-10	STANDARD DETAILS

STATE OF HAWAII

DEPARTMENT OF TRANSPORTATION

HIGHWAYS DIVISION

HONOLULU, HAWAII

"AS-BUILT"

PLANS FOR

PALI HIGHWAY

MODERNIZATION OF TRAFFIC SIGNALS AT SCHOOL STREET AND H-1 OFF-RAMP

FEDERAL AID PROJECT NO. HES-061-1(26)

DISTRICT OF HONOLULU
ISLAND OF OAHU

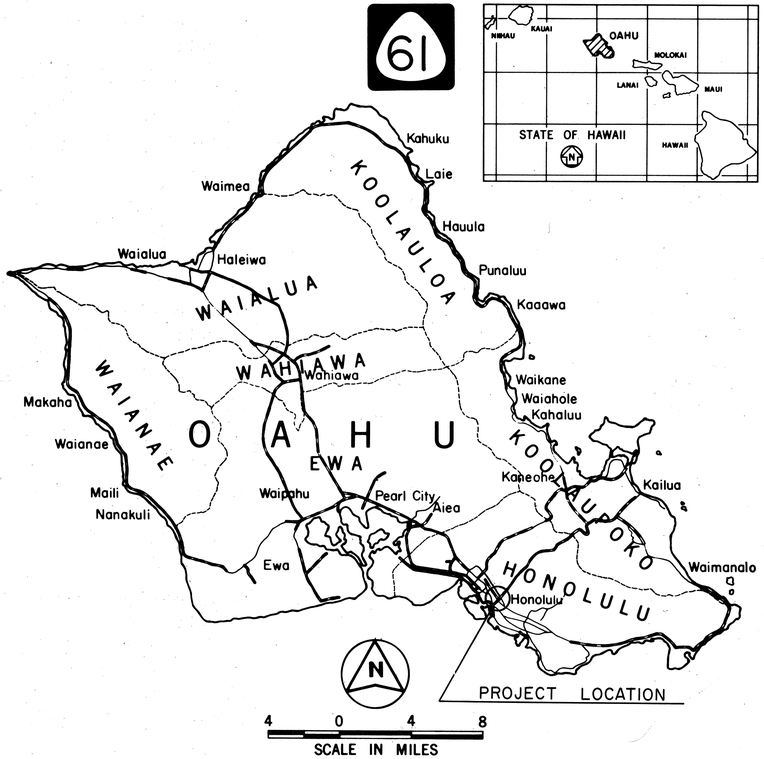

FEDERAL AID PROJECTS PREVIOUSLY CONSTRUCTED OR UNDER CONSTRUCTION

CHANGES MADE DURING CONSTRUCTION HAVE BEEN NOTED ON THESE PLANS AND CHECKED BY:

John Y. J. Chun — RESIDENT ENGINEER — 8/26/85 DATE

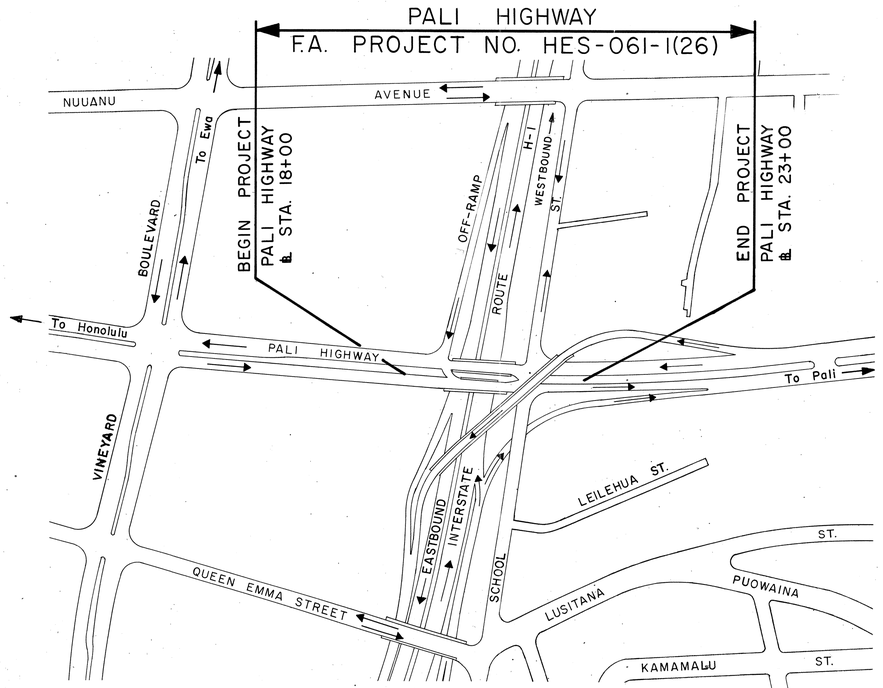

LAYOUT PLAN

DESIGN DESIGNATION

CURRENT ADT (1983)	28,361
DESIGN ADT (2003)	27,058
DHV	4,059
D	60/40
T	4%
V	25 MPH

DEPARTMENT OF TRANSPORTATION FEDERAL HIGHWAY ADMINISTRATION	
APPROVED:	
DIVISION ADMINISTRATOR	5/2/84 DATE

DEPARTMENT OF TRANSPORTATION STATE OF HAWAII	
APPROVED:	
DIR. OF TRANSPORTATION	4/19/84 DATE

R. TSUZUKI	DESIGNED BY
R. TSUZUKI	P. S. & E. BY
548-2456	PHONE
April, 1984	DATE