INDEX TO DRAWINGS	
SHEET NO.	DESCRIPTION
1	TITLE SHEET
2 - 4	GENERAL NOTES, TYPICAL SECTIONS AND TYPICAL DETAILS
5	UTILITY GENERAL NOTES
6 - 11	PLANS
12 - 13	ROADWAY STANDARD DETAILS
14 - 29	PAVEMENT MARKING PLANS AND DETAILS

FED. ROAD DIST. NO.	STATE	PROJ. NO.	FISCAL YEAR	SHEET NO.	TOTAL SHEETS
HAWAII	HAW.	61B-01-85M	1985	1	29

STATE OF HAWAII

DEPARTMENT OF TRANSPORTATION

HIGHWAYS DIVISION

"AS-BUILT"

PLANS FOR

PALI HIGHWAY RESURFACING

KUAKINI STREET TO HINALO PLACE

PROJECT NO. 61B-01-85M

DISTRICT OF HONOLULU

ISLAND OF OAHU

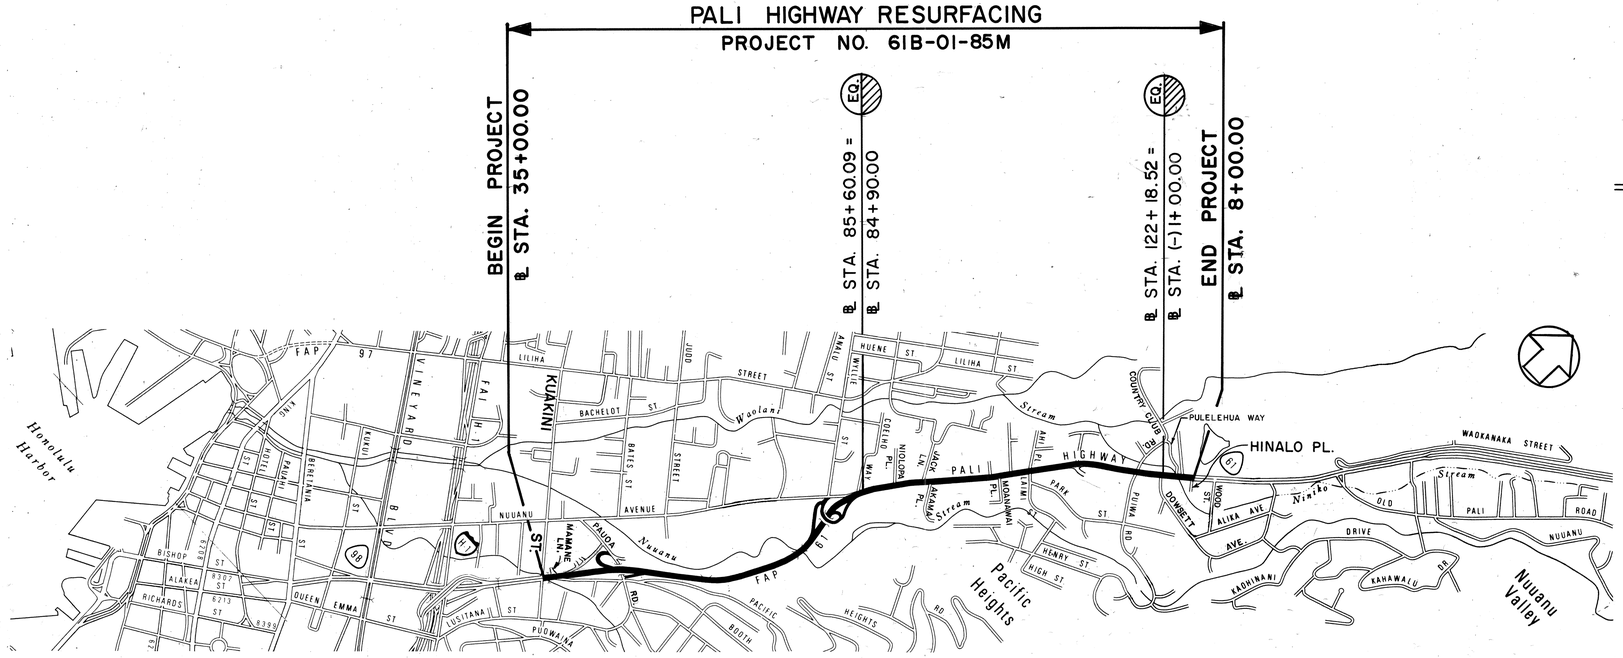

LAYOUT PLAN

GROSS LENGTH OF PROJECT	. . . . .	1.835 MI.
LENGTH OF STRUCTURES	. . . . .	0.030 MI.
NET LENGTH OF ROADWAY	. . . . .	1.805 MI.

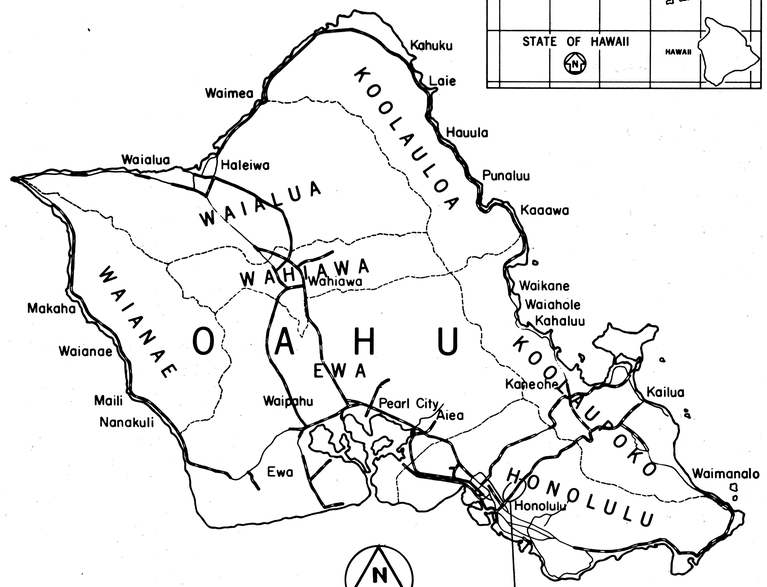

FEDERAL AID PROJECTS PREVIOUSLY CONSTRUCTED OR UNDER CONSTRUCTION

CHANGES MADE DURING CONSTRUCTION HAVE BEEN INCORPORATED ON THESE PLANS EXCEPT CHANGES IN THE ORIGIN THEORETICAL QUANTITIES. FOR ACTUAL QUANTITIES, REFER TO PROJECT LEDGER AND/OR COMPUTATION BOOK.

John Chun for RESIDENT ENGINEER — 10/7/86 DATE

DEPARTMENT OF TRANSPORTATION STATE OF HAWAII	
APPROVED:	
Jonathan K. Shimoda for DIR. OF TRANSPORTATION	11-21-84 DATE

R. Tsuzuki — DESIGNED BY

R. Tsuzuki — P. S. & E. BY — 548-2456 PHONE

Nov., 1984 DATE