FED. ROAD DIST. NO.	STATE	PROJ. NO.	FISCAL YEAR	SHEET NO.	TOTAL SHEETS
HAWAII	HAW.	61A-02-91	1992	1	4

INDEX TO DRAWINGS	
SHEET NO.	DESCRIPTION
1	TITLE SHEET
2	STANDARD PLAN SUMMARY
3	GENERAL NOTES & TYPICAL SECTIONS
4	PLAN & LEGEND

STATE OF HAWAII

DEPARTMENT OF TRANSPORTATION

HIGHWAYS DIVISION

HONOLULU, HAWAII

"AS-BUILT"

PLANS FOR

PALI HIGHWAY SIDEWALK

PHILIPPINE CONSULATE TO HAWAII BAPTIST ACADEMY

PROJECT NO. 61A-02-91

DISTRICT OF HONOLULU
ISLAND OF OAHU

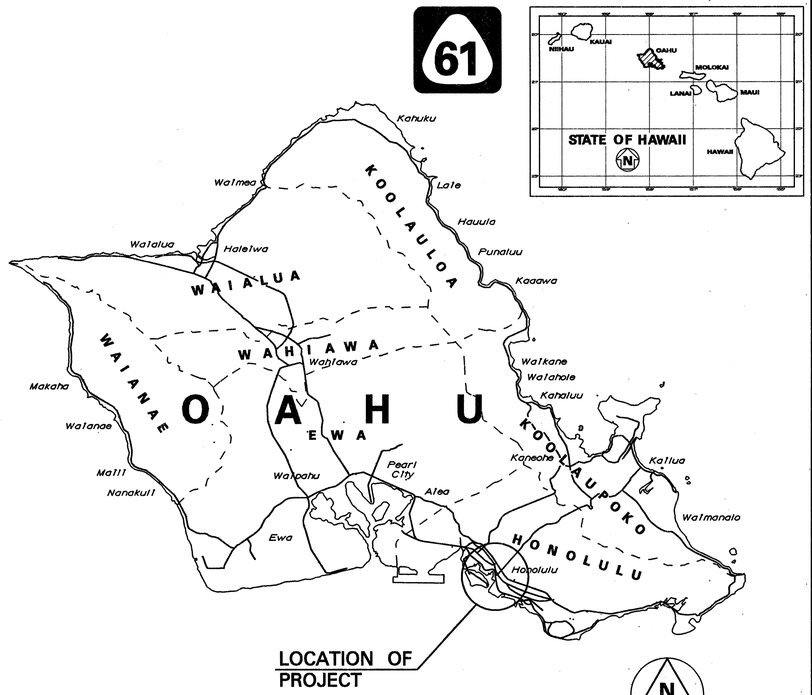

MILE POST 1.24 TO MILE POST 1.34

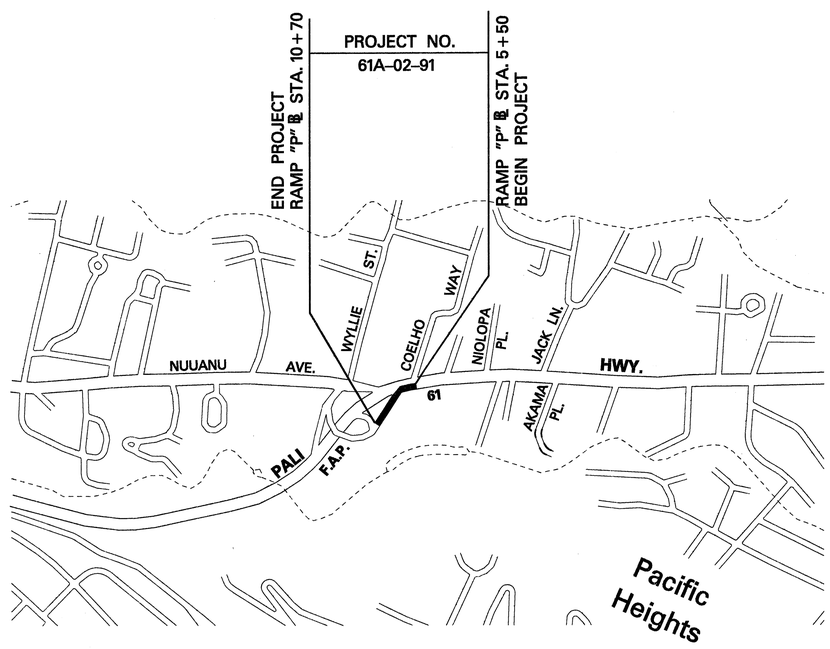

5 0 5 10 15
SCALE IN HUNDRED FEET

LAYOUT PLAN

LENGTH OF PROJECT ..... 0.10 Mile

CHANGES MADE DURING CONSTRUCTION HAVE BEEN INCORPORATED ON THESE PLANS EXCEPT CHANGES IN THE ORIGINAL THEORETICAL QUANTITIES.

Sidney S. C. [illegible] 11/2/93
RESIDENT ENGINEER DATE

UNIT "A"	J. FRONDA	587-2246	OCT. 1991
DESIGNED BY	P. S. & E. BY	PHONE	DATE

DEPARTMENT OF TRANSPORTATION
STATE OF HAWAII

APPROVED:

T. Hirano 12/23/91
FOR DIR. OF TRANSPORTATION DATE

AS-BUILT