FED. ROAD DIST. NO.	STATE	PROJ. NO.	FISCAL YEAR	SHEET NO.	TOTAL SHEETS
HAWAII	HAW.	HWY-O-10-98	1999	1	13

INDEX TO DRAWINGS

SHEET NO.	DESCRIPTION
1	TITLE SHEET
2	STANDARD PLANS SUMMARY
3	SYMBOLS, ELECTRICAL SITE PLAN
4	ELECTRICAL PLAN I
5	ELECTRICAL PLAN II
6	ELECTRICAL PLAN III
7	ELECTRICAL PLAN IV
8	ELECTRICAL PLAN V
9	ELECTRICAL PLAN VI
10	DUCT SECTIONS
11	DETAILS/DIAGRAM
12	WIRING DIAGRAM
13	STREET LIGHTING STANDARD

STATE OF HAWAII

DEPARTMENT OF TRANSPORTATION

HIGHWAYS DIVISION

HONOLULU, HAWAII

PLANS FOR

"AS-BUILT"

WAOKANAKA STREET INSTALLATION OF HIGHWAY LIGHTS

PROJECT NO. HWY-O-10-98

DISTRICT OF HONOLULU
ISLAND OF OAHU

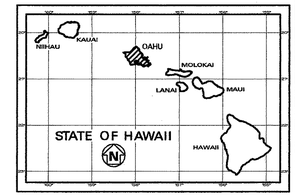

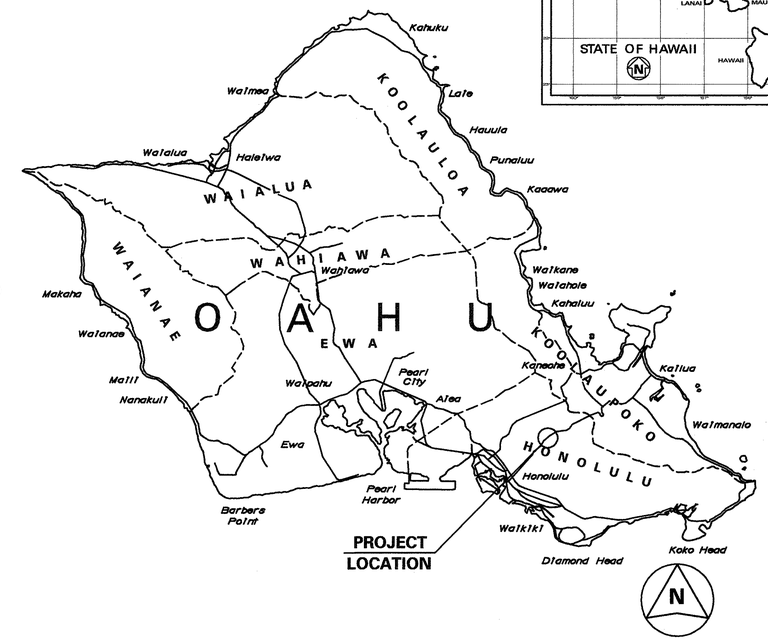

MILE POST 4.66 TO MILE POST 4.76

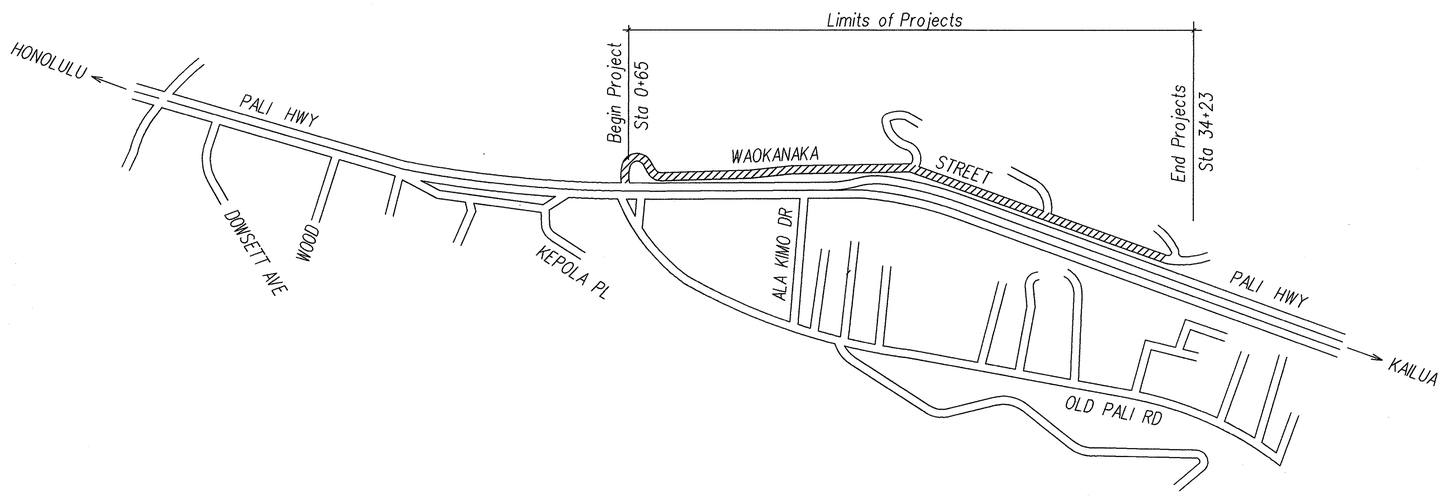

LAYOUT PLAN

Not to Scale

CHANGES MADE DURING CONSTRUCTION HAVE BEEN INCORPORATED ON THE PLANS EXCEPT CHANGES IN THE ORIGINAL TOTAL QUANTITIES. FOR ACTUAL QUANTITIES, REFER TO PROJECT LEDGER AND/OR COMPUTATION BOOK.

RESIDENT ENGINEER — 7/12/00 DATE

DEPARTMENT OF TRANSPORTATION
STATE OF HAWAII

APPROVED:

DIR. OF TRANSPORTATION — 3/3/99 DATE

RON HO & ASSOC. — DESIGNED BY
KARL KUNISHIGE — P. S. & E. BY
692-7679 — PHONE
JAN 1999 — DATE

25 JAN 99 11:36:16 TE z:\mocodgn\projects\97189\97189ti00.dgn