FED. ROAD DIST. NO.	STATE	FEDERAL AID PROJ. NO.	FISCAL YEAR	SHEET NO.	TOTAL SHEETS
HAWAII	HAW.	ER-22(002)	2019	ADD 5	94

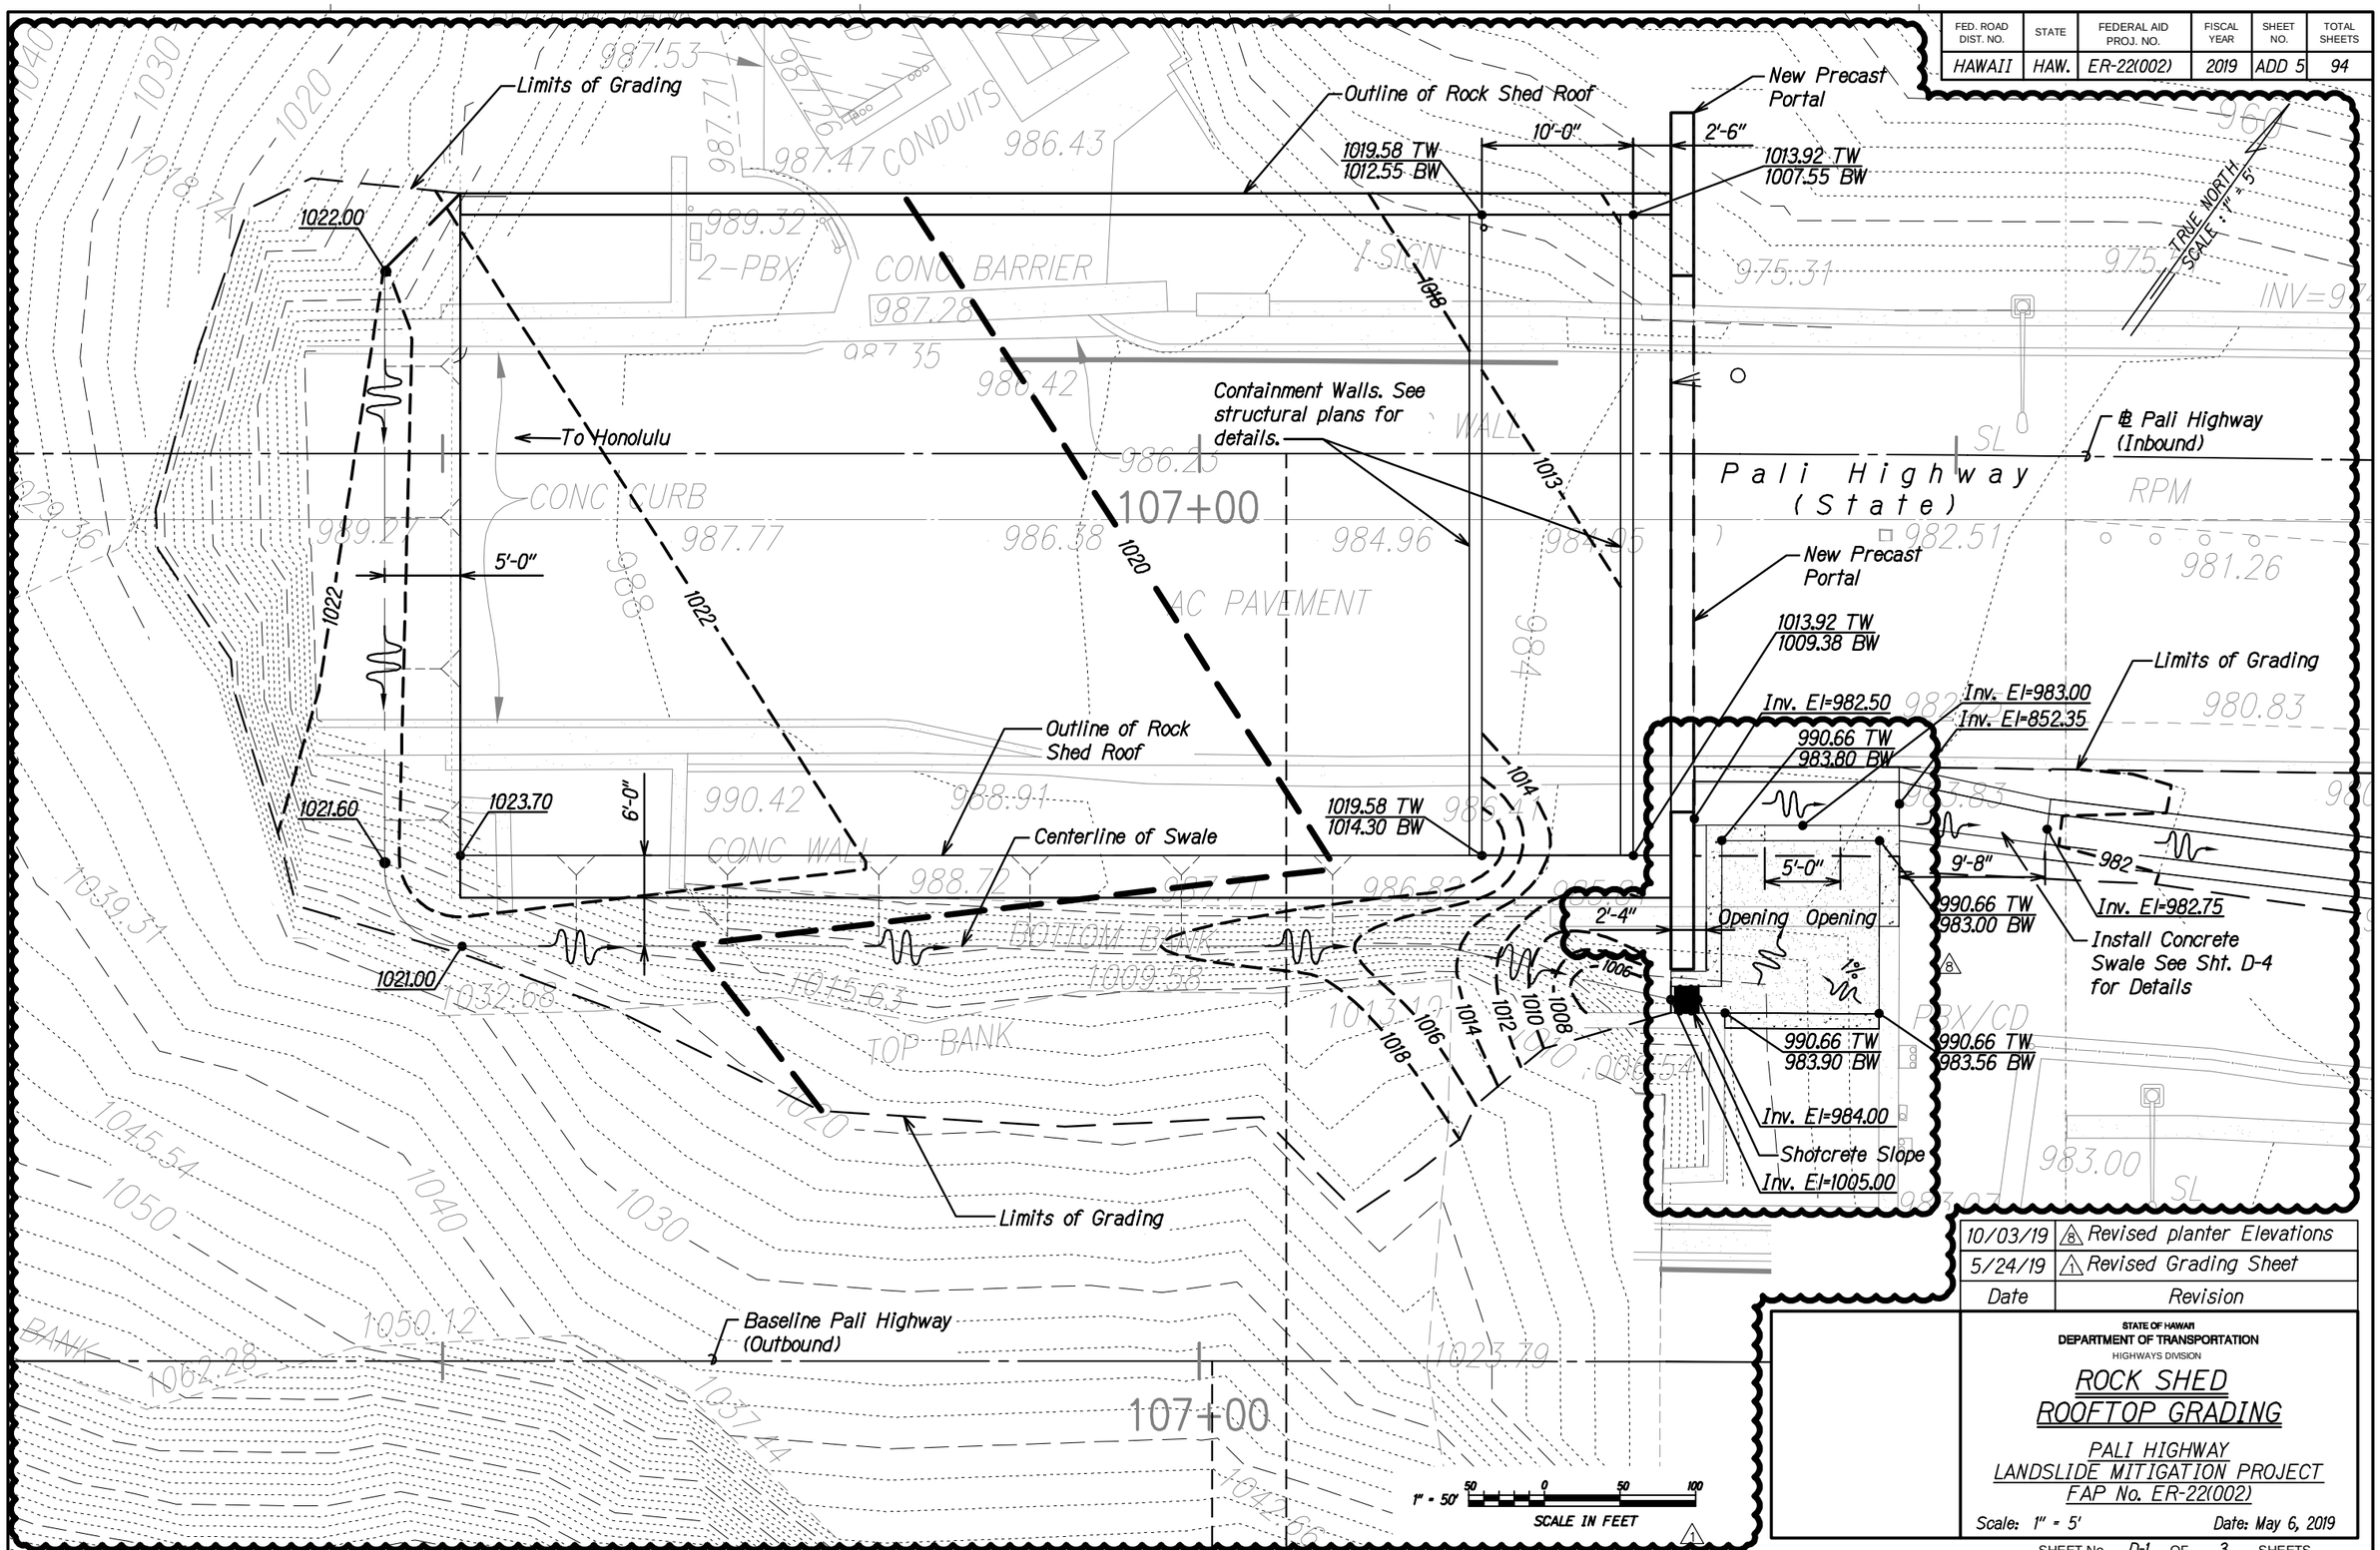

Date	Revision
10/03/19	8 Revised planter Elevations
5/24/19	1 Revised Grading Sheet

STATE OF HAWAII
DEPARTMENT OF TRANSPORTATION
HIGHWAYS DIVISION

ROCK SHED
ROOFTOP GRADING

PALI HIGHWAY
LANDSLIDE MITIGATION PROJECT
FAP No. ER-22(002)

Scale: 1" = 5' Date: May 6, 2019

SHEET No. D-1 OF 3 SHEETS

ADD 5