Rev. Nov. 19, 1951
Rev. Dec. 19, 1951

FINAL SURVEY	BY	DATE
SURVEYED		
PLOTTED		
TEMPLATE		
AREAS		
NOTE BOOK NO.		
AREAS CHECKED		

ORIGINAL SURVEY	BY	DATE
SURVEYED		
PLOTTED		
TEMPLATE		
AREAS		
NOTE BOOK NO.		
AREAS CHECKED		

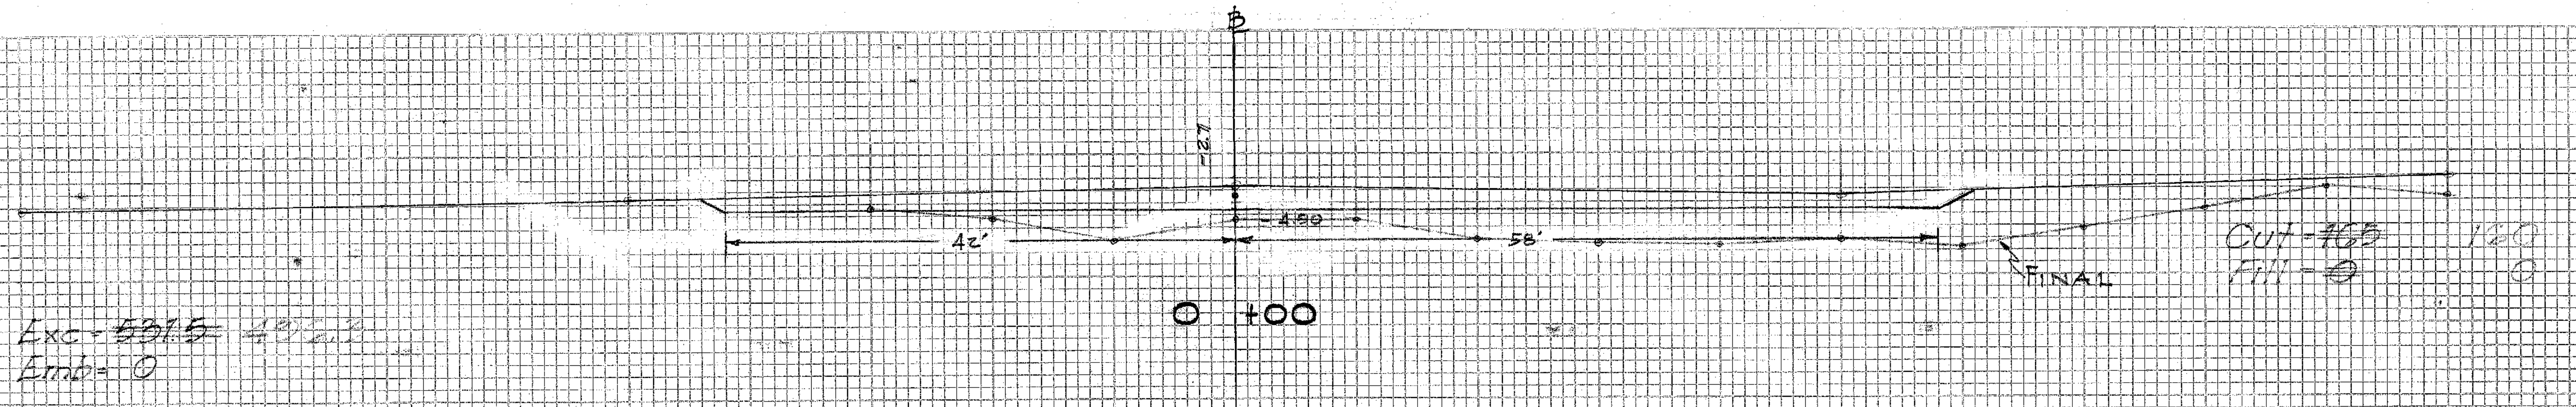

0 +00

Exc = ~~531.5~~ [illegible]
Emb = 0

Cut = ~~165~~ 120
Fill = ~~0~~ 0

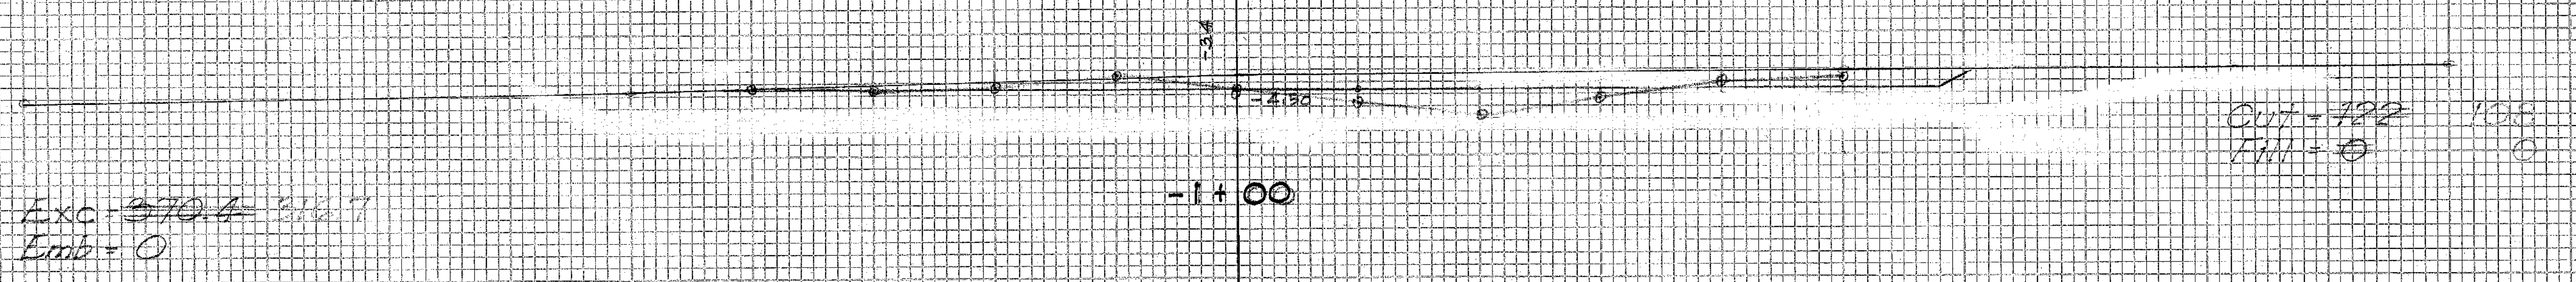

-1 + 00

Exc = ~~370.4~~ [illegible]
Emb = 0

Cut = ~~122~~ 108
Fill = 0 0

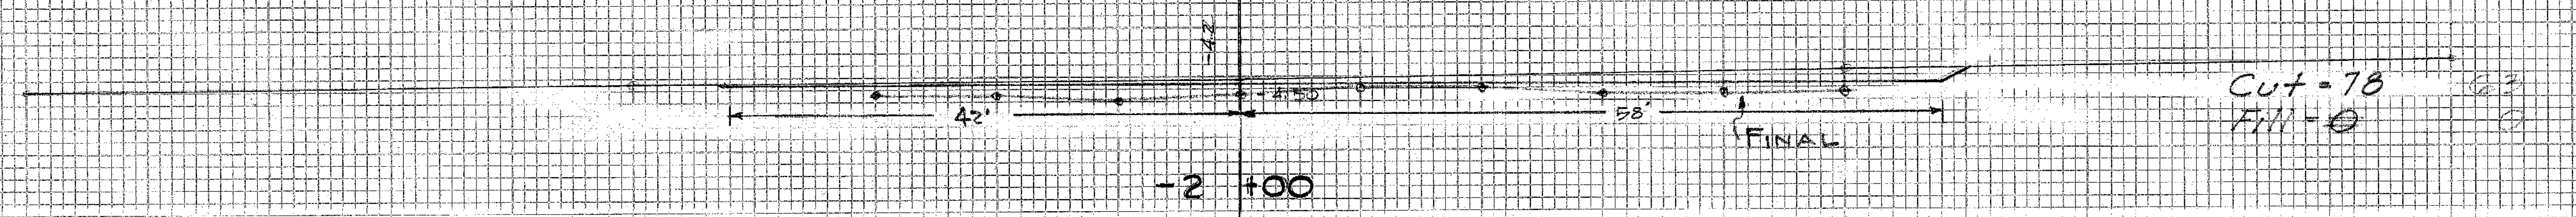

-2 +00

Cut = 78 63
Fill = 0 0

PLATE 3-CROSS SECTION O. P. R. & R. E.
CLEARPRINT PAPER COMPANY, S. F. CAL.
No. 1000H-3

5566.7

FINAL SURVEY
NOTE BOOK
NO.
SURVEYED
PLOTTED
TEMPLATE
AREAS
AREAS CHECKED
BY
DATE

ORIGINAL SURVEY
NOTE BOOK
NO.
SURVEYED
PLOTTED
TEMPLATE
AREAS
AREAS CHECKED
BY
DATE

℄
R/W
27
-4.41
42'
58'
FINAL
Mar. 1952
Exc = ~~2851.9~~ ~~2,887.0~~ 3,207.4
Emb = ~~1383.3~~
7 + 00
Cut = ~~825~~
Fill = ~~317~~
~~C = 846~~
F = 317
C = 891
Rev. Nov. 19, 1951
Rev. Dec. 19, 1951
15
-4.44
FINAL
Mar. 1952
Exc = ~~2940.7~~ ~~3,011.1~~ 3,464.8
Emb = ~~1188.9~~
6 + 00
Cut = ~~715~~
Fill = ~~430~~
~~C = 715~~ C = 841
F = 417
R/W
32
-4.47
Mar. 1952
FINAL
Exc = ~~2531.5~~ ~~2,679.6~~ 2,846.3
Emb = ~~392.6~~
5 + 00
Cut = ~~873~~
Fill = 212
~~C = 917~~ C = 1030
F = 212
20
-4.50
FINAL
Exc = ~~1633.3~~ 1666.7
Emb = 0
4 + 00
Cut = ~~494~~
Fill = 0
C = 507
10
-4.50
FINAL
Exc = ~~1294.4~~ 1,531.5
Emb = 0
3 + 00
Cut = ~~388~~
Fill = 0
C = 393
15
-4.50
FINAL
Exc = ~~961.1~~ 987.0
Emb = 0
2 + 00
Cut = ~~311~~
Fill = 0
C = 326
24
-4.50
42'
58'
FINAL
Exc = ~~690.7~~ 678.6
Emb = 0
1 + 00
Cut = ~~208~~
Fill = 0
C = 207
100

PLATE 3-CROSS SECTION O. P. R. & R. E.
CLEARPRINT PAPER COMPANY, S. F. CAL.
No. 1000H-3

5566.8

Feb. 1952
Mar. 1952
May 1952
FINAL
-4.20
42'
58'
Exc-~~2761.1~~ 2,835.2
Emb-~~136.3~~
14+00
Cut=~~628~~ C=642
Fill=~~450~~ F=423
Rev. Nov. 19, 1951
Rev. Dec. 19, 1951
-4.23
Feb. 1952
Mar. 1952
FINAL
Exc=~~3564.8~~ 3,404.4
Emb-~~772.2~~
13+00
Cut=863 C=832
Fill=236 F=272
Feb. 1952
-4.26
Mar. 1952
FINAL
Exc=~~3975.9~~ 4,161.1
Emb=~~614.8~~
12+00
Cut=~~1062~~ C=1156
Fill=~~131~~ F=115
Feb. 1952
-4.29
Mar. 1952
FINAL
Exc-~~4148.1~~ 4,292.6
Emb-~~618.5~~
11+00
Cut=~~1085~~ C=1141
Fill=~~201~~ F=186
Feb. 1952
-4.32
Mar. 1952
FINAL
Exc=~~3987.0~~ 4,088.9
Emb=~~598.1~~
10+00
Cut=~~1155~~ C=1177
Fill=~~133~~ F=122
Feb. 1952
-4.35
Mar. 1952
FINAL
Exc=~~3493.1~~ 3,607.4
Emb=~~851.9~~
9+00
Cut=~~998~~ C=1031
Fill=~~190~~ F=168
Feb. 1952
-4.50
42'
58'
Mar. 1952
FINAL
Exc=~~3177.8~~ ~~[illegible]~~ 3,348.1
Emb=~~1087.0~~
8+00
Cut=~~891~~ C=917
Fill=~~270~~ F=265
R/W
FINAL SURVEY
ORIGINAL SURVEY
SURVEYED
PLOTTED
TEMPLATE
AREAS
AREAS CHECKED
NOTE BOOK NO.
BY
DATE
50
100

PLATE 3 - CROSS SECTION O. P. R. & R. E.
CLEARPRINT PAPER COMPANY, S. F. CAL.
No. 1000H-3

5566.9

End Transition Left
4:1 Slope
4:1 Slope
End Transition Right
Rev. Nov. 19, 1951
Rev. Dec. 19, 1951
Exc = ~~2766.7~~ ~~[illegible]~~ 2,468.5
Emb = ~~1042.6~~
Cut = ~~764~~ ~~C = [illegible]~~ C = 699
Fill = ~~236~~ ~~F = [illegible]~~
-3.06
38'
31'
Mar. 1952
May, 1952
FINAL
22+00
3:1 Slope
3.6:1 Slope
-3.99
40'
41.2'
Mar. 1952
May, 1952
FINAL
Exc = ~~2746.3~~ ~~[illegible]~~ 2525.9
Emb = ~~911.1~~
Cut = ~~730~~ ~~C = [illegible]~~ C = 634
Fill = ~~217~~ ~~F = [illegible]~~
21+00
2:1 Slope
3.2:1 Slope
-4.02
42'
45.4'
May, 1952
Mar. 1952
FINAL
Beg. Transition Left
Exc = ~~3622.2~~ ~~[illegible]~~ 3,500.0
Emb = ~~512.9~~
Cut = ~~753~~ ~~C = [illegible]~~ C = 730
Fill = ~~215~~ ~~F = [illegible]~~
20+00
2.9:1 Slope
-4.05
42'
49.6'
FINAL
Mar. 1952
Exc = ~~4072.2~~ ~~[illegible]~~ 4033.3
Emb = ~~527.8~~
Cut = ~~1203~~ ~~C = [illegible]~~ C = 1160
Fill = ~~62~~ ~~F = [illegible]~~
19+00
2.4:1 Slope
Feb. 1952
Mar. 1952
-4.08
42'
53.8'
May, 1952
FINAL
Exc = ~~3446.3~~ ~~[illegible]~~ 3605.6
Emb = ~~1042.6~~
Cut = ~~996~~ ~~C = [illegible]~~ C = 1018
Fill = ~~223~~ ~~F = [illegible]~~
18+00
2:1 Slope
Mar. 1952
Feb. 1952
-4.11
58'
FINAL
May, 1952
Beg. Transition Right
Cut = ~~865~~
Fill = ~~340~~
17+00
Exc = ~~3061.1~~
Emb = ~~1329.6~~
Feb. 1952
-4.14
42'
58'
Mar. 1952
May, 1952
FINAL
Exc = ~~2568.5~~
Emb = ~~1575.9~~
Cut = ~~788~~
Fill = ~~378~~
16+00
Feb. 1952
-4.17
42'
58'
May, 1952
Mar. 1952
FINAL
Exc = ~~2272.2~~
Emb = ~~1709.3~~
Cut = ~~599~~
Fill = ~~473~~
15+00
R/W

PLATE 3 - CROSS SECTION O. P. R. & R. E.
CLEARPRINT PAPER COMPANY, S. F. CAL.
No. 1000H-3

5566.10

℄
R/W
R/W
Jan. 1952
-3.18
38'
37'
Mar. 1952
Apr. 1952
FINAL
28+00
Exc = ~~1877.8~~ ~~[illegible]~~ 1821.3
Emb = ~~125.9~~
Cut = ~~1040~~ C = ~~[illegible]~~ C = 1,003
Fill = ~~64~~ F = ~~[illegible]~~
-3.80
27+50
Exc = ~~1763.0~~ ~~[illegible]~~ 1715.7
Emb = ~~174.1~~
Cut = ~~988~~ C = ~~[illegible]~~ C = 964
Fill = ~~72~~ F = ~~[illegible]~~
Feb. 1952
-3.81
27+00
Mar. 1952
Apr. 1952
FINAL
Exc = ~~3333.3~~ ~~[illegible]~~ 3235.2
Emb = ~~496.3~~
Cut = ~~917~~ C = ~~[illegible]~~ C = 889
Fill = ~~116~~ F = ~~[illegible]~~
Feb. 1952
-3.84
Apr. 1952
26+00
FINAL
Mar. 1952
Exc = ~~3066.7~~ ~~[illegible]~~ 2942.6
Emb = ~~798.9~~
Cut = ~~883~~ C = ~~[illegible]~~ C = 858
Fill = ~~152~~ F = ~~[illegible]~~
Feb. 1952
-3.87
Apr. 1952
May 1952
25+00
Mar. 1952
FINAL
Exc = ~~2816.7~~ ~~[illegible]~~ 2683.3
Emb = ~~922.2~~
Cut = ~~773~~ C = ~~[illegible]~~ C = 731
Fill = ~~247~~ F = ~~[illegible]~~
Feb. 1952
-3.90
Mar. 1952
24+00
May, 1952
FINAL
Exc = ~~2777.8~~ ~~[illegible]~~ 2653.7
Emb = ~~925.9~~
Cut = ~~746~~ C = ~~[illegible]~~ C = 718
Fill = ~~251~~ F = ~~[illegible]~~
Feb. 1952
-3.93
38'
37'
23+00
May, 1952
Mar. 1952
FINAL
Exc = ~~2807.4~~ ~~[illegible]~~ 2618.5
Emb = ~~990.7~~
Cut = ~~752~~ C = ~~[illegible]~~ C = 715
Fill = ~~249~~ F = ~~[illegible]~~
150
100
50
FINAL SURVEY
NOTE BOOK
NO.
SURVEYED
PLOTTED
TEMPLATE
AREAS
AREAS CHECKED
BY
DATE
ORIGINAL SURVEY
NOTE BOOK
NO.
SURVEYED
PLOTTED
TEMPLATE
AREAS
AREAS CHECKED
BY
DATE

Revised Nov. 19, 1951
Revised Dec. 19, 1951

PLATE 3 - CROSS SECTION O. P. R. & R. E.
CLEARPRINT PAPER COMPANY, S. F. CAL.
No. 1000H-3

5566.11

Revised Nov. 19, 1951
Revised Dec. 19, 1951

℄
R/W
R/W
6.6
-3.93
Jan. 1952
33'
31'
FINAL
33+00
6.2
4:1 Slope
Jan. 1952
-3.99
4:1 Slope
FINAL
Beg. Transition Left
38'
37'
32+00
5.0
Jan. 1952
-3.68
FINAL
31+00
R/W
R/W
6.5
Jan. 1952
-3.72
FINAL
30+00
5.5
Jan. 1952
-3.74
29+50
5.5
-3.75
Jan. 1952
FINAL
Apr. 1952
29+00
R/W
R/W
5.1
-3.77
Jan. 1952
38'
37'
28+50
150
100
50

33+00
Exc = ~~4509.3~~ ~~[illegible]~~ 4164.8
Emb = ~~125.9~~
Cut = ~~1244~~ C = ~~[illegible]~~ C = 1134
Fill = ~~34~~ F = ~~4~~

32+00
Exc = ~~5924.1~~ ~~[illegible]~~ 4083.3
Emb = ~~137.0~~
Cut = ~~1191~~ C = ~~[illegible]~~ C = 1115
Fill = 34 F = ~~4~~

31+00
Exc = ~~5629.6~~ ~~[illegible]~~ 3193.0
Emb = ~~137.0~~
Cut = ~~2008~~ C = ~~[illegible]~~ C = 1090
Fill = ~~40~~ F = ~~4~~

30+00
Exc = ~~1926.9~~ ~~[illegible]~~ 1900.0
Emb = ~~69.4~~
Cut = ~~1032~~ C = ~~[illegible]~~ C = 1023
Fill = ~~34~~ F = ~~4~~

29+50
Exc = ~~1904.6~~ ~~[illegible]~~ 1888.9
Emb = ~~89.8~~
Cut = ~~1049~~ C = ~~[illegible]~~ C = 1029
Fill = ~~41~~ F = ~~4~~

29+00
Exc = ~~1896.3~~ ~~[illegible]~~ 1866.1
Emb = ~~93.5~~
Cut = ~~1008~~ C = ~~[illegible]~~ C = 1011
Fill = ~~56~~ F = ~~4~~

28+50
Exc = ~~1925.9~~ ~~[illegible]~~ 1878.7
Emb = ~~100.9~~
Cut = ~~1040~~ C = ~~[illegible]~~ C = 1026
Fill = ~~45~~ F = ~~34~~

FINAL SURVEY		BY	DATE
NOTE BOOK	SURVEYED		
	PLOTTED		
	TEMPLATE		
NO.	AREAS		
	AREAS CHECKED		

ORIGINAL SURVEY		BY	DATE
NOTE BOOK	SURVEYED		
	PLOTTED		
	TEMPLATE		
NO.	AREAS		
	AREAS CHECKED		

PLATE 3 - CROSS SECTION O. P. R. & R. E.
CLEARPRINT PAPER COMPANY, S. F. CAL.
No. 1000H-3

5566.12

FINAL SURVEY
NOTE BOOK
NO.
SURVEYED
PLOTTED
TEMPLATE
AREAS
AREAS CHECKED
BY
DATE

ORIGINAL SURVEY
NOTE BOOK
NO.
SURVEYED
PLOTTED
TEMPLATE
AREAS
AREAS CHECKED
BY
DATE

R/W
℄
-3.42
13'
37'
Exc-~~4931.5~~ 3827.8
Emb-~~94.4~~
40+00
Cut-~~1195~~ C-
Fill-~~51~~ F-
Rev. 11/19/51
Rev. 12/19/51
C=877
B R I D G E
-3.43
Exc-~~5375.9~~ 4474.1
Emb-~~209.3~~
39+00
Cut-~~1468~~ C-~~1,404~~ C=1190
Fill-0 F- 0
-3.48
Exc-~~5114.8~~ 4227.8
Emb-~~327.8~~
38+00
Cut-~~1435~~ C- C=1226
Fill-~~113~~ F-
R/W
-3.51
13'
37'
Exc-~~4831.5~~ 3905.6
Emb-~~190.7~~
End Transition Left
37+00
Cut-~~1327~~ C- C=1057
Fill-~~64~~ F-
Note: Hold Bridge Section - 13' left and 37' right
Jan. 1952
-3.54
18'
37'
FINAL
Exc-~~4674.1~~ 3896.3
Emb-~~133.3~~
36+00
Cut-~~1282~~ C- C=1052
Fill-~~39~~ F-
Jan. 1952
-3.57
28'
37'
FINAL
Exc-~~4574.1~~ 3977.8
Emb-~~133.3~~
35+00
Cut-~~1242~~ C- C=1052
Fill-~~33~~ F-
R/W
Jan. 1952
-3.60
28'
37'
FINAL
Exc-~~4577.8~~ 4129.6
Emb-~~135.2~~
34+00
Cut-~~1228~~ C- C=1096
Fill-~~39~~ F-

PLATE 3 - CROSS SECTION O. P. R. & R. E.
CLEARPRINT PAPER COMPANY, S. F. CAL.
No. 1000H-3

5566.13

R/W
Feb. 1952
Jan. 1952
FINAL
Mar. 1952
13'
31'
-3.35
Exc ~~2911.1~~ ~~4,061.1~~ ~~4222.2~~ 4,374.1
Emb ~~118.5~~
47+00
Cut ~~819~~ ~~C = 1,142~~
Fill 31 ~~F = 41~~
~~C = 1,199~~
C = 1232
Rev. Nov. 19, 1951
Rev. Dec. 19, 1951
Jan. 1952
Mar. 1952
FINAL
Feb. 1952
-3.36
Exc ~~2705.5~~ ~~3,853.7~~ ~~3990.7~~
4,138.9
Emb ~~122.2~~
46+00
Cut ~~753~~
Fill ~~33~~
~~C = 1,051~~ ~~C = 1,081~~
~~F = 10~~
C = 1130
Jan. 1952
FINAL
Feb. 1952
Mar. 1952
-3.37
Sta. 45+00
3 - 24" Std Strength
Reinf. Conc. Culvt Pipes.
Exc ~~2053.3~~ ~~3,801.5~~ ~~3940.7~~ 4,100.0
Emb ~~138.8~~
45+00
Cut ~~708~~
Fill ~~33~~
Ditch
~~C = 1,030~~
~~F = 10~~
~~C = 1,074~~
C = 1,105
Jan. 1952
Feb. 1952
-3.38
Exc ~~1935.2~~ ~~3,617.2~~ ~~3727.8~~ 3,927.8
Emb ~~138.8~~
44+00
Cut ~~404~~
Fill ~~42~~
C = 1103
~~C = 1,054~~
~~F = 10~~
Jan. 1952
Feb. 1952
-3.39
Exc ~~2312.9~~ ~~3,445.1~~ ~~3470.4~~ 3,568.5
Emb ~~122.2~~
43+00
Cut ~~641~~
Fill ~~35~~
C = 1012
~~C = 959~~
~~F = 11~~
Jan. 1952
Feb. 1952
-3.40
Exc ~~2470.4~~ ~~3,117.9~~ 3153.7
Emb ~~135.2~~
42+00
Cut ~~608~~
Fill ~~33~~
C = 915
~~F = 11~~
R/W
-3.41
13'
31'
-3.98
Exc ~~3557.4~~ ~~3,924.1~~ 3083.3
Emb ~~168.5~~
41+00
Cut ~~726~~
Fill ~~40~~
C = 788
FINAL SURVEY
NOTE BOOK
NO.
SURVEYED
PLOTTED
TEMPLATE
AREAS
AREAS CHECKED
BY
DATE
ORIGINAL SURVEY
NOTE BOOK
NO.
SURVEYED
PLOTTED
TEMPLATE
AREAS
AREAS CHECKED
BY
DATE

PLATE 3 - CROSS SECTION O. P. R. & R. F.
CLEARPRINT PAPER COMPANY, S. F. CAL.
No. 1000H-3

5566.14

FINAL SURVEY
NOTE BOOK
NO.

	BY	DATE
SURVEYED		
PLOTTED		
TEMPLATE		
AREAS		
AREAS CHECKED		

ORIGINAL SURVEY
NOTE BOOK
NO.

	BY	DATE
SURVEYED		
PLOTTED		
TEMPLATE		
AREAS		
AREAS CHECKED		

R/W
Feb. 1952
-3.28
FINAL
13'
37'
Mar. 1952
Fill = 32
C = 1229
Rev. Nov. 19, 1951
Rev. Dec. 19, 1951
Exc = ~~3007.4~~ ~~4,[illegible]~~ 4761.1
Emb = ~~120.4~~
54+00
Feb. 1952
Jan. 1952
-3.29
Cut = 856
Fill = 33
C = ~~1,20[illegible]~~ C = 1342
F = ~~7~~
FINAL
Exc = ~~3102.6~~ ~~4,[illegible]~~ 5057.4
Emb = ~~122.2~~
53+00
Jan. 1952
Feb. 1952
-3.30
Cut = 868
Fill = 33
C = ~~1,24[illegible]~~ C = 1,389
F = ~~7~~
Mar. 1952
FINAL
Exc = ~~3150.0~~ ~~4,[illegible]~~ 5007.4
Emb = ~~122.2~~
52+00
Jan. 1952
Feb. 1952
-3.31
Cut = 833
Fill = 33
C = ~~1,[illegible]~~ C = 1,315
F = ~~7~~
Mar. 1952
FINAL
Exc = ~~3120.4~~ ~~4,[illegible]~~ 4890.7
Emb = ~~120.4~~
51+00
Jan. 1952
Feb. 1952
-3.32
852
Fill = 32
C = ~~1,[illegible]~~ C = 1,326
F = ~~7~~
FINAL
Mar. 1952
Exc = ~~2998.1~~ ~~4,[illegible]~~ ~~4600.0~~ 4,700.0
Emb = ~~114.8~~
50+00
Jan. 1952
Feb. 1952
-3.33
Cut = 767
Fill = 30
C = ~~1,109~~ ~~C = 1,158~~
F = ~~7~~ C = 1212
Mar. 1952
FINAL
Exc = ~~2855.5~~ ~~4,[illegible]~~ ~~4305.6~~ 4,501.8
Emb = ~~114.8~~
49+00
R/W
Jan. 1952
Feb. 1952
-3.34
Cut = 775
Fill = 32
C = ~~1,[illegible]~~ ~~C = 1,167~~
F = ~~7~~ C = 1210
13'
31'
FINAL
Mar. 1952
Exc = ~~2951.8~~ ~~4,[illegible]~~ ~~4381.5~~ 4,538.9
Emb = ~~116.6~~
48+00

PLATE 3 - CROSS SECTION O. P. R. & R. E.
CLEARPRINT PAPER COMPANY, S. F. CAL.
No. 1000H-3

5566.15

FINAL SURVEY
NOTE BOOK
NO.

	BY	DATE
SURVEYED		
PLOTTED		
TEMPLATE		
AREAS		
AREAS CHECKED		

ORIGINAL SURVEY
NOTE BOOK
NO.

	BY	DATE
SURVEYED		
PLOTTED		
TEMPLATE		
AREAS		
AREAS CHECKED		

℄
R/W
Rev. Nov. 19, 1951
~~Rev. Dec. 19, 1951~~
Exc = ~~1801.8~~ ~~2,750.0~~ 2724.1
Emb = ~~133.3~~
Feb. 1952
-3.21
13'
37'
FINAL
61+00
Apr. 1952
Mar. 1952
Cut = ~~491~~
Fill = ~~51~~
C = ~~750~~ C = 749
F = ~~50~~
Exc = ~~1077.8~~ ~~2,985.2~~ ~~2979.6~~ 3,031.5
Emb = ~~151.8~~
Feb. 1952
-3.22
Apr. 1952
60+00
Mar. 1952
FINAL
Cut = ~~482~~
Fill = ~~48~~
C = ~~722~~ C = 722
F = ~~17~~
Exc = ~~2172.2~~ ~~3,366.7~~ ~~3300.0~~ 3,485.2
Emb = ~~125.9~~
Feb. 1952
-3.23
FINAL
59+00
Mar. 1952
Cut = ~~586~~
Fill = ~~34~~
C = ~~877~~ ~~C = 887~~
F = ~~11~~
C = 915
Exc = ~~2288.8~~ ~~3,555.0~~ ~~3457.4~~ 3,687.0
Emb = ~~122.2~~
Feb. 1952
-3.24
58+00
Mar. 1952
FINAL
Cut = ~~587~~
Fill = ~~34~~
C = ~~887~~ ~~C = 895~~
F = ~~11~~
C = 967
Exc = ~~2366.7~~ ~~3,438.3~~ ~~3548.1~~ 3,750.0
Emb = ~~120.4~~
Feb. 1952
-3.25
FINAL
57+00
Mar. 1952
Cut = ~~649~~
Fill = ~~32~~
C = ~~944~~ ~~C = 972~~
F = ~~10~~
C = 1024
Exc = ~~2490.7~~ ~~3,659.7~~ ~~3727.8~~ 3,913.0
Emb = ~~124.1~~
Feb. 1952
-3.26
56+00
Mar. 1952
Cut = ~~629~~
Fill = ~~33~~
C = ~~944~~ ~~C = 944~~
F = ~~10~~
C = 1001
R/W
Exc = ~~2718.1~~ ~~4,032.0~~ ~~4255.6~~ 4,335.2
Emb = ~~122.2~~
Jan. 1952
Feb. 1952
Mar. 1952
-3.27
13'
37'
55+00
Cut = ~~716~~
Fill = ~~34~~
C = ~~1,044~~ ~~C = 1069~~
F = ~~8~~
C = 1112

PLATE 3 - CROSS SECTION O. P. R. & R. E.
CLEARPRINT PAPER COMPANY, S. F. CAL.
No. 1000H-3

5566.16

Rev. Nov. 19, 1951
Rev. Dec. 19, 1951

℄
R/W
Exc = ~~2205.8~~ ~~[illegible]~~ 3126.0
Emb = ~~146.2~~
-3.15
13'
37'
FINAL
67 +01.20
Cut = ~~621~~
Fill = ~~36~~
C = ~~[illegible]~~ C = 879
F = ~~[illegible]~~
R/W
Mar. 1952
Exc = ~~2027.7~~ ~~[illegible]~~ 2950.0
Emb = ~~140.7~~
-3.16
FINAL
Apr. 1952
66 +00
Cut = ~~556~~
Fill = ~~42~~
C = ~~[illegible]~~ C = 789
F = ~~[illegible]~~
R/W
Mar. 1952
Exc = ~~1990.7~~ ~~[illegible]~~ 3007.4
Emb = ~~198.9~~
-3.17
FINAL
Apr. 1952
65 +00
Cut = ~~539~~
Fill = ~~34~~
C = ~~[illegible]~~ C = 804
F = ~~[illegible]~~
Mar. 1952
Exc = ~~1842.6~~ ~~[illegible]~~ 2861.1
Emb = ~~181.5~~
-3.18
FINAL
Apr. 1952
64 +00
Cut = ~~536~~
Fill = ~~41~~
C = ~~[illegible]~~ C = 820
F = ~~[illegible]~~
Mar. 1952
Exc = ~~1716.6~~ ~~[illegible]~~ 2718.5
Emb = ~~212.9~~
-3.19
FINAL
Apr. 1952
63 +00
Cut = ~~459~~
Fill = ~~57~~
C = ~~[illegible]~~ C = 725
F = ~~[illegible]~~
R/W
R/W
Mar. 1952
Exc = ~~1775.9~~ ~~[illegible]~~ 2763.0
Emb = ~~201.9~~
-3.20
13'
37'
Apr. 1952
FINAL
62 +00
Cut = ~~468~~
Fill = ~~58~~
C = ~~[illegible]~~ C = 743
F = ~~[illegible]~~

FINAL SURVEY
SURVEYED
PLOTTED
TEMPLATE
NOTE BOOK
AREAS
AREAS CHECKED
NO.
BY
DATE

ORIGINAL SURVEY
SURVEYED
PLOTTED
TEMPLATE
NOTE BOOK
AREAS
AREAS CHECKED
NO.
BY
DATE

PLATE 3 - CROSS SECTION O. P. R. & R. E.
CLEARPRINT PAPER COMPANY, S. F. CAL.
No. 1000H-3

5566.17

Exc= ~~1996.3~~ ~~[illegible]~~ 2937.0
Emb= ~~125.9~~
FINAL
13'
37'
-3.08
74+00
Apr. 1952
Cut= ~~550~~
Fill= ~~34~~
C= ~~[illegible]~~
F= ~~[illegible]~~
C= 823
Exc= ~~2020.4~~ ~~[illegible]~~ 2955.6
Emb= ~~122.2~~
FINAL
-3.08
73+00
Apr. 1952
Cut= ~~528~~
Fill= ~~34~~
C= ~~[illegible]~~ C= 763
Exc= ~~2072.2~~ ~~[illegible]~~ 3090.7
Emb= ~~120.4~~
FINAL
-3.10
72+00
Apr. 1952
Cut= ~~563~~
Fill= ~~32~~
C= ~~[illegible]~~ C= 833
Exc= ~~2081.5~~ ~~[illegible]~~ 3159.3
Emb= ~~124.0~~
FINAL
-3.11
71+00
Apr. 1952
Cut= ~~556~~
Fill= ~~33~~
C= ~~[illegible]~~ C= 836
Exc= ~~2146.3~~ ~~[illegible]~~ 3200.0
Emb= ~~125.9~~
-3.12
70+00
Apr. 1952
FINAL
Cut= ~~568~~
Fill= ~~34~~
C= ~~[illegible]~~ C= 870
Sta. 69+40
2-24" Std. Strength Reinf.
Conc. Culvit. Pipes.
Exc= ~~2181.5~~ ~~3211.1~~ 3179.6
Emb= ~~135.2~~
FINAL
-3.13
69+00
Apr. 1952
Cut= ~~531~~
Fill= ~~34~~
Ditch
C= ~~[illegible]~~ C= 858
Exc= ~~2210.2~~ ~~[illegible]~~ 3179.9
Emb= ~~137.2~~
Apr. 1952
-3.14
13'
37'
68+00
FINAL
Cut= ~~587~~
Fill= ~~30~~
C= ~~[illegible]~~ C= 859
R/W

Rev. Nov. 19, 1951
Rev. Dec 19, 1951

PLATE 3 - CROSS SECTION O. P. R. & R. E.
CLEARPRINT PAPER COMPANY, S. F. CAL.
No. 1000H-3

5566.18

FINAL SURVEY NOTE BOOK NO.
SURVEYED
PLOTTED
TEMPLATE
AREAS
AREAS CHECKED
BY
DATE

ORIGINAL SURVEY NOTE BOOK NO.
SURVEYED
PLOTTED
TEMPLATE
AREAS
AREAS CHECKED
BY
DATE

R/W
R/W
Exc= ~~2194.4~~ ~~3,1??.?~~ 3220.4
Emb= ~~124.0~~
-3.01
13'
37'
FINAL
81+00
Cut= ~~570~~ ~~C= 83?~~
Fill= ~~32~~ ~~F= 12~~
C=851
Rev. Nov. 19, 1951
Rev. Dec. 19, 1951
Exc= ~~2196.3~~ ~~3,15?.?~~ 3185.2
Emb= ~~125.9~~
-3.02
FINAL
80+00
Cut= ~~675~~ C= 868 C=888
Fill= ~~35~~ F= 12
Exc= ~~2059.3~~ ~~3,05?.7~~ 3050.0
Emb= ~~122.2~~
-3.03
FINAL
79+00
Cut= ~~571~~ C= ~~8??~~ C=832
Fill= ~~33~~ F= ~~12~~
Exc= ~~2088.8~~ ~~3,09?.?~~ 3135.2
Emb= ~~122.2~~
-3.04
FINAL
78+00
Cut= ~~547~~ C= ~~811~~ C=815
Fill= ~~33~~ F= ~~12~~
Exc= ~~2027.7~~ ~~3,00?.7~~ 3016.7
Emb= ~~129.6~~
-3.05
FINAL
77+00
Cut= ~~587~~ C= ~~8?1~~ C= 878
Fill= ~~33~~ F= ~~12~~
Exc= ~~2022.2~~ ~~2,99?.?~~ 2975.9
Emb= ~~127.7~~
-3.06
FINAL
76+00
Cut= ~~508~~ C= ~~7?1~~ C=751
Fill= ~~37~~ F= ~~12~~
Exc= ~~2100.0~~ R/W ~~3,111.1~~ 3109.3
Emb= ~~122.2~~
-3.07
13'
37'
FINAL
75+00
Cut= ~~584~~ C= ~~8??~~ C=856
Fill= ~~32~~ F= 11

PLATE 3 - CROSS SECTION O. P. R. & R. E.
CLEARPRINT PAPER COMPANY, S. F. CAL.
No. 1000H-3

5566.19

FINAL SURVEY
NOTE BOOK
NO.
SURVEYED
PLOTTED
TEMPLATE
AREAS
AREAS CHECKED
BY
DATE

ORIGINAL SURVEY
NOTE BOOK
NO.
SURVEYED
PLOTTED
TEMPLATE
AREAS
AREAS CHECKED
BY
DATE

℄
Rev. Nov. 19, 1931
Rev. Dec. 19, 1931
R/W
Exc = ~~2279.6~~ 2603.7
Emb = ~~133.3~~
13'
37'
87+00
FINAL
Cut = ~~693~~ C = ~~64~~ C = 635
Fill = ~~33~~ F = 20
R/W
Exc = ~~1003.7~~ 2803.7
Emb = ~~131.5~~
86+00
FINAL
Cut = ~~538~~ C = 771
Fill = 39 F = 26
R/W
Exc = ~~1838.8~~ 2792.6
Emb = ~~120.4~~
85+00
FINAL
Cut = ~~490~~ C = 743
Fill = 32
Exc = ~~1896.3~~ 2903.7
Emb = ~~124.0~~
84+00
FINAL
Cut = ~~503~~ C = 765
Fill = ~~33~~
Exc = ~~1957.4~~ 3035.2
Emb = ~~124.0~~
83+00
FINAL
Cut = ~~521~~ C = 803
Fill = 34
Exc = ~~2048.1~~ 3124.1
Emb = ~~120.4~~
FINAL
13'
37'
82+00
R/W
Cut = ~~536~~ C = 836
Fill = ~~33~~
R/W

PLATE 3 - CROSS SECTION O. P. R. & R. E.
CLEARPRINT PAPER COMPANY, S. F. CAL.
No. 1000H-3

5566.20

℄
93 +00
CUT = 0
FILL = 0
Exc=~~0~~
Emb=~~764.8~~
288' o/s Rt. from ℄
Cut=0
Fill=413
Rev. Nov. 19, 1951
Rev. Dec. 19, 1951
92 +00
Exc=~~0~~
Emb=~~2144.4~~
Match Line
1.5
+1.5
91 +00
Exc=~~570.4~~ ~~[illegible]~~ 233.3
Emb=~~2611.1~~
Cut=0
Fill=~~745~~ F=768
Match Line
2.8
+0.61
13'
37'
FINAL
90 +00
Cut=~~308~~ C=~~[illegible]~~ C=126
Fill=~~665~~ F=~~[illegible]~~
Exc=~~1713.0~~ ~~[illegible]~~ 698.1
Emb=~~2040.7~~
Match Line
3.3
Exc=~~2424.1~~ 1275.2
Emb=~~1068.5~~ ~~[illegible]~~
-0.28
FINAL
89 +00
Cut=~~617~~ C=~~[illegible]~~ C=251
Fill=~~437~~ F=~~[illegible]~~
4.5
1287.0
Exc=~~2564.8~~ ~~[illegible]~~
Emb=~~320.4~~
-1.18
13'
37'
88 +00
FINAL
Cut=~~692~~ C=~~[illegible]~~ C=438
Fill=~~140~~ F=~~[illegible]~~
FINAL SURVEY
SURVEYED
PLOTTED
TEMPLATE
AREAS
AREAS CHECKED
NOTE BOOK
NO.
BY
DATE
ORIGINAL SURVEY
SURVEYED
PLOTTED
TEMPLATE
AREAS
AREAS CHECKED
NOTE BOOK
NO.
BY
DATE

PLATE 3 - CROSS SECTION O. P. R. & R. E.
CLEARPRINT PAPER COMPANY, S. F. CAL.
No. 1000H-3

5566.21