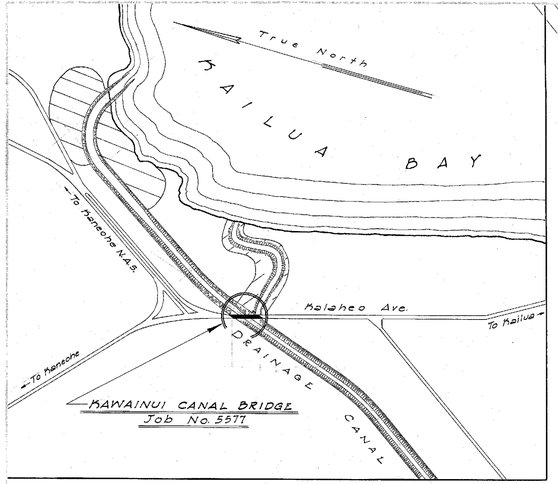

LAYOUT PLAN
Scale: 1" = 800' ±

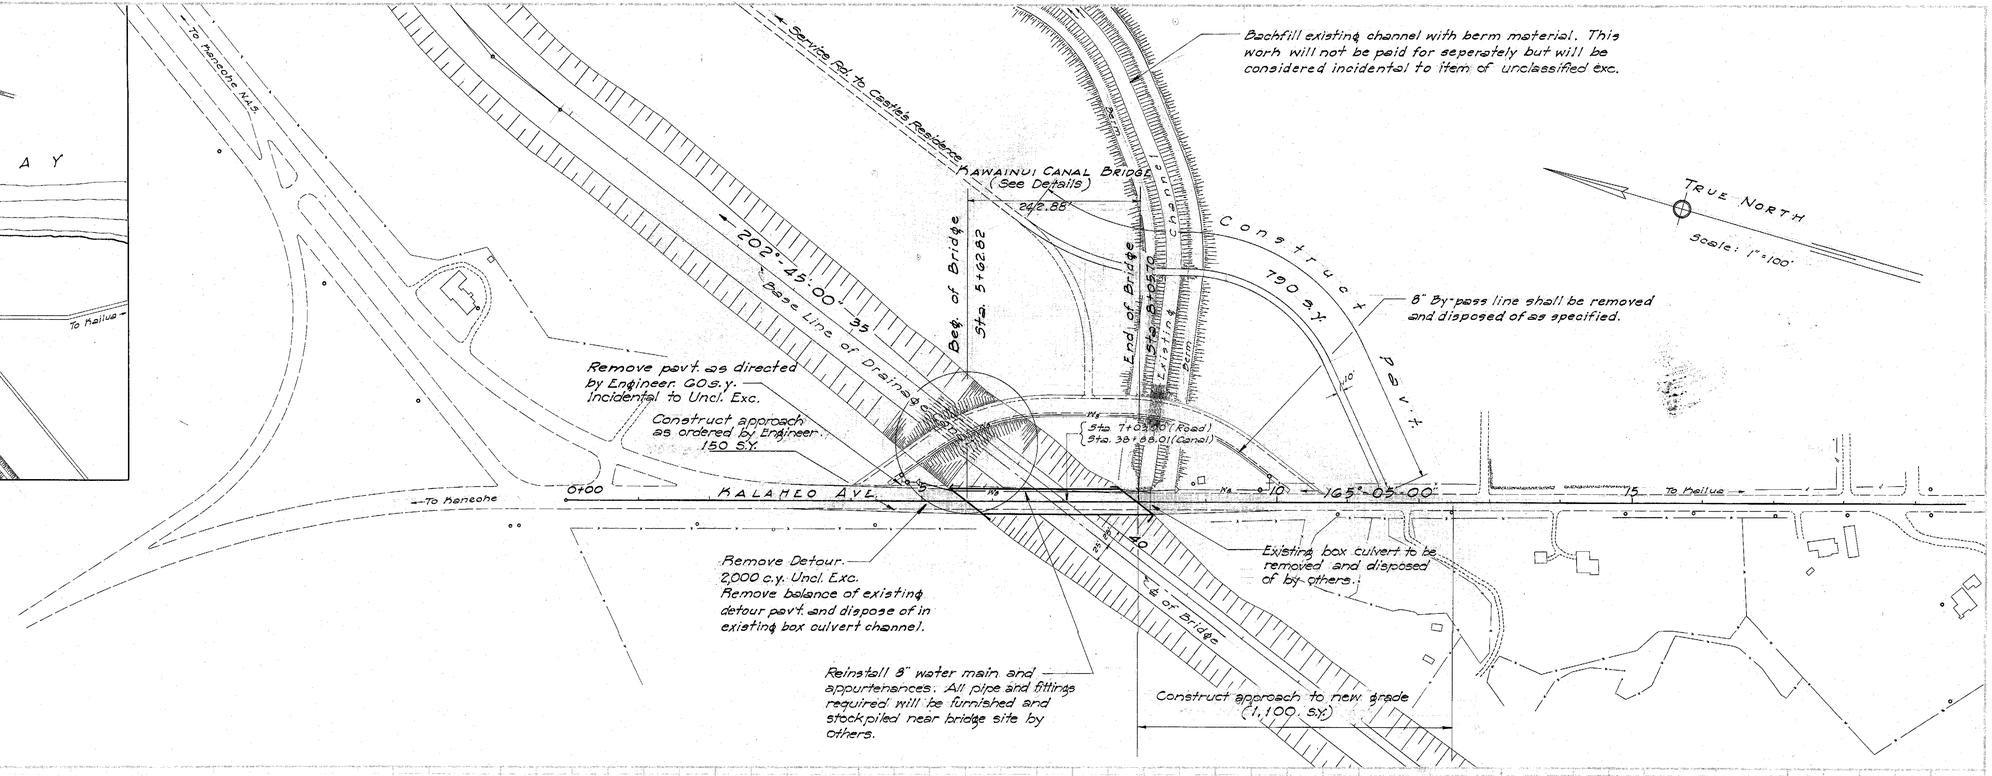

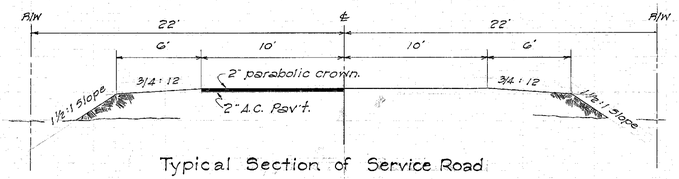

Typical Section of Service Road
Scale: 1" = 5'-0"

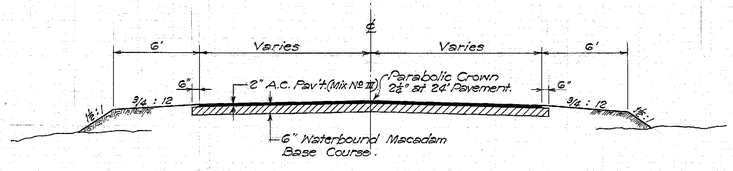

Typical Section of Kalaheo Ave.
Approach to Bridge at Kailua End
Scale: 1" = 5'-0"

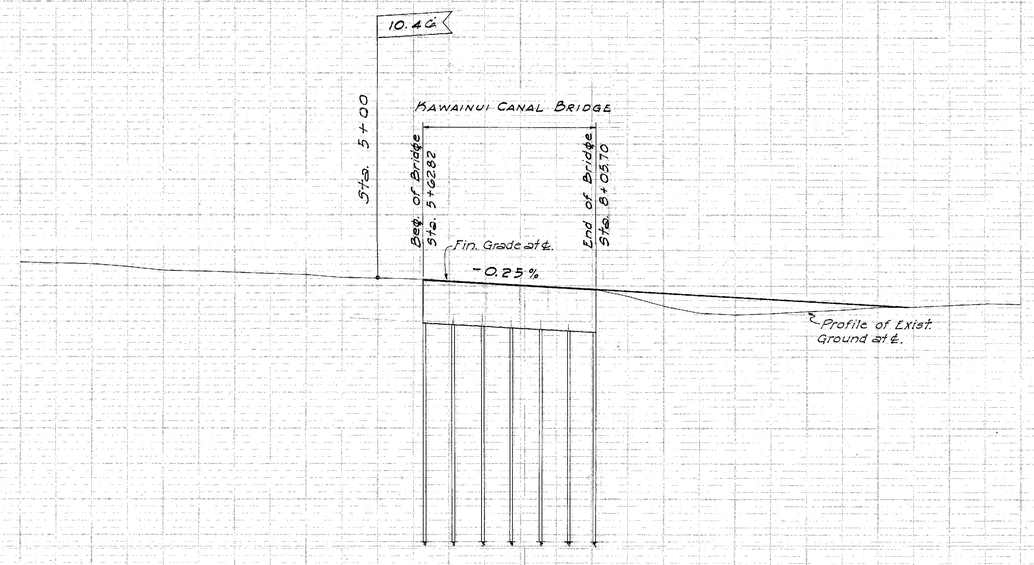

Profile Scales { Hor. 1" = 100'
Vert. 1" = 5'

0 5 10 15

5577.2