FED. ROAD DIST. NO.	STATE	FED. AID PROJ. NO.	FISCAL YEAR	SHEET NO.	TOTAL SHEETS
Hawaii	Hawaii	S216(1)		11	37

Revised Feb. 1950
5-1-51

SEP 20 1951

(16)

CURVE DATA
℄ North Lane
Base Line

Δ = 37° 12'
D = 2°00'
R = 2,864.70'
T = 964.12'
Lc = 1,850.00'

CURVE DATA
℄ South Lane

Δ = 20° 00'
D = 2°00'
R = 2,008.70'
T = 512.00'
Lc = 1,018.36'

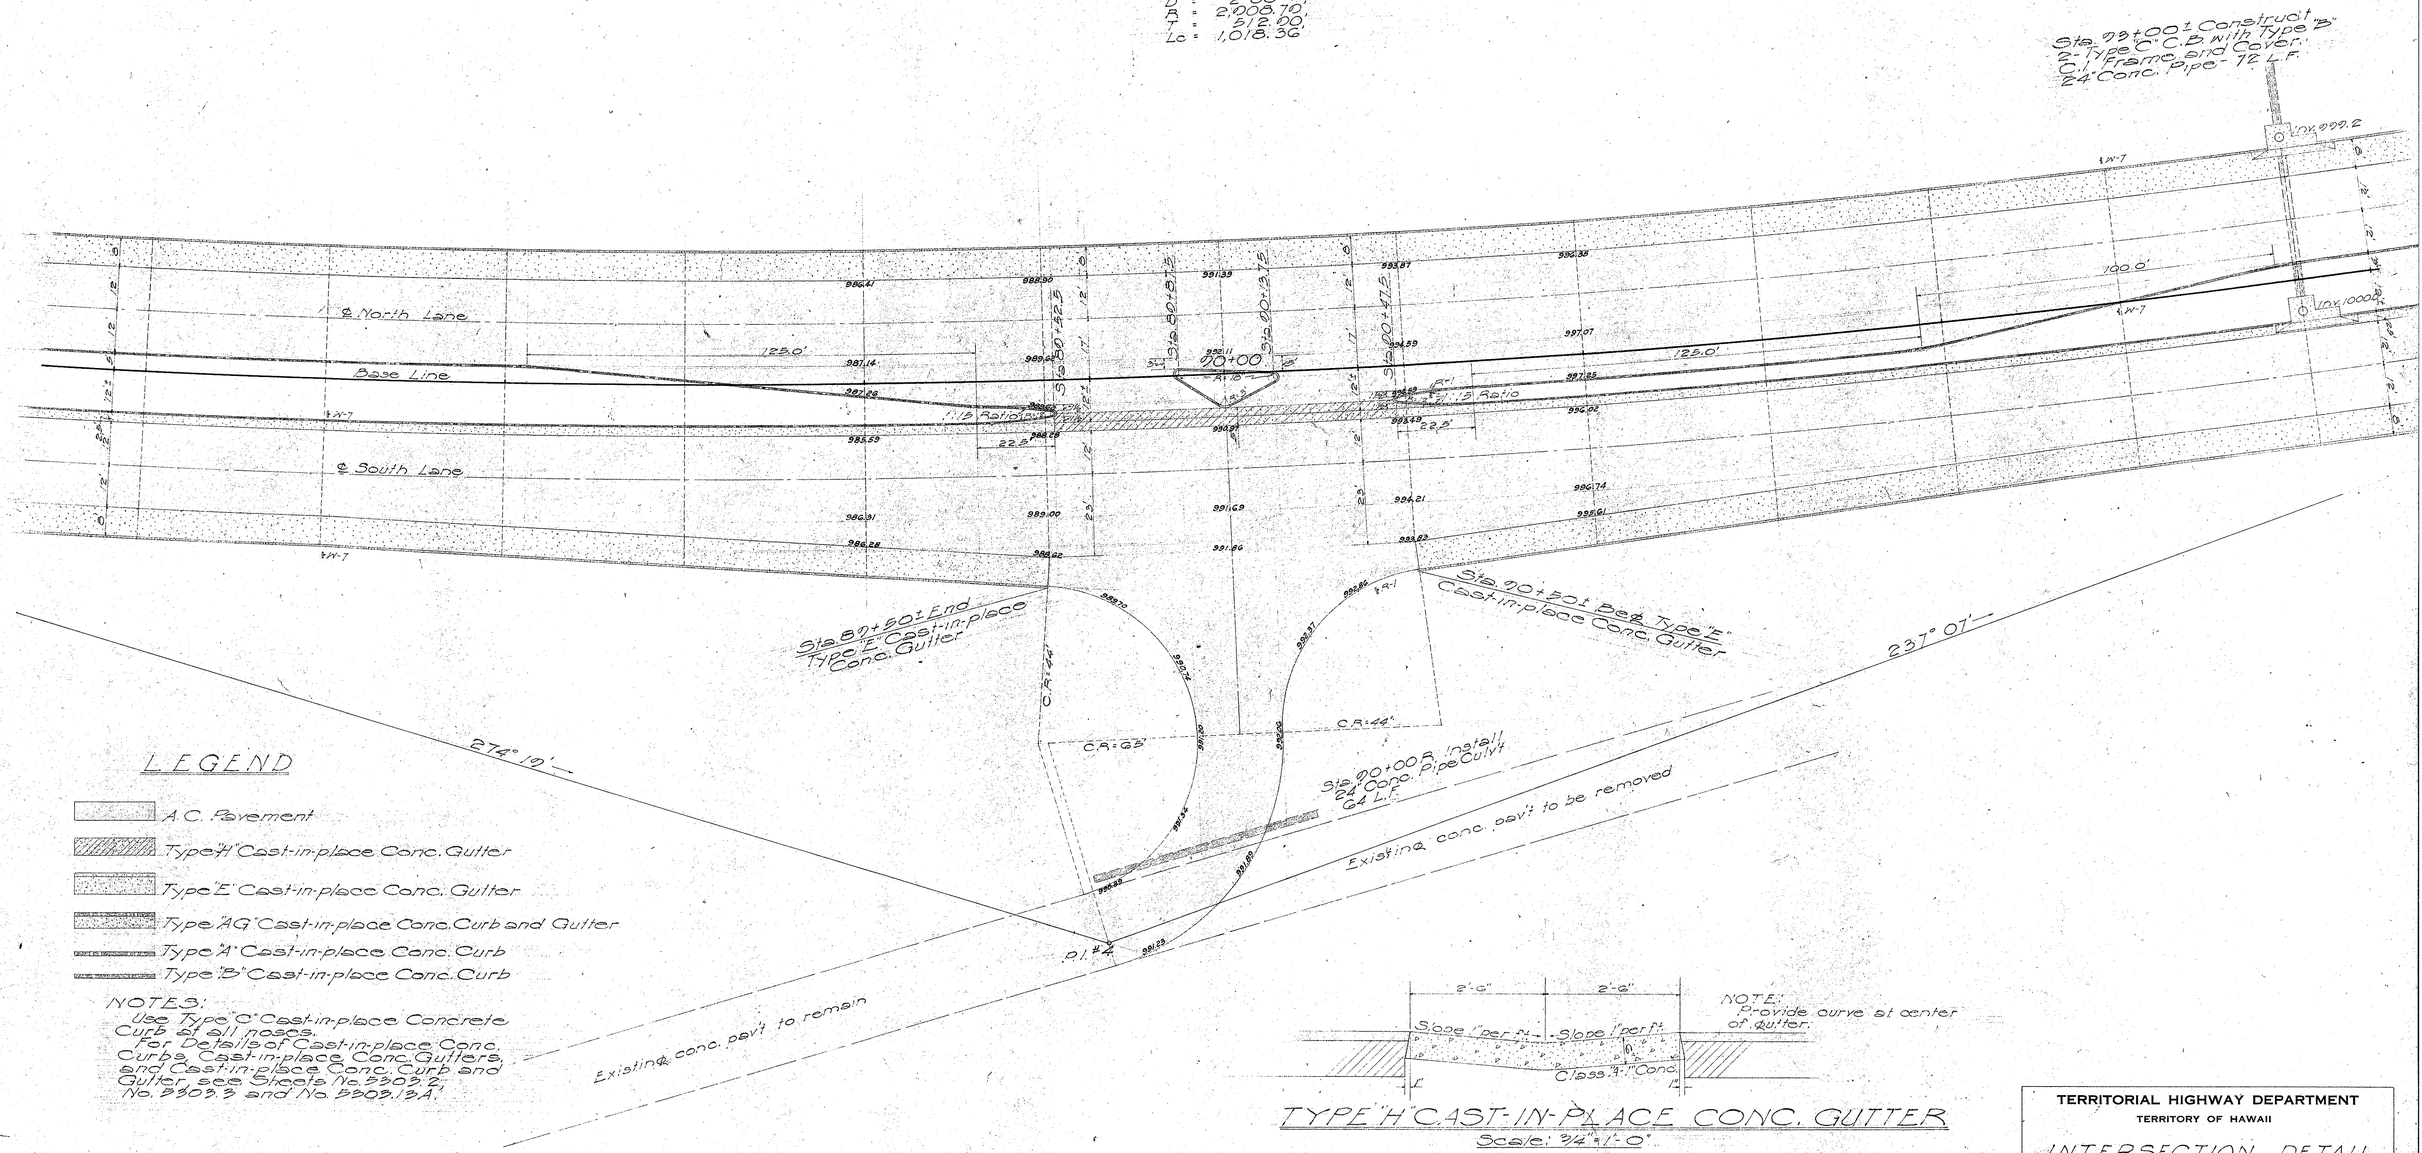

LEGEND

- A.C. Pavement
- Type "H" Cast-in-place Conc. Gutter
- Type "E" Cast-in-place Conc. Gutter
- Type "AG" Cast-in-place Conc. Curb and Gutter
- Type "A" Cast-in-place Conc. Curb
- Type "B" Cast-in-place Conc. Curb

NOTES:
Use Type "C" Cast-in-place Concrete Curb at all noses.
For Details of Cast-in-place Conc. Curbs, Cast-in-place Conc. Gutters, and Cast-in-place Conc. Curb and Gutter, see Sheets No. 5303.2, No. 5303.3 and No. 5303.12A.

TYPE "H" CAST-IN-PLACE CONC. GUTTER
Scale: 3/4" = 1'-0"

ORIGINAL PLAN	
	SURVEY PLOTTED BY ..... DATE
	DESIGNED BY ..... "
	DRAWN BY ..... "
NOTE BOOK No.	TRACED BY ..... "
	TRACINGS CHECKED BY ..... "
	QUANTITIES BY ..... "
	QUANTITIES CHECKED BY ..... "
	CHECKED BY ..... "

TERRITORIAL HIGHWAY DEPARTMENT
TERRITORY OF HAWAII

INTERSECTION DETAIL
STA. 90+00
PALI ROAD
PROJECT NO. S 216(1)

Scale: 1" = 20' Feb. 1950

SHEET No. OF SHEETS

5303.11

"ALBARENE" No. 1957 A.&C.CO., N.Y.