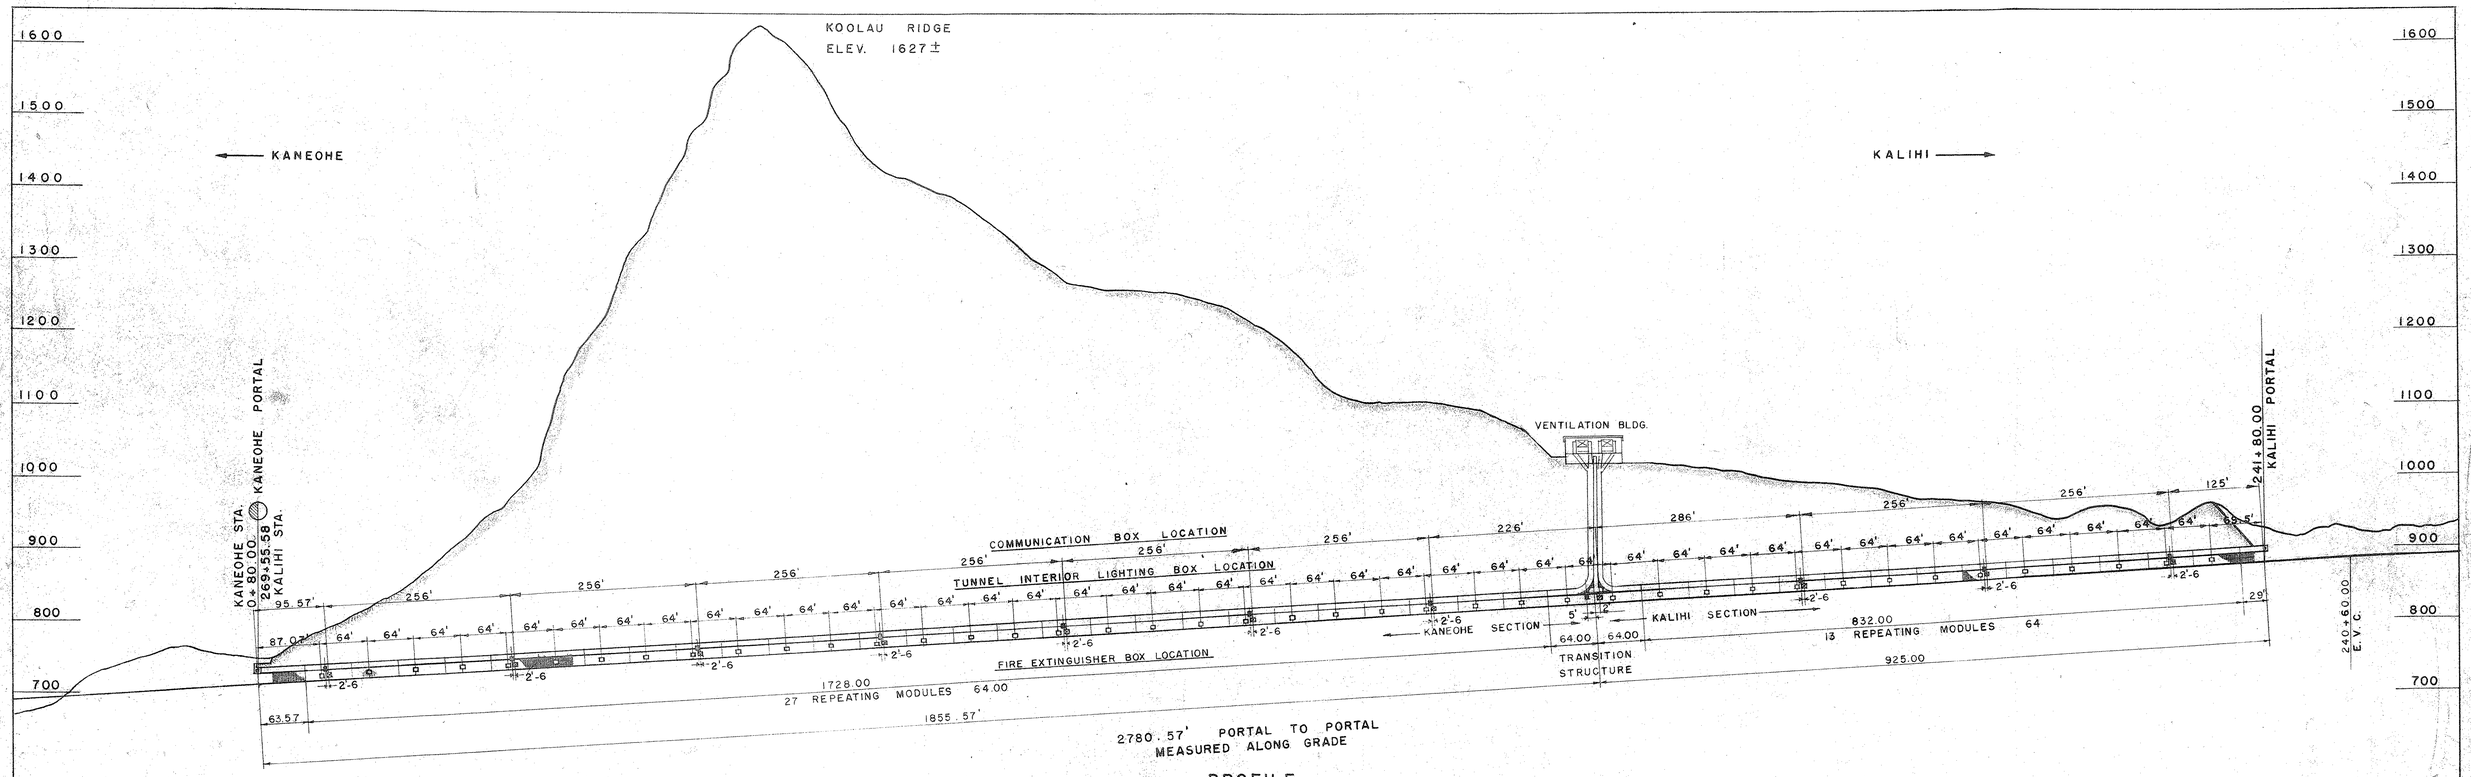

PROFILE

NOTE:
REVERSED VIEW DUE TO ELECTRICAL BOXES ALL ONE SIDE. (RIGHT SIDE)

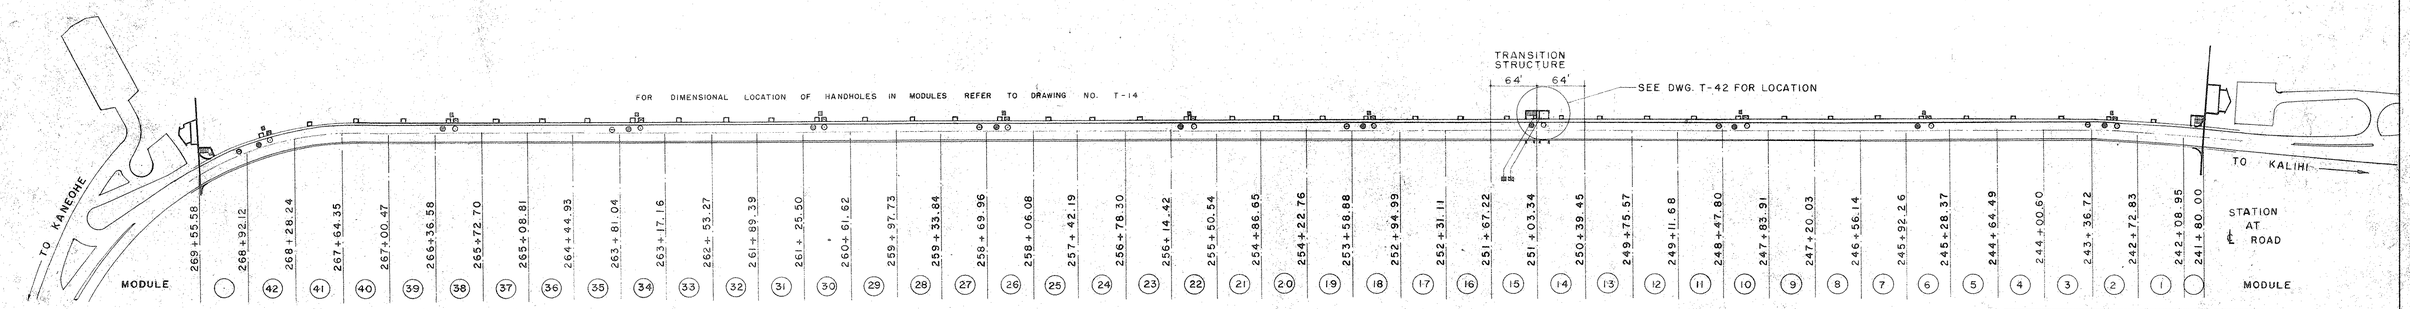

2775.58' PORTAL TO PORTAL
HORIZONTAL DISTANCE

PLAN

NOTE:
LOCATIONS OF FIRE EXTINGUISHER STATIONS (SEE DWGS. T-10 & T-11)
LOCATIONS OF C&C TUNNEL INTERIOR LIGHTING STATIONS (SEE DRAWINGS T-10 & T-11)
LOCATIONS OF C&C TUNNEL COMMUNICATION STATIONS (SEE DRAWINGS T-10 & T-11)
□- TUNNEL INTERIOR LIGHTING BOX (SEE DRAWINGS T-19 & E-8)
⊠- COMMUNICATION BOX (SEE DRAWINGS T-20 & E-9)
○ C&C HANDHOLE (SEE DRAWINGS T-14 & T-15)
● MUTUAL TELEPHONE HANDHOLE (SEE DRAWINGS T-14 & T-15)
⊖ SIGNAL CORPS HANDHOLE (SEE DRAWINGS T-14 & T-15)
▪ FIRE EXTINGUISHER BOX (SEE DWG. T-21)

LAW & WILSON
ARCHITECTS & ENGINEERS

DEPARTMENT OF PUBLIC WORKS
CITY AND COUNTY OF HONOLULU
BUREAU OF PLANS

KALIHI TUNNEL
TUNNEL & SHAFT
KEY PLAN
ELECTRICAL

ENGINEER L & W — DATE JULY 15, 1965
DRAFTSMAN K.N. — CHECKED BY J.O.
SCALE 1" = 100'-0" — TRACER
APPROVED: CHIEF ENGINEER — APPROVED: BUREAU ENGINEER

APPROVED: ENGINEER, KALIHI TUNNEL

W. S.	PROFILE	C. B.
CR. SEC.	F. B.	S. B.
W. M. BY:	F. W. BY:	S. BY:

SECTION C JOB NO. 26-53 DWG. T-3

Sheet No. 81 of 252 Sheets

FILE	POCKET	FOLDER	NO.
7	5	3	3