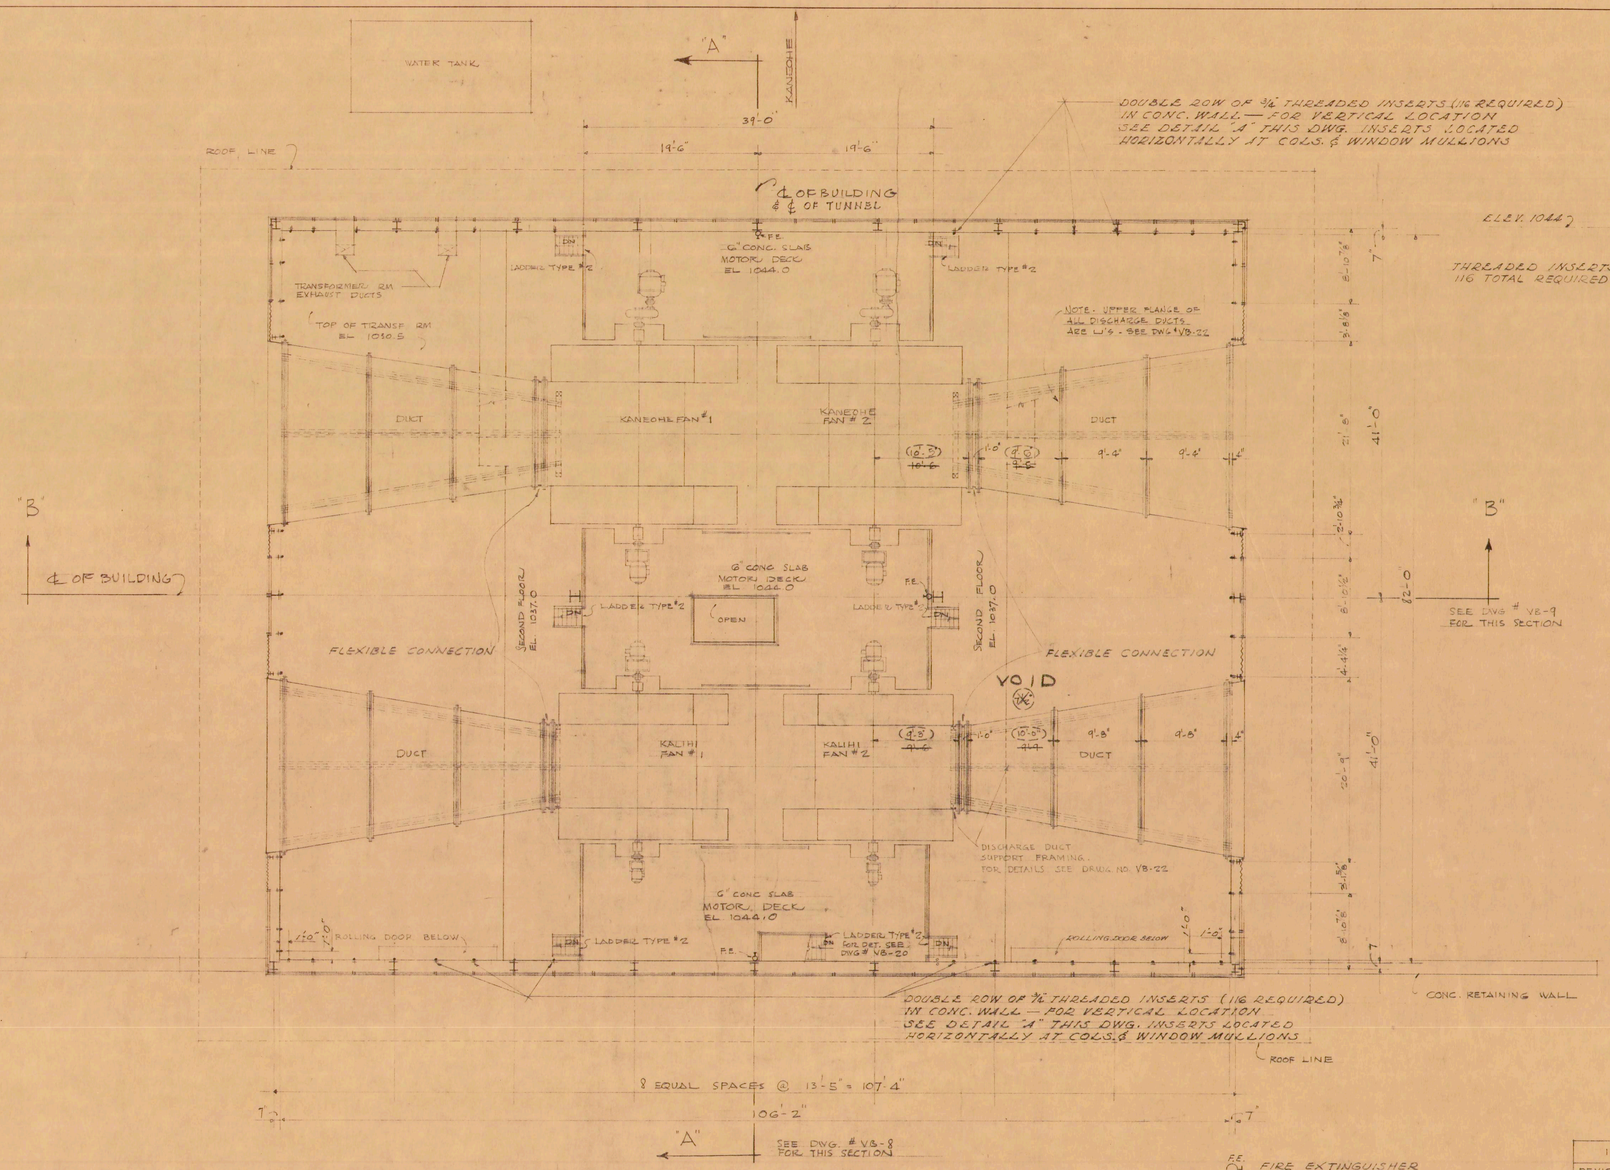

MOTOR DECK PLAN

SCALE: 1/8" = 1'-0"

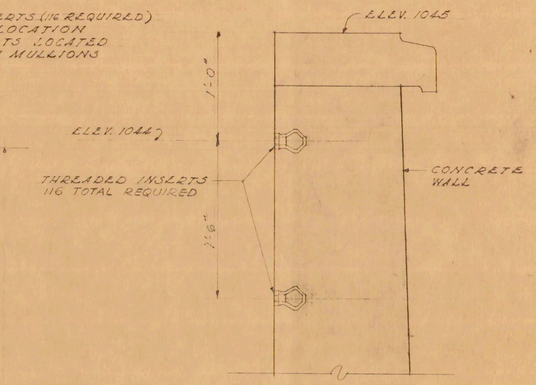

DETAIL "A"

SCALE: 1½" = 1'-0"

NOTE: FOR DETAIL SEE DWG. No. VB-12

NOTE
THREADED WALL INSERTS SHOWN IN DETAIL "A" ARE PROVIDED FOR FUTURE ATTACHMENT OF CATWALKS

REVISION	DATE	DESCRIPTION	MADE BY	CHK. BY
1	4-16-56	RELOCATED OPENINGS & EQUIPMENT	E.N.	

LAW & WILSON
ARCHITECTS & ENGINEERS

DEPARTMENT OF PUBLIC WORKS
CITY AND COUNTY OF HONOLULU
BUREAU OF PLANS

KALIHI TUNNEL
VENTILATION BLDG.
MOTOR DECK FLOOR PLAN

ENGINEER L & W — DATE JULY 16, 1953
DRAFTSMAN P. K — CHECKED BY R. H.
SCALE 1/8" = 1'-0" — TRACER
APPROVED: O. E. Sanwalds, CHIEF ENGINEER — APPROVED: A. W. Bertgins, BUREAU ENGINEER

APPROVED: H. Lueders, ENGINEER, KALIHI TUNNEL

W. S.	PROFILE	C. B.
CH. SEC.	F. B.	S. B.
W. M. BY	F. W. BY	S. BY

SECTION C — JOB NO. 26-53 — DWG. VB-5

FILE	POCKET	FOLDER	NO.
7	6	2	5