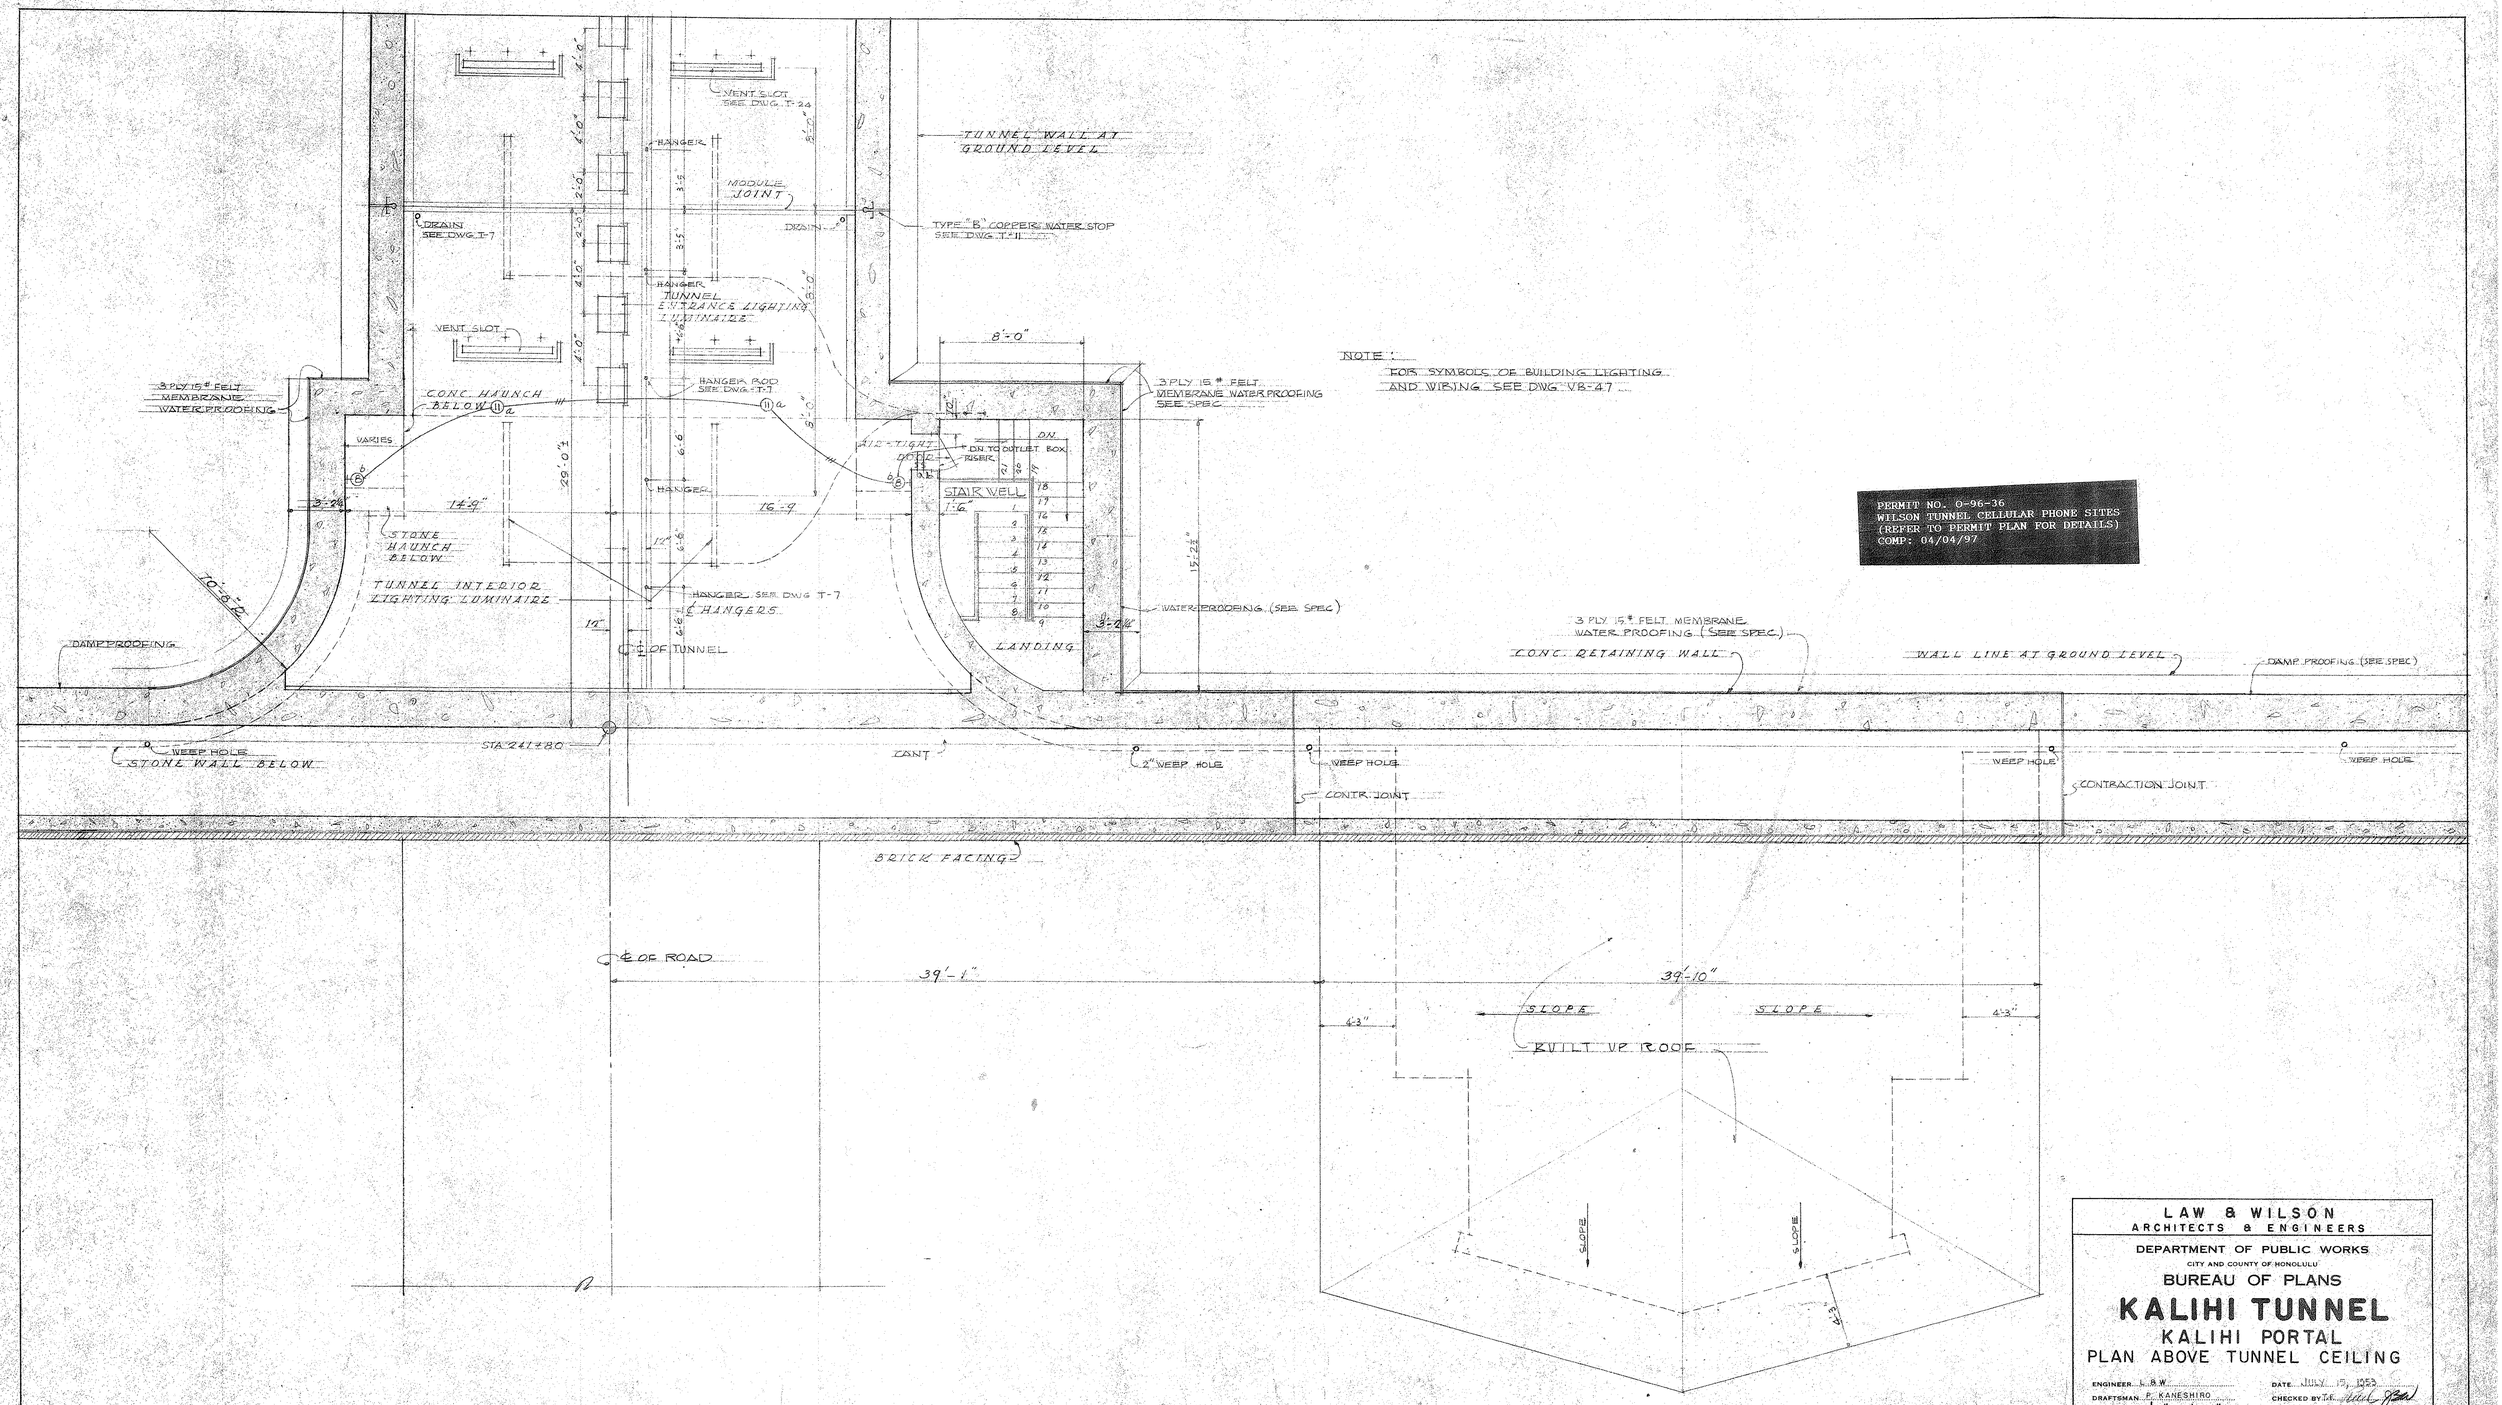

PERMIT NO. 0-96-36
WILSON TUNNEL CELLULAR PHONE SITES
(REFER TO PERMIT PLAN FOR DETAILS)
COMP: 04/04/97

AIR SHAFT FLOOR PLAN - KALIHI PORTAL

SCALE 1/4" = 1'-0"

LAW & WILSON
ARCHITECTS & ENGINEERS

DEPARTMENT OF PUBLIC WORKS
CITY AND COUNTY OF HONOLULU
BUREAU OF PLANS

KALIHI TUNNEL

KALIHI PORTAL
PLAN ABOVE TUNNEL CEILING

ENGINEER L. & W.
DRAFTSMAN F. KANESHIRO
SCALE 1/4" = 1'-0"
DATE JULY 15, 1953
CHECKED BY
TRACER
APPROVED: CHIEF ENGINEER
APPROVED: BUREAU ENGINEER

APPROVED: ENGINEER, KALIHI TUNNEL

W. S.	PROFILE	C. B.
CR. SEC.	F. B.	S. B.
W. M. BY	F. W. BY	S. BY

SECTION C JOB NO. 26-53 DWG. P-3

Sheet No. 125 of 252 Sheets

FILE	POCKET	FOLDER	NO.
7	6	1	3