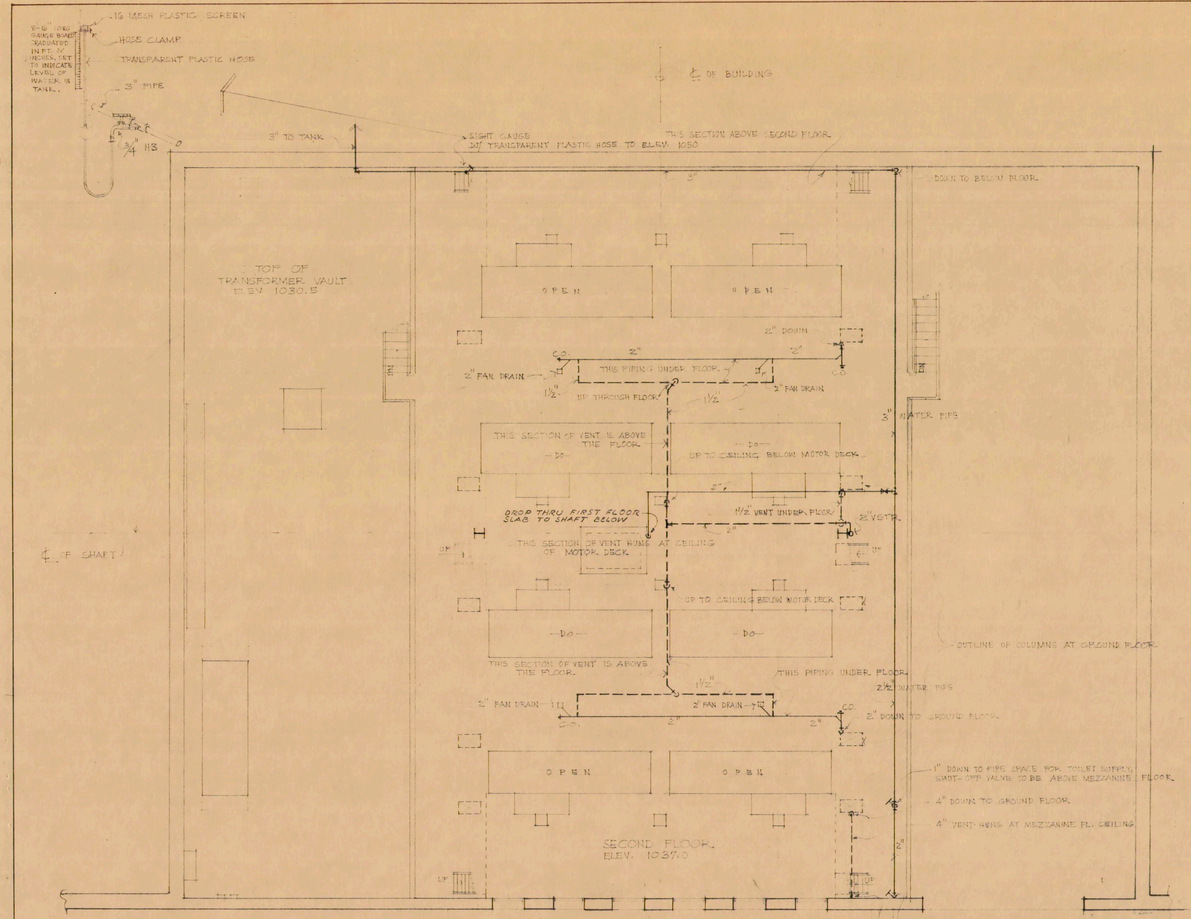

SECOND FLOOR PLAN
SCALE 1/8" = 1'-0"

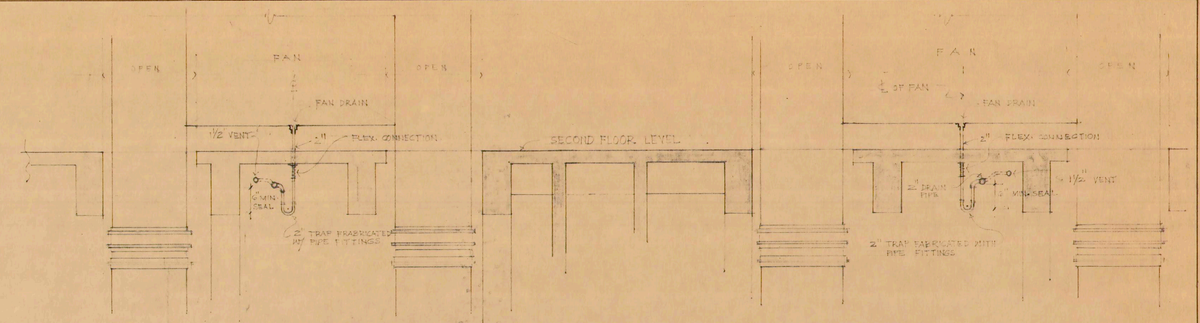

CROSS-SECTION SHOWING SANITARY SEWER
DO NOT SCALE

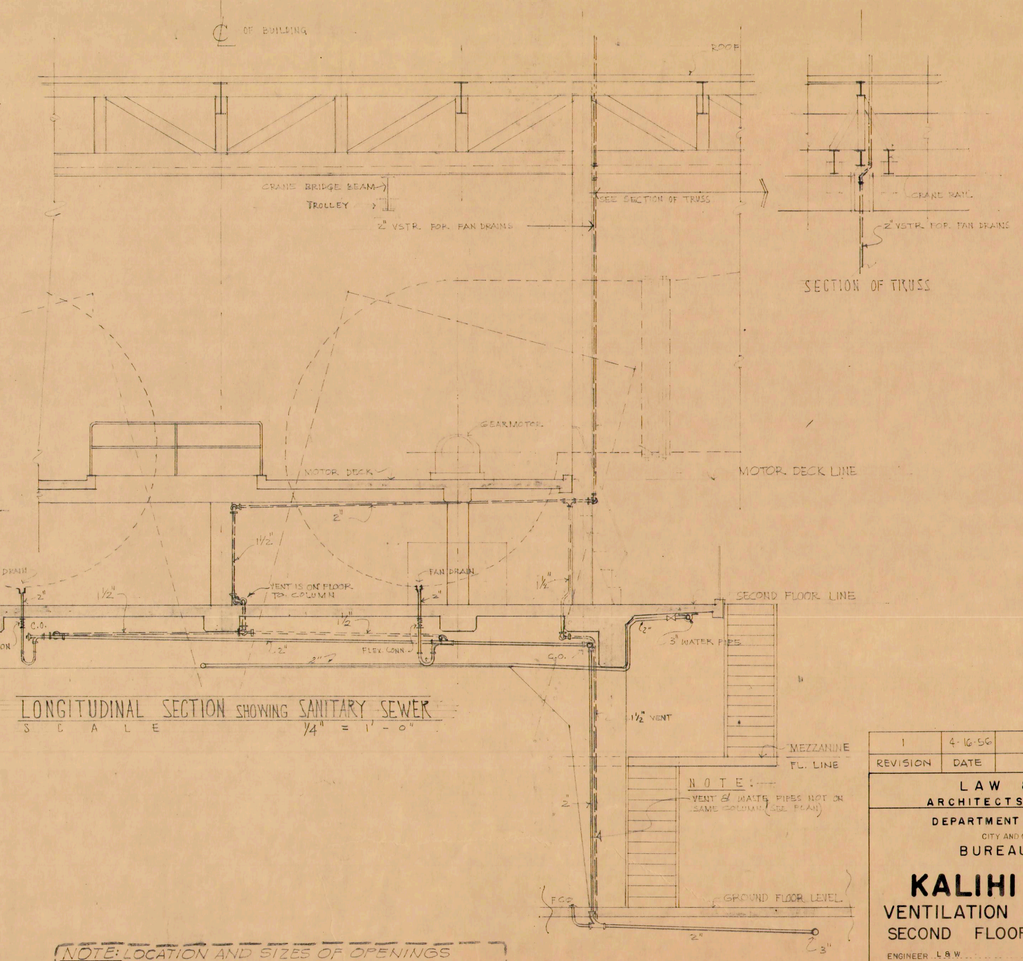

LONGITUDINAL SECTION SHOWING SANITARY SEWER
SCALE 1/4" = 1'-0"

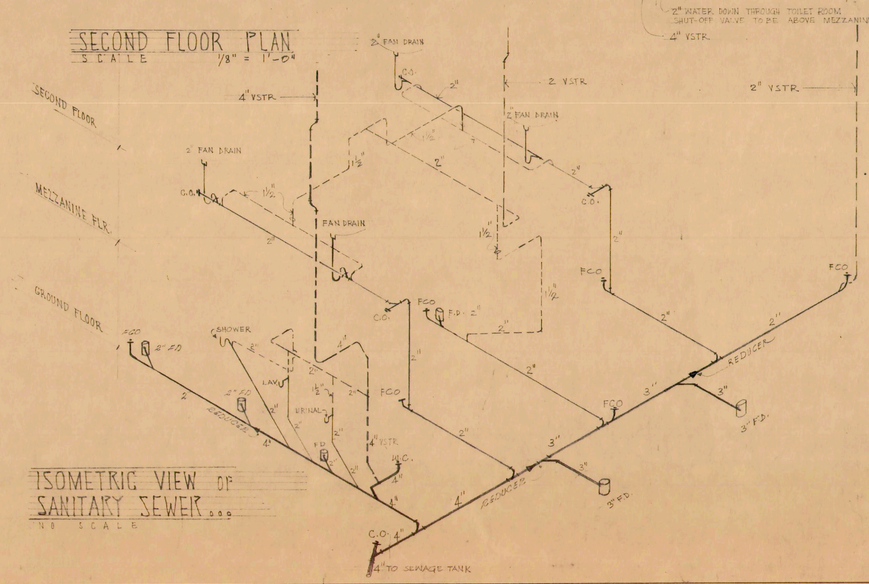

ISOMETRIC VIEW OF SANITARY SEWER
NO SCALE

NOTE: LOCATION AND SIZES OF OPENINGS FOR VENT FANS REVISED. ADJUST PLUMBING CIRCUITS TO MEET REVISIONS.

REVISION	DATE	DESCRIPTION	MADE BY	CHK BY
1	4-16-56	SEE NOTE	E.V.	JO

LAW & WILSON
ARCHITECTS & ENGINEERS
DEPARTMENT OF PUBLIC WORKS
CITY AND COUNTY OF HONOLULU
BUREAU OF PLANS

KALIHI TUNNEL
VENTILATION BLDG. – PLUMBING
SECOND FLOOR PLAN & DETAILS

ENGINEER L.&W. DATE JULY 15, 1953
DRAFTSMAN A.R. CHECKED BY E.V.
SCALE AS NOTED TRACER
CHIEF ENGINEER APPROVED BUREAU ENGINEER

APPROVED: ENGINEER, KALIHI TUNNEL

W.S.	PROFILE	C.B.
CR. SEC.	F.B.	S.B.
W.M. BY.	F.W. BY.	S.BY.

SECTION C JOB NO. 26-53 DWG. VB-43

FILE	POCKET	FOLDER	NO.
7	G	8	23