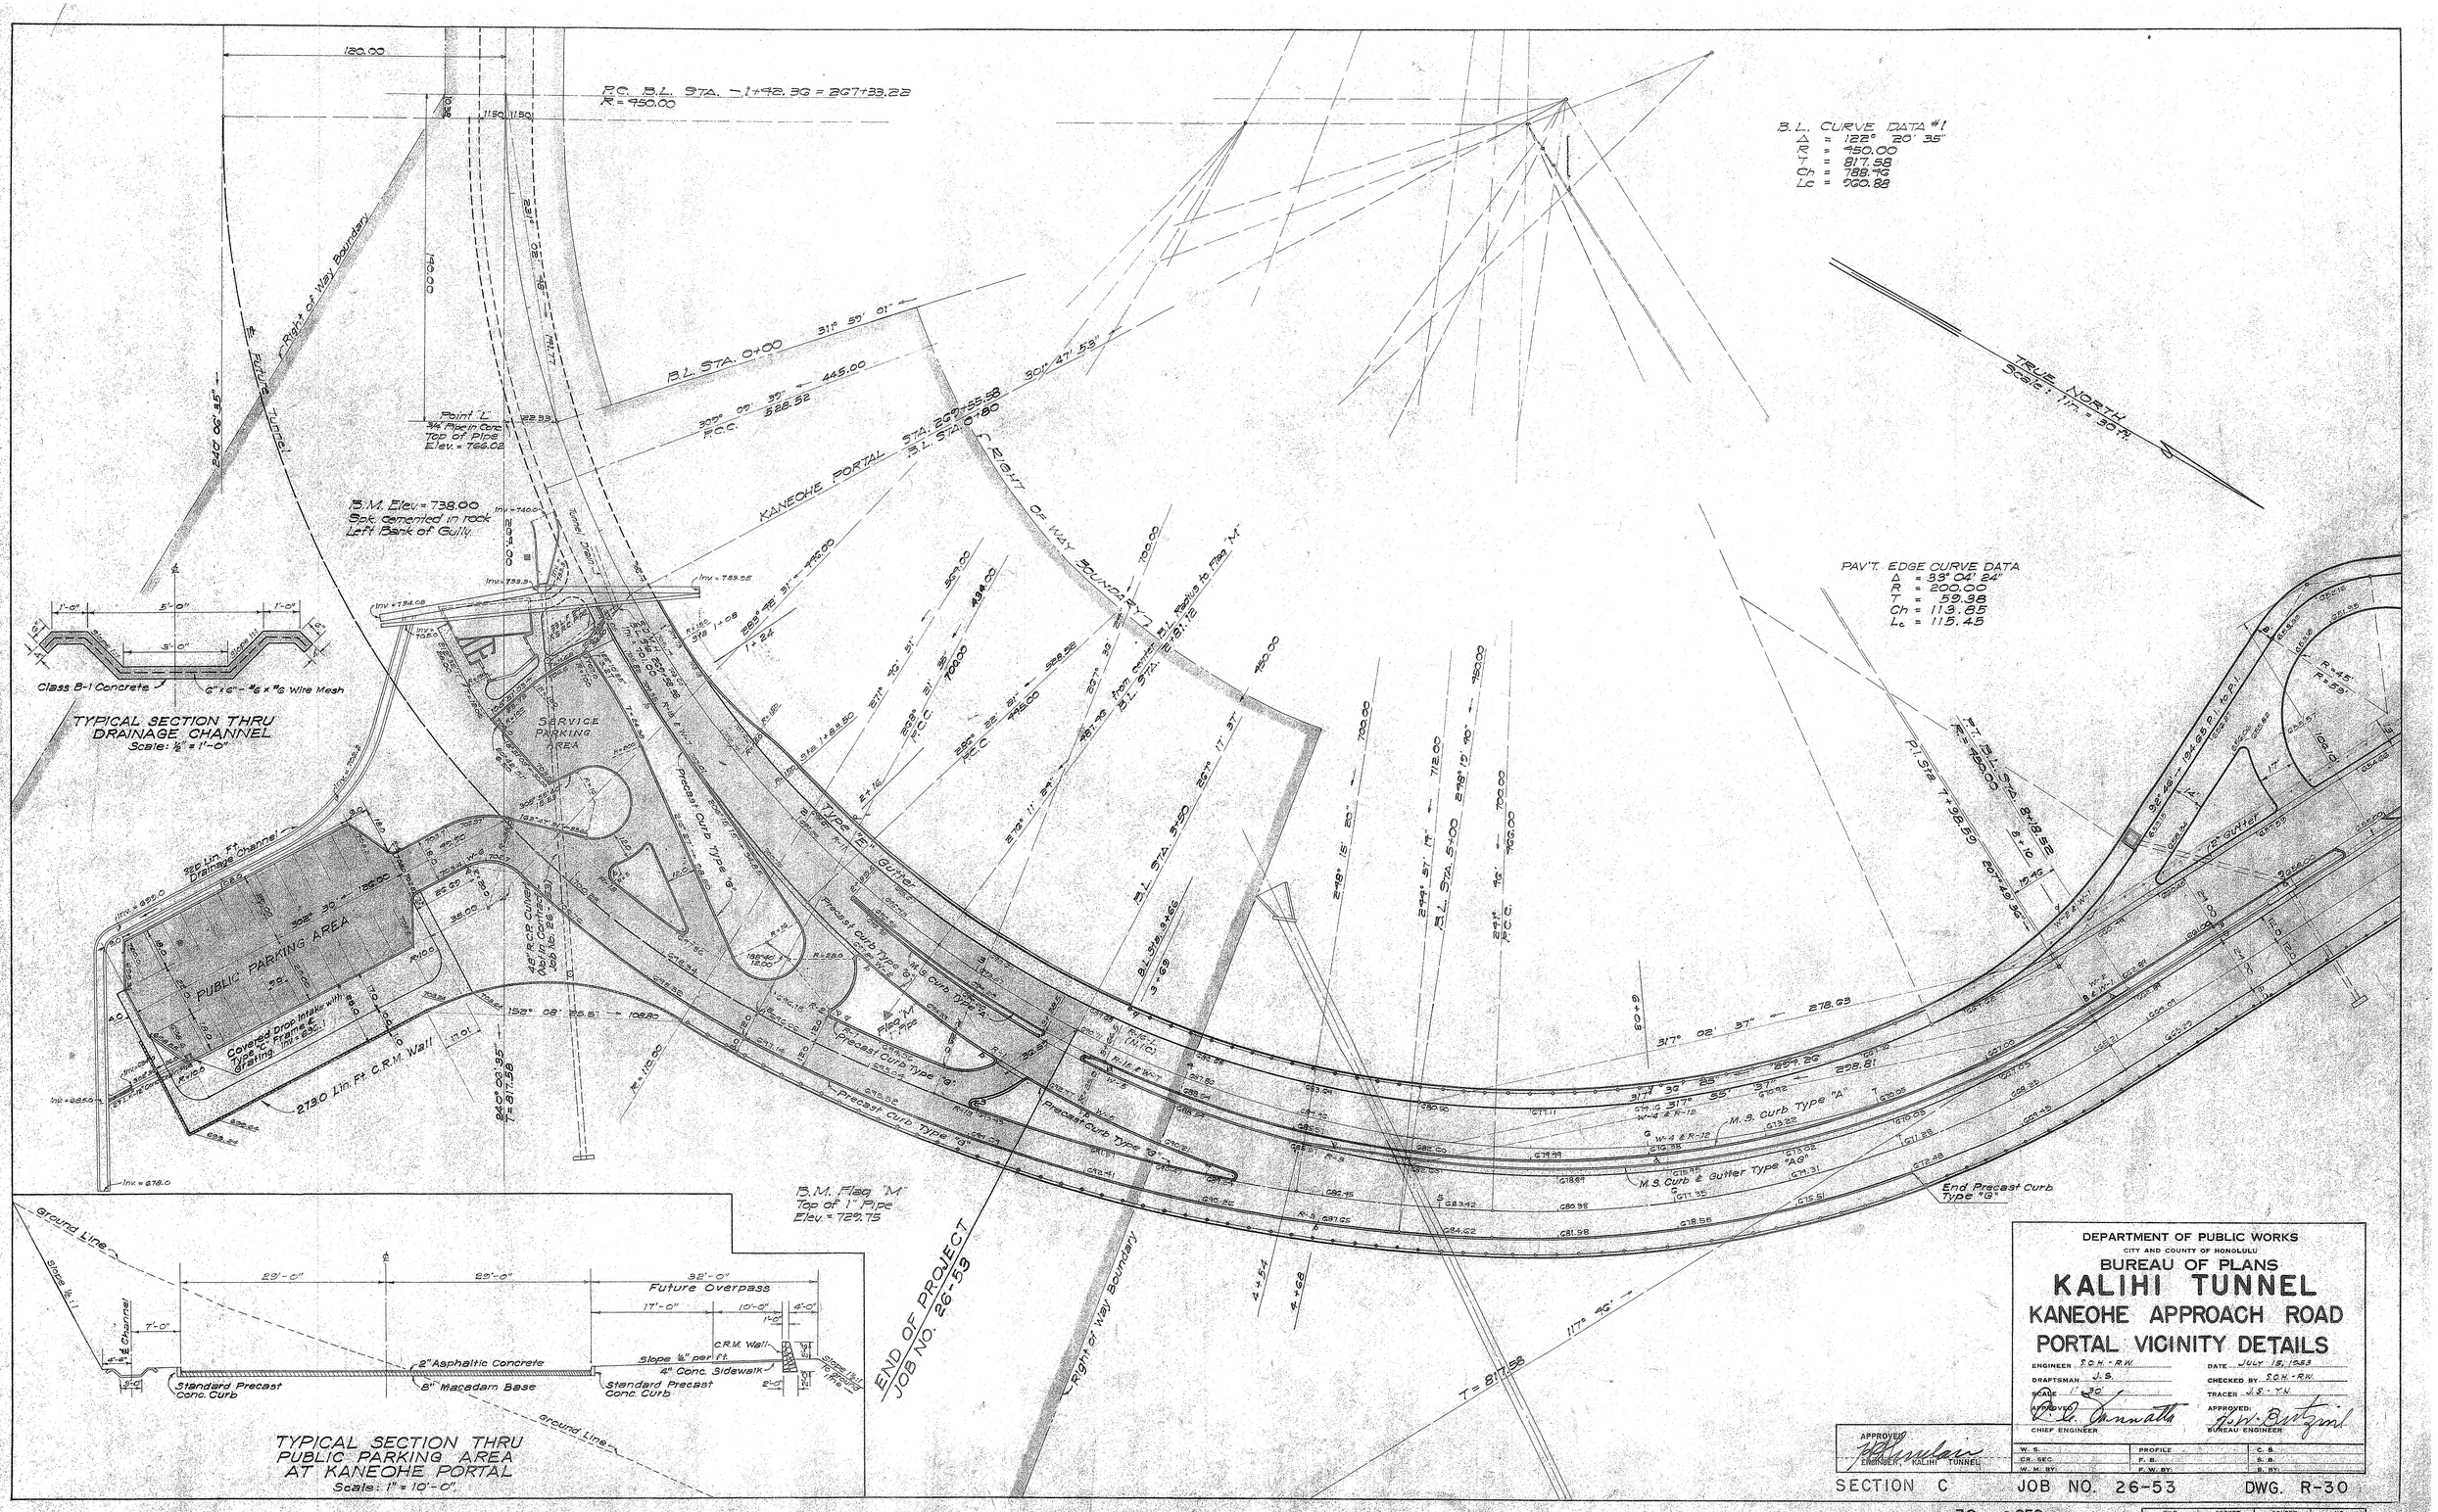

DEPARTMENT OF PUBLIC WORKS
CITY AND COUNTY OF HONOLULU
BUREAU OF PLANS

KALIHI TUNNEL
KANEOHE APPROACH ROAD
PORTAL VICINITY DETAILS

ENGINEER: S.O.H.-R.W. DATE: JULY 18, 1953
DRAFTSMAN: J.S. CHECKED BY: S.O.H.-R.W.
SCALE: 1" = 30' TRACER: J.S.-Y.N.
APPROVED: CHIEF ENGINEER APPROVED: BUREAU ENGINEER

APPROVED: ENGINEER, KALIHI TUNNEL

W.S.	PROFILE	C.&S.
CR. SEC.	F.B.	S.B.
W.M. BY:	P.W. BY:	B. BY:

SECTION C JOB NO. 26-53 DWG. R-30

Sheet No. 39 of 252 Sheets

FILE	POCKET	FOLDER	NO.
7	5	2	2