


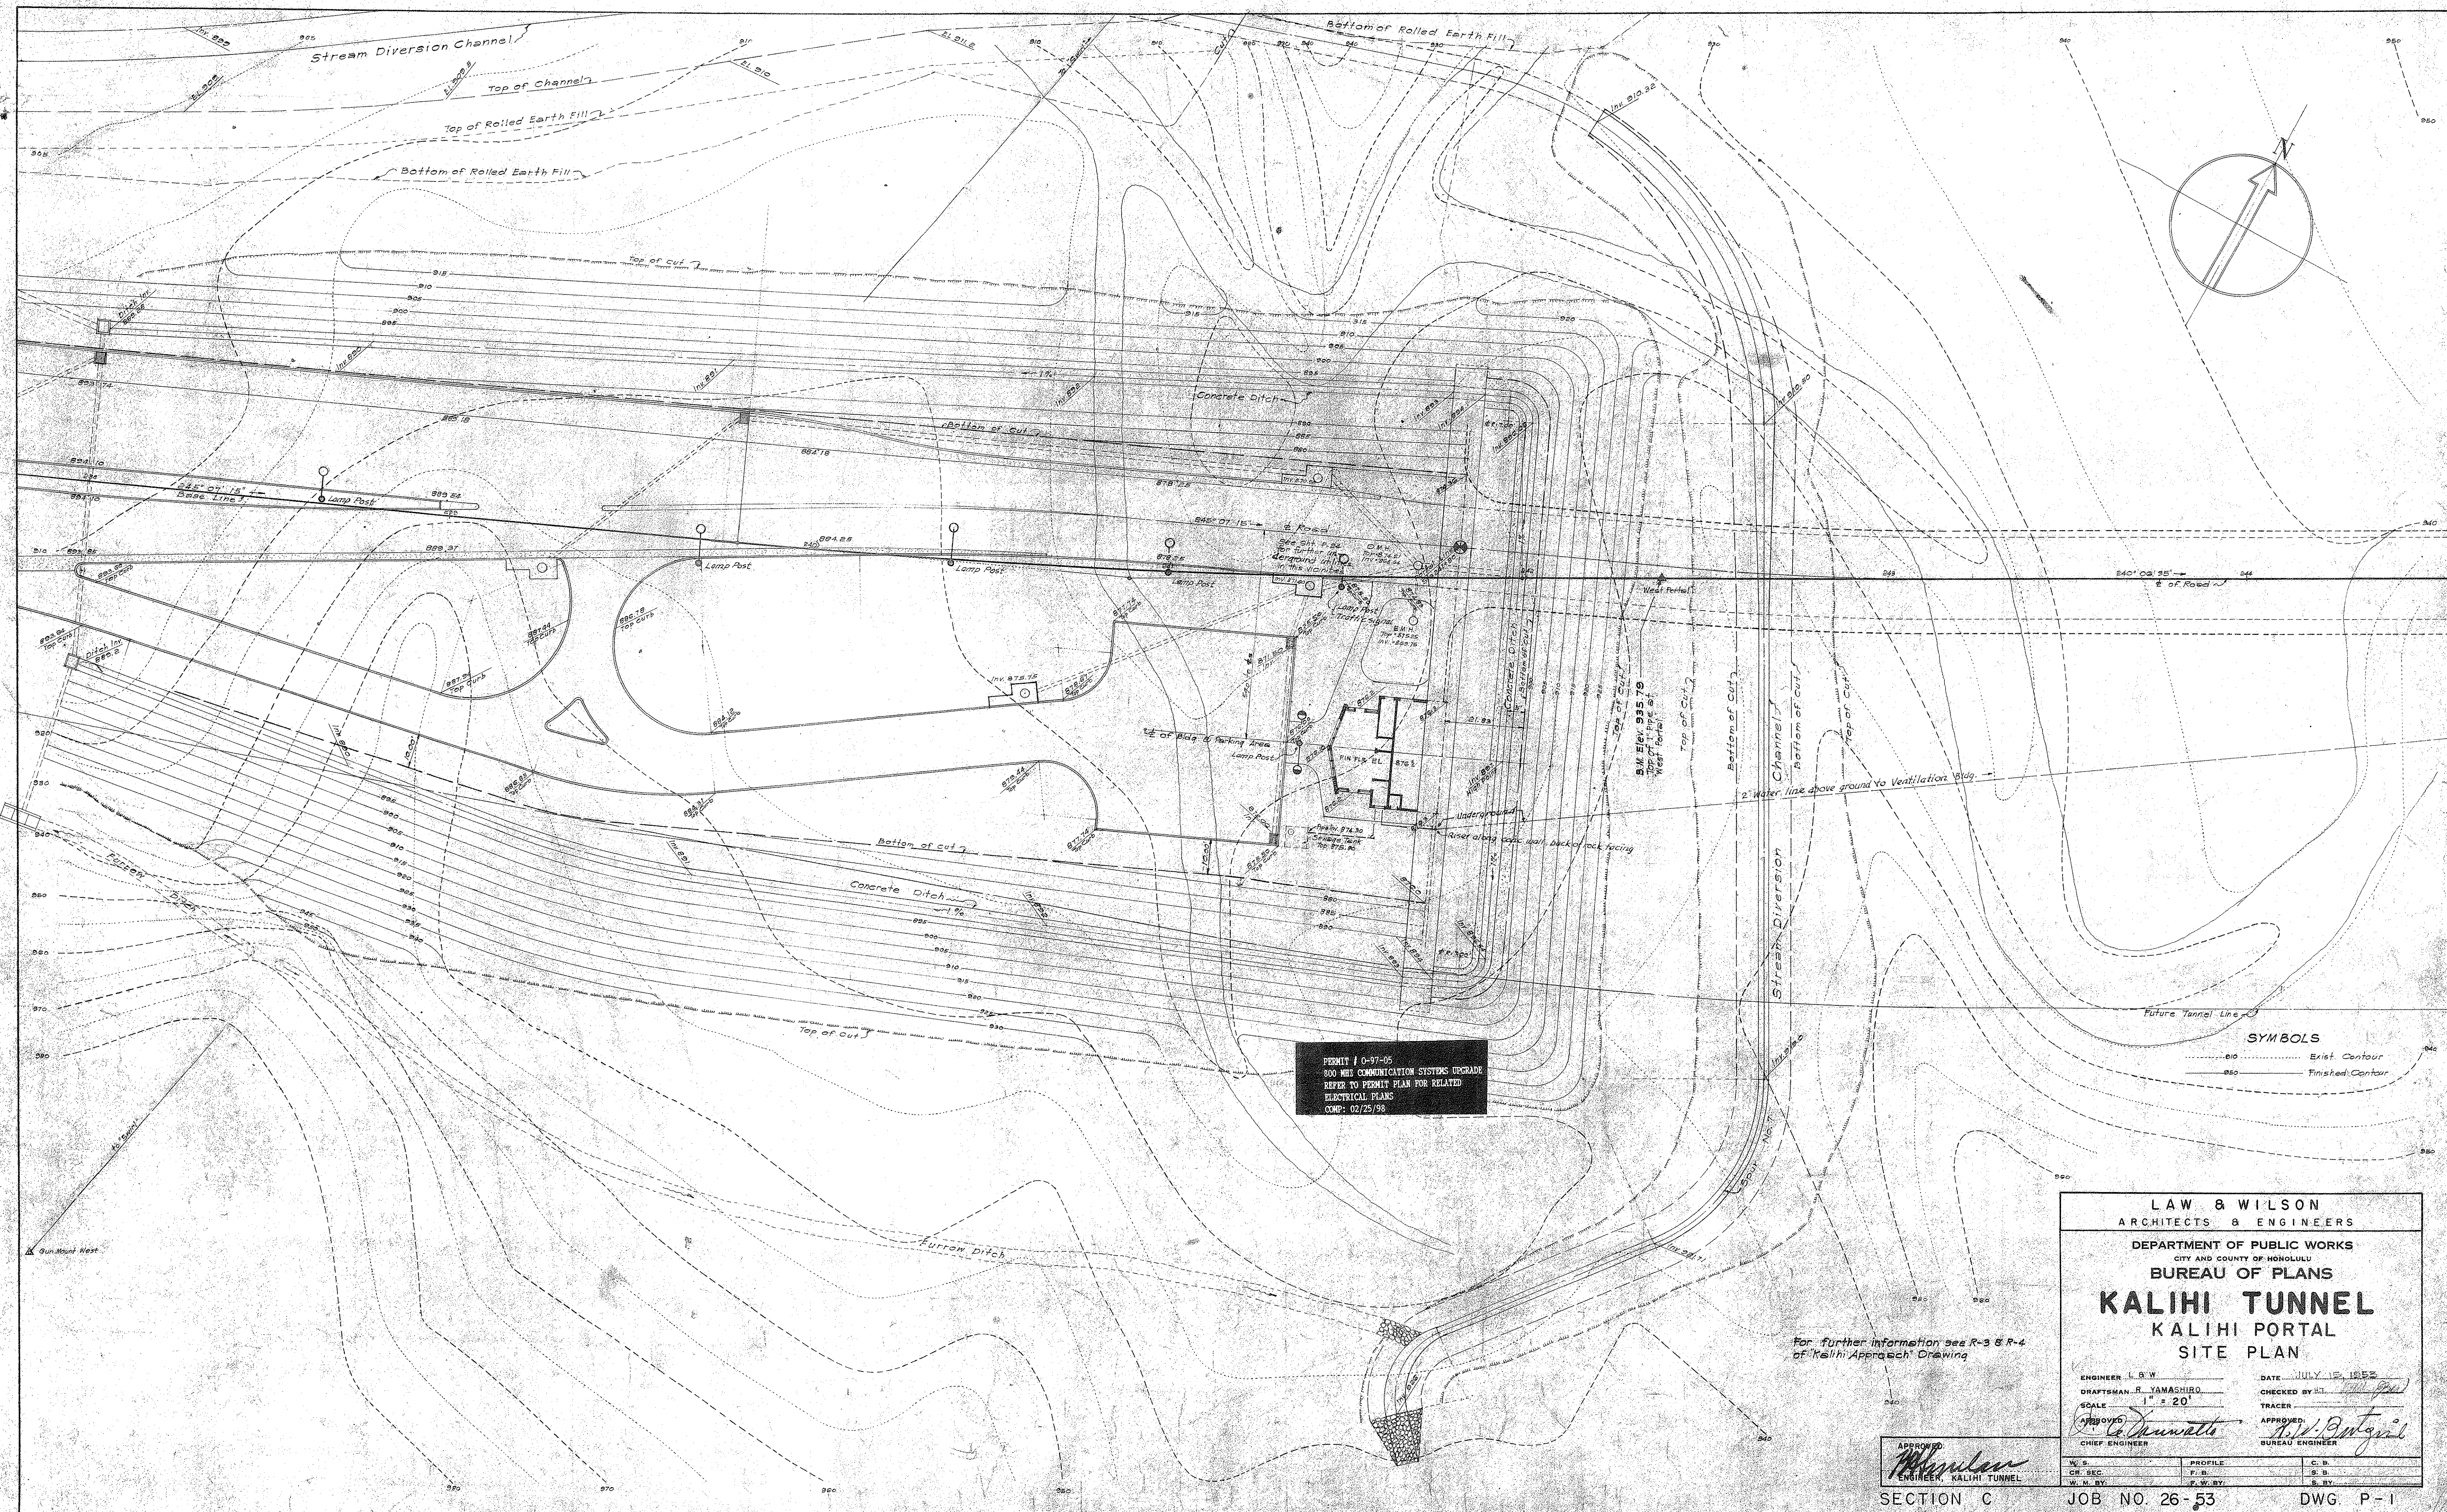

SYMBOLS
..... Exist. Contour
——— Finished Contour

LAW & WILSON
ARCHITECTS & ENGINEERS

DEPARTMENT OF PUBLIC WORKS
CITY AND COUNTY OF HONOLULU
BUREAU OF PLANS

KALIHI TUNNEL
KALIHI PORTAL
SITE PLAN

ENGINEER: L. W. WILSON
DRAFTSMAN: R. YAMASHIRO
SCALE: 1" = 20'
DATE: JULY 12, 1952

W. S.	PROFILE	C. B.
CR. SEC.	F. B.	S. B.
W. N. BY.	P. W. BY.	S. BY.

APPROVED: *[Signature]*
ENGINEER, KALIHI TUNNEL

SECTION C JOB NO. 26-53 DWG. P-1