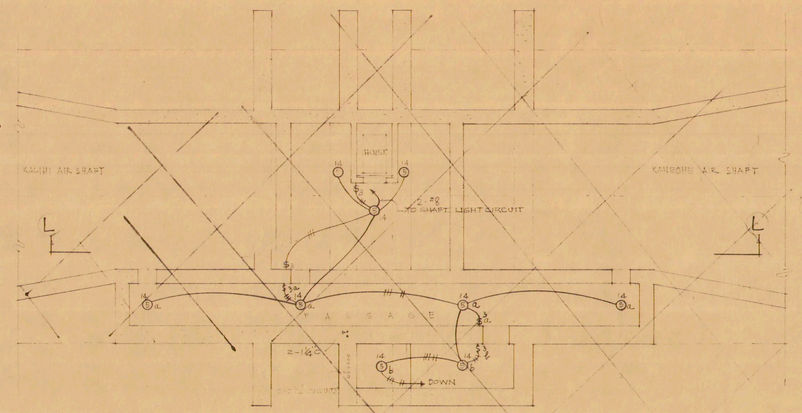

CEILING PLAN of PLATFORM (towards P)
SCALE 1/8" = 1'-0"

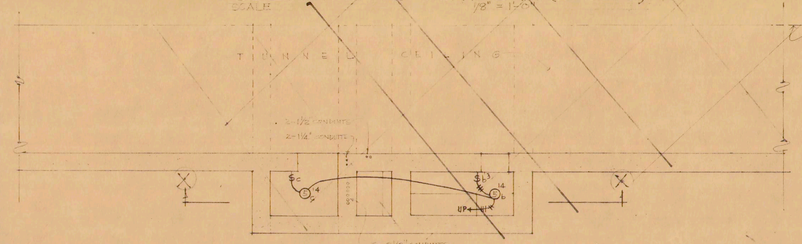

GROUND FLOOR CEILING PLAN (towards O)
SCALE 1/8" = 1'-0"

FOR LEGEND OF ELECTRICAL SYMBOLS, SEE DWG. #VB-47

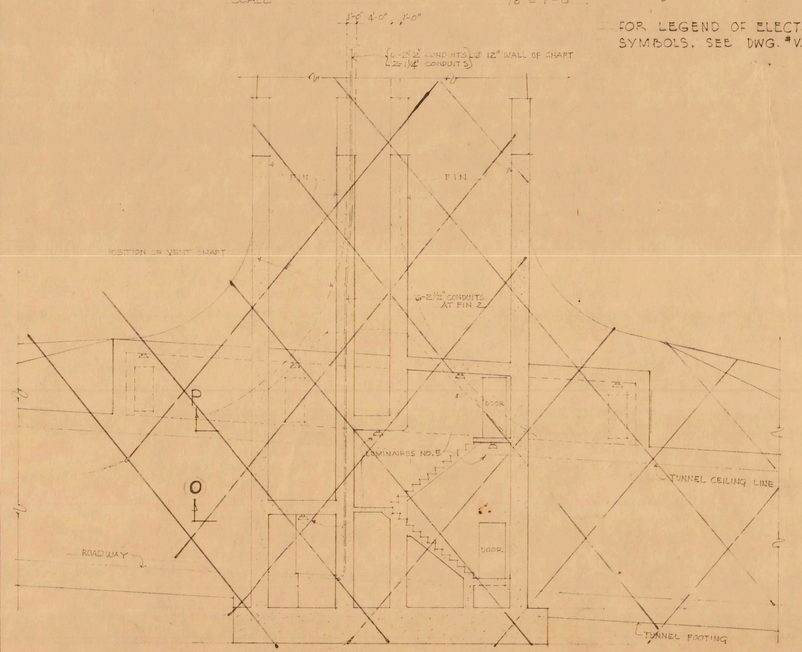

SECTION thru X-X
SCALE 1/8" = 1'-0"

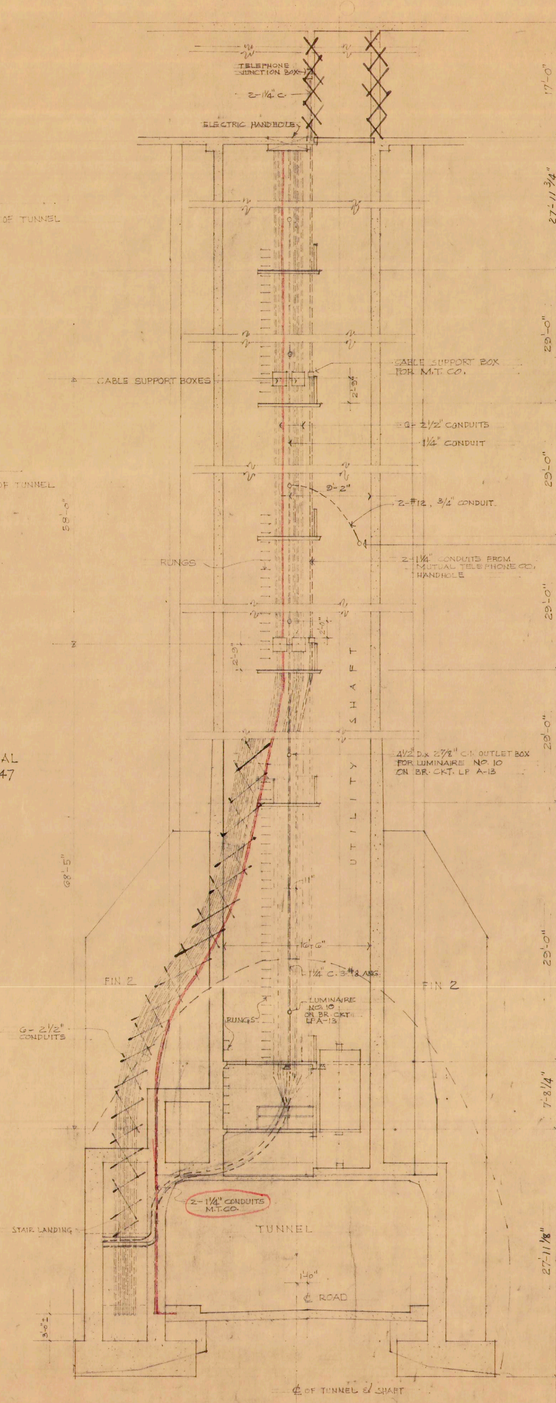

SECTION thru SHAFT (toward Kalihi)
SCALE 1/8" = 1'-0"

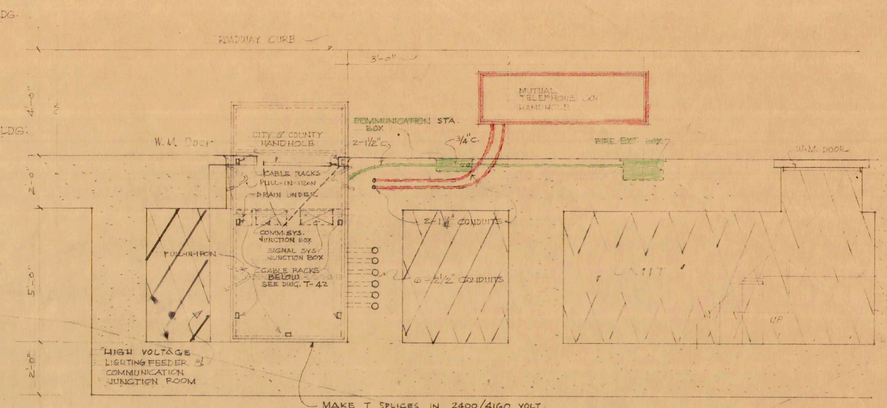

GROUND FLOOR PLAN
SCALE 3/8" = 1'-0"

4½" D. x 2⅞" CAST IRON OUTLET BOX. LOCATE 4'-6" ABOVE CENTER OF TRAVEL OF HOIST AND EQUIP WITH 100W LUMINAIRE WHICH WILL CLEAR ALL MOVING PARTS. LUMINAIRE TO HAVE SINGLE POLE SWITCH. CONNECT TO CIRCUIT A-18

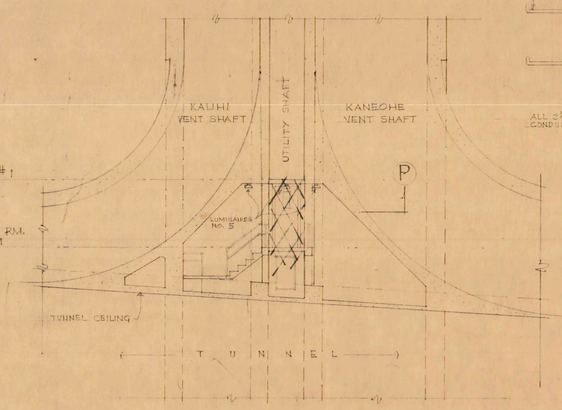

LONGITUDINAL SECTION thru L-L
SCALE 1/8" = 1'-0"

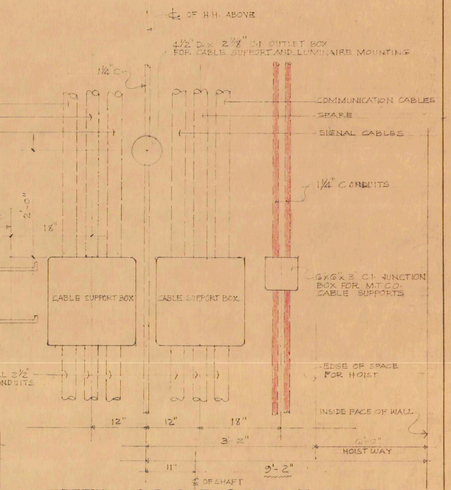

DETAIL of CABLE SUPPORT BOXES
SCALE 3/4" = 1'-0"

NOTE: TRANSITION STRUCTURE REVISED. SEE DRAWINGS 9013-1,2 & 3. ADJUST ELECTRICAL CIRCUITS AS REQUIRED.

REVISION	DATE	DESCRIPTION	MADE BY	CHK. BY
1	4-16-56	SEE NOTE	E.V.	

APPROVED: ENGINEER, KALIHI TUNNEL

LAW & WILSON
ARCHITECTS & ENGINEERS

DEPARTMENT OF PUBLIC WORKS
CITY AND COUNTY OF HONOLULU
BUREAU OF PLANS

KALIHI TUNNEL
ELECTRICAL
TRANSITION & SHAFT
LIGHTING & WIRING DETAILS

ENGINEER L & W — DATE JULY 18, 1953
DRAFTSMAN A.R. — CHECKED BY
SCALE AS NOTED — TRACER
APPROVED: CHIEF ENGINEER — APPROVED: BUREAU ENGINEER

W.S.	PROFILE	C.B.
CR. SEC.	F.B.	S.B.
W.M. BY:	F.W. BY:	S.BY:

SECTION C — JOB NO. 26-53 — DWG. E-12

FILE	POCKET	FOLDER	NO.
7	6	3	16