CONVENTIONAL SIGNS	
Base Line	
Boundary Line	
Forest Reserve Boundary	
Dry Stream	
Existing Road	
Concrete Pipe Culvert	
Concrete Drop Intake	
Standard Manhole	
Cast Iron Frame & Grating	
Standard Catch Basin	
Concrete Curb	
Guard Rail	
Grouted Rubble Paving	
Bench Mark	
C & C Street Survey Monument	
Regulatory & Warning Signs	

DEPARTMENT OF PUBLIC WORKS
CITY AND COUNTY OF HONOLULU
BUREAU OF PLANS

JOB NO. 26-53

KALIHI TUNNEL

SECTION "C"

KALIHI AND KANEOHE, OAHU, T.H.

SCALES

PLAN		1in. = 50ft.
PROFILE	Hor.	1in = 50ft.
	Vert.	1in. = 10ft.
CROSS-SECTION	Hor.	1in. = 10ft.
	Vert.	1in. = 10ft.

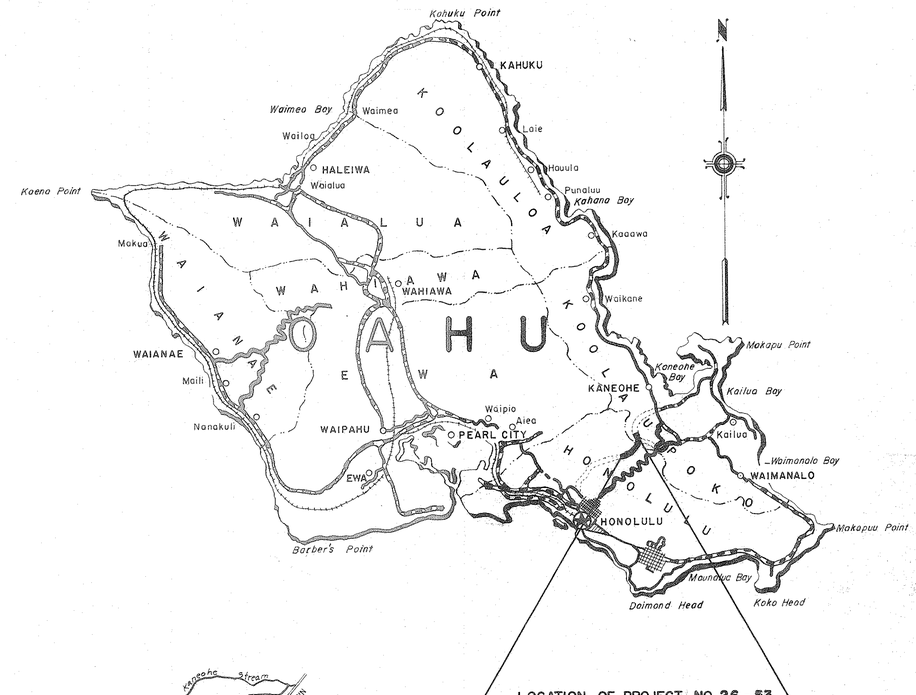

LOCATION OF PROJECT NO. 26-53

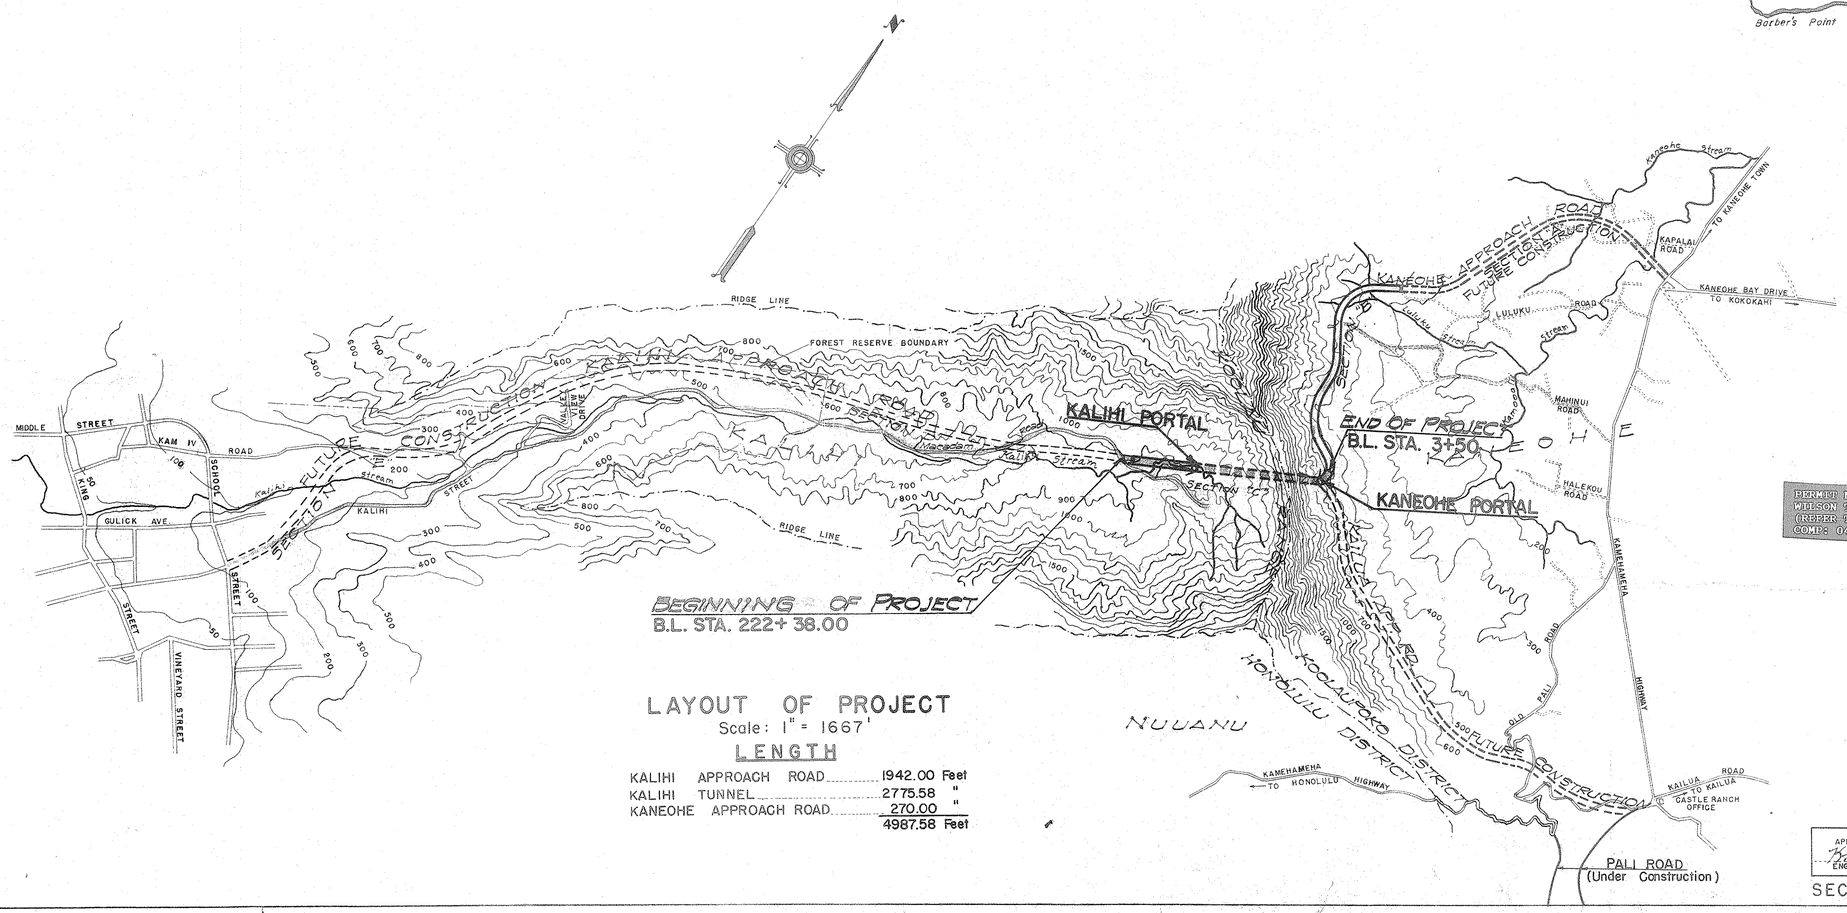

Permit # 0-97-94A
Wilson Tunnel Sewer Cell Site
R.O.E. to Pay to Dept.
Comp. 10/20/98

Maintenance Permit # 516
Cleaning of Wilson Tunnel
Comp. 6/28/88

Permit # 0-89-79
Cleaning of Wilson Tunnel
Comp. 12/29/90

PERMIT NO. 0-96-36
WILSON TUNNEL CELLULAR PHONE SITES
(REFER TO PERMIT PLAN FOR DETAILS)
COMP: 04/04/97

LAYOUT OF PROJECT

Scale: 1" = 1667'

LENGTH

KALIHI APPROACH ROAD	1942.00 Feet
KALIHI TUNNEL	2775.58 "
KANEOHE APPROACH ROAD	270.00 "
	4987.58 Feet

DEPARTMENT OF PUBLIC WORKS
CITY AND COUNTY OF HONOLULU
BUREAU OF PLANS

KALIHI TUNNEL

VICINITY MAP

ENGINEER	S.O.H. - R.N.	DATE	JULY 15, 1989
DRAFTSMAN	J.S.	CHECKED BY	S.O.H. - R.N.
SCALE	1" = 1667'	TRACER	J.S.
APPROVED: CHIEF ENGINEER	D. B. Tannatta	APPROVED: BUREAU ENGINEER	H. W. Butzow

APPROVED
K. Sundara
ENGINEER, KALIHI TUNNEL

W. S.	PROFILE	C. S.
CR. SEC.	F. B.	S. B.
W. M. BY:	F. W. BY:	S. BY:

SECTION C JOB NO. 26-53 DWG. X-3

Sheet No. 3 of 252 Sheets

FILE	POCKET	FOLDER	NO.
7	5	1	3