


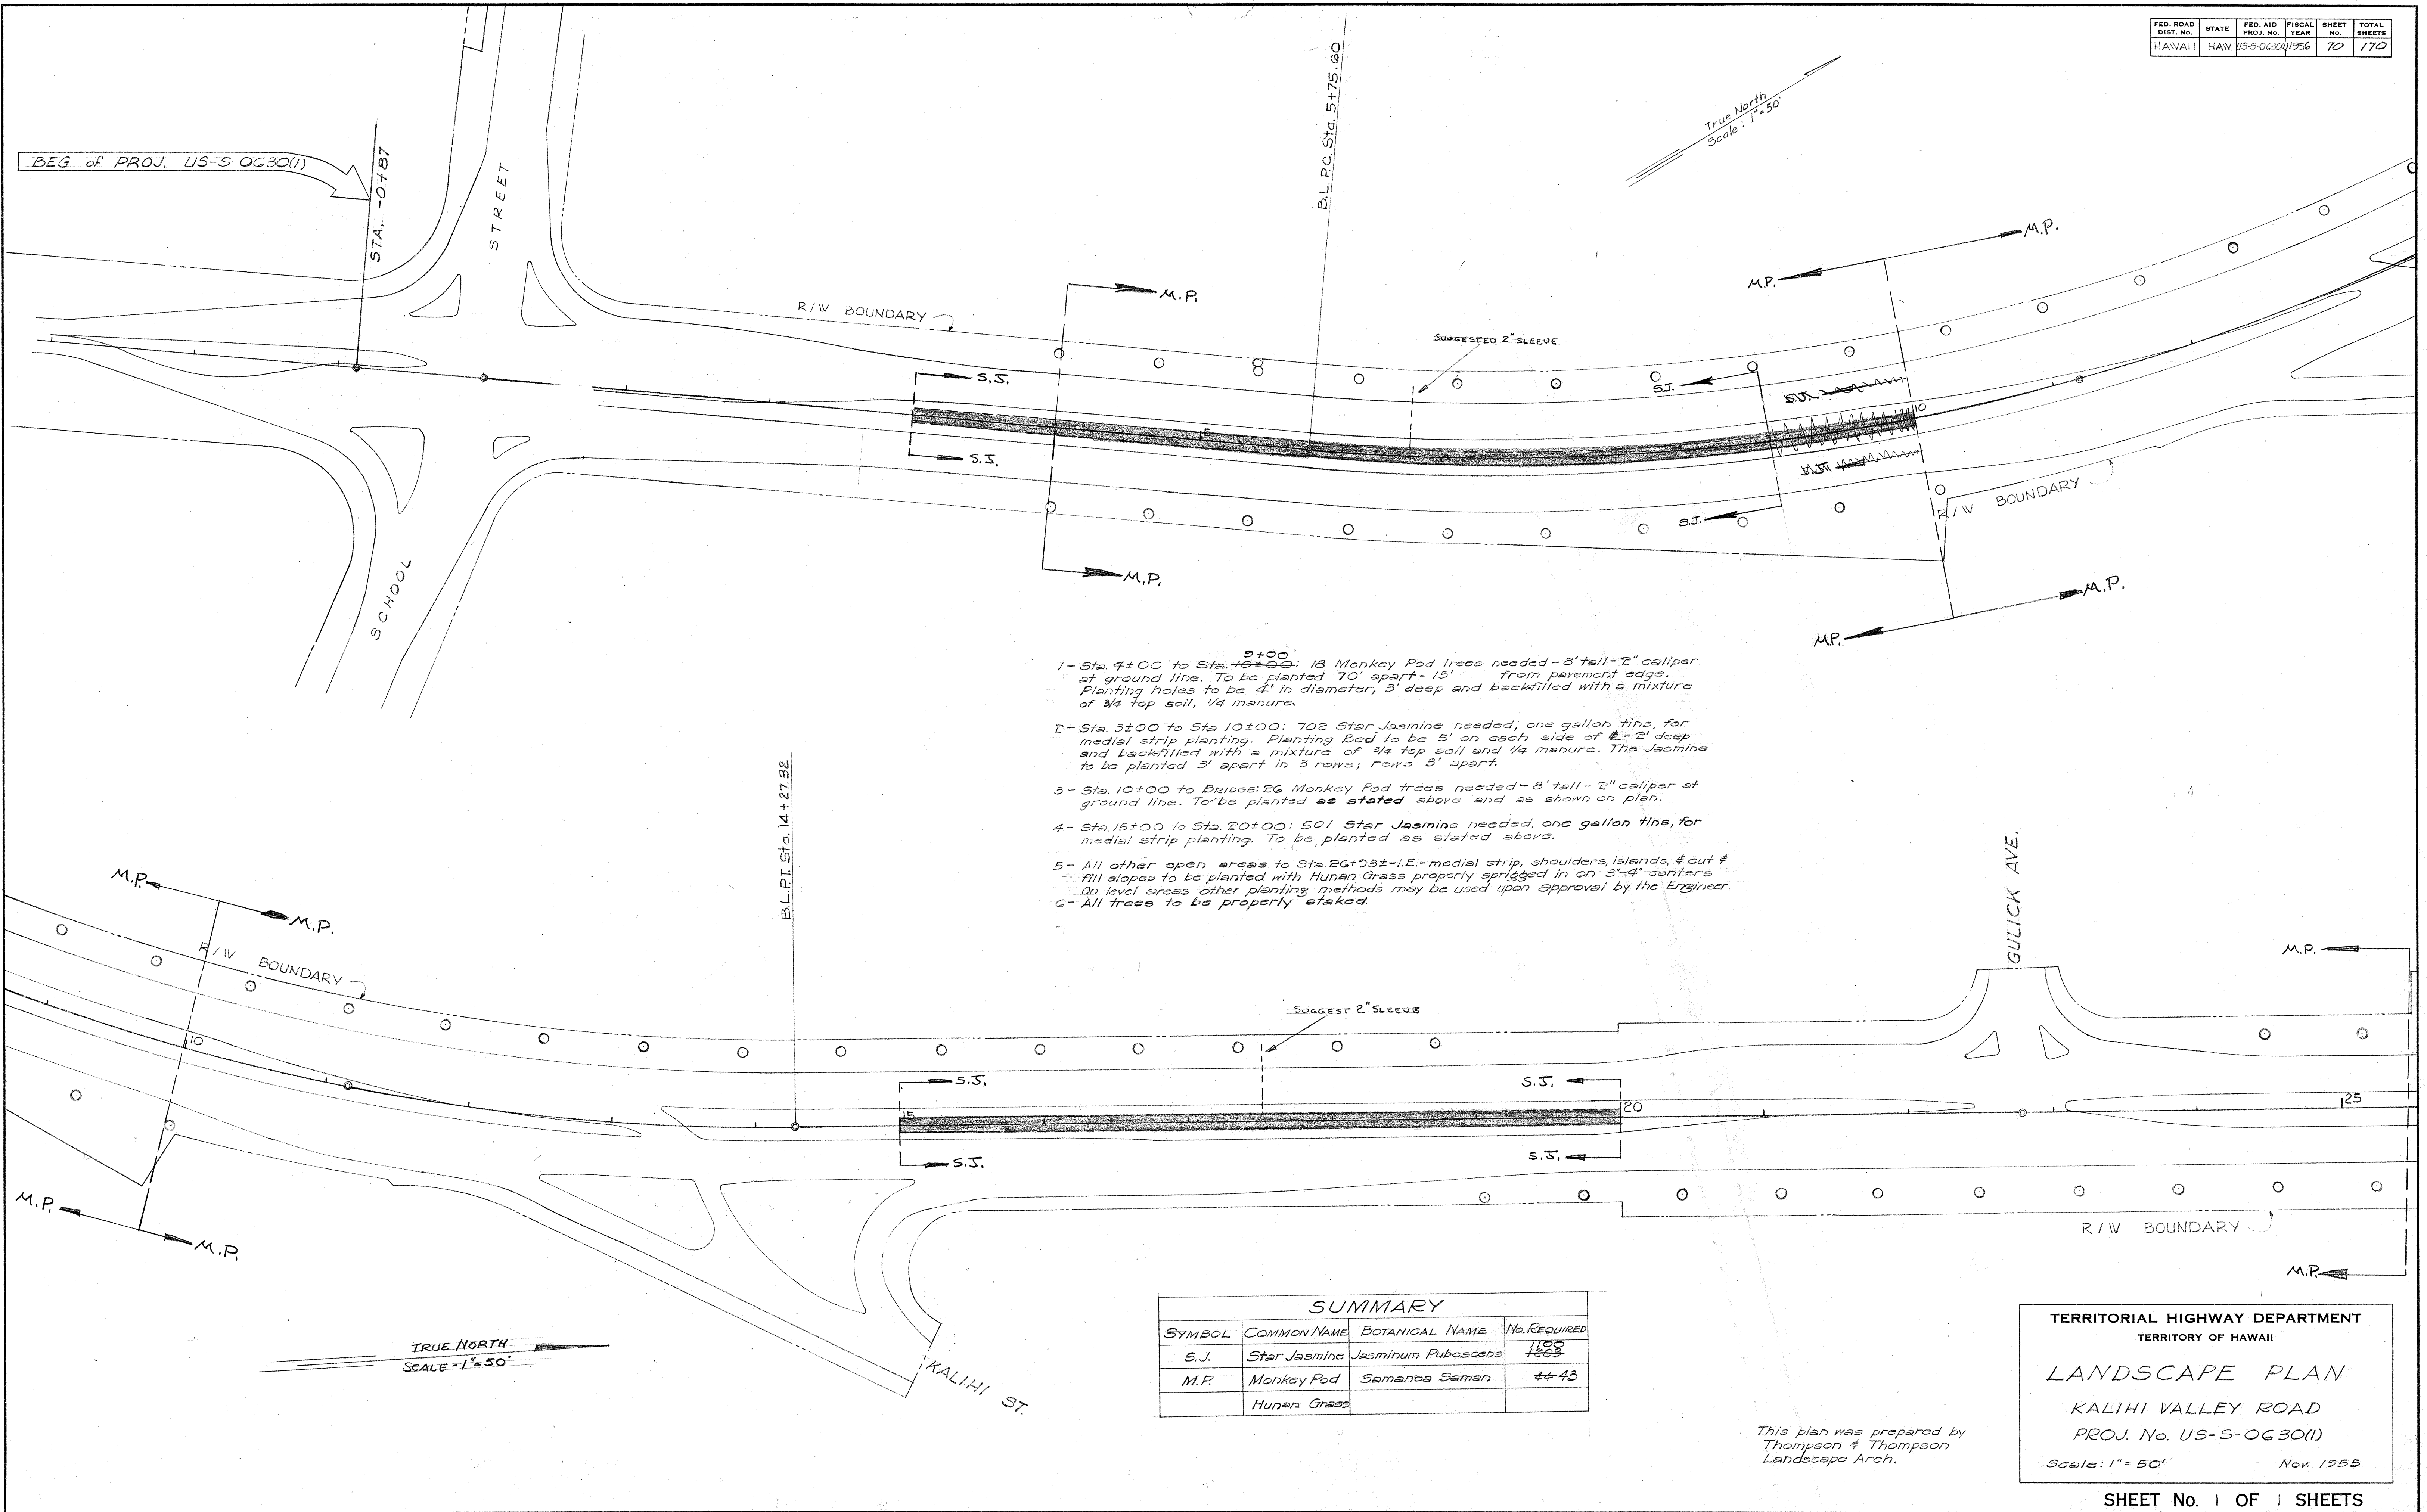

SUMMARY			
SYMBOL	COMMON NAME	BOTANICAL NAME	No. REQUIRED
S.J.	Star Jasmine	Jasminum Pubescens	1102
M.P.	Monkey Pod	Samanea Saman	44
	Hunan Grass		

TERRITORIAL HIGHWAY DEPARTMENT
TERRITORY OF HAWAII

LANDSCAPE PLAN

KALIHI VALLEY ROAD

PROJ. No. US-S-0630(1)

Scale: 1"=50'

Nov. 1955

This plan was prepared by
Thompson & Thompson
Landscape Arch.







