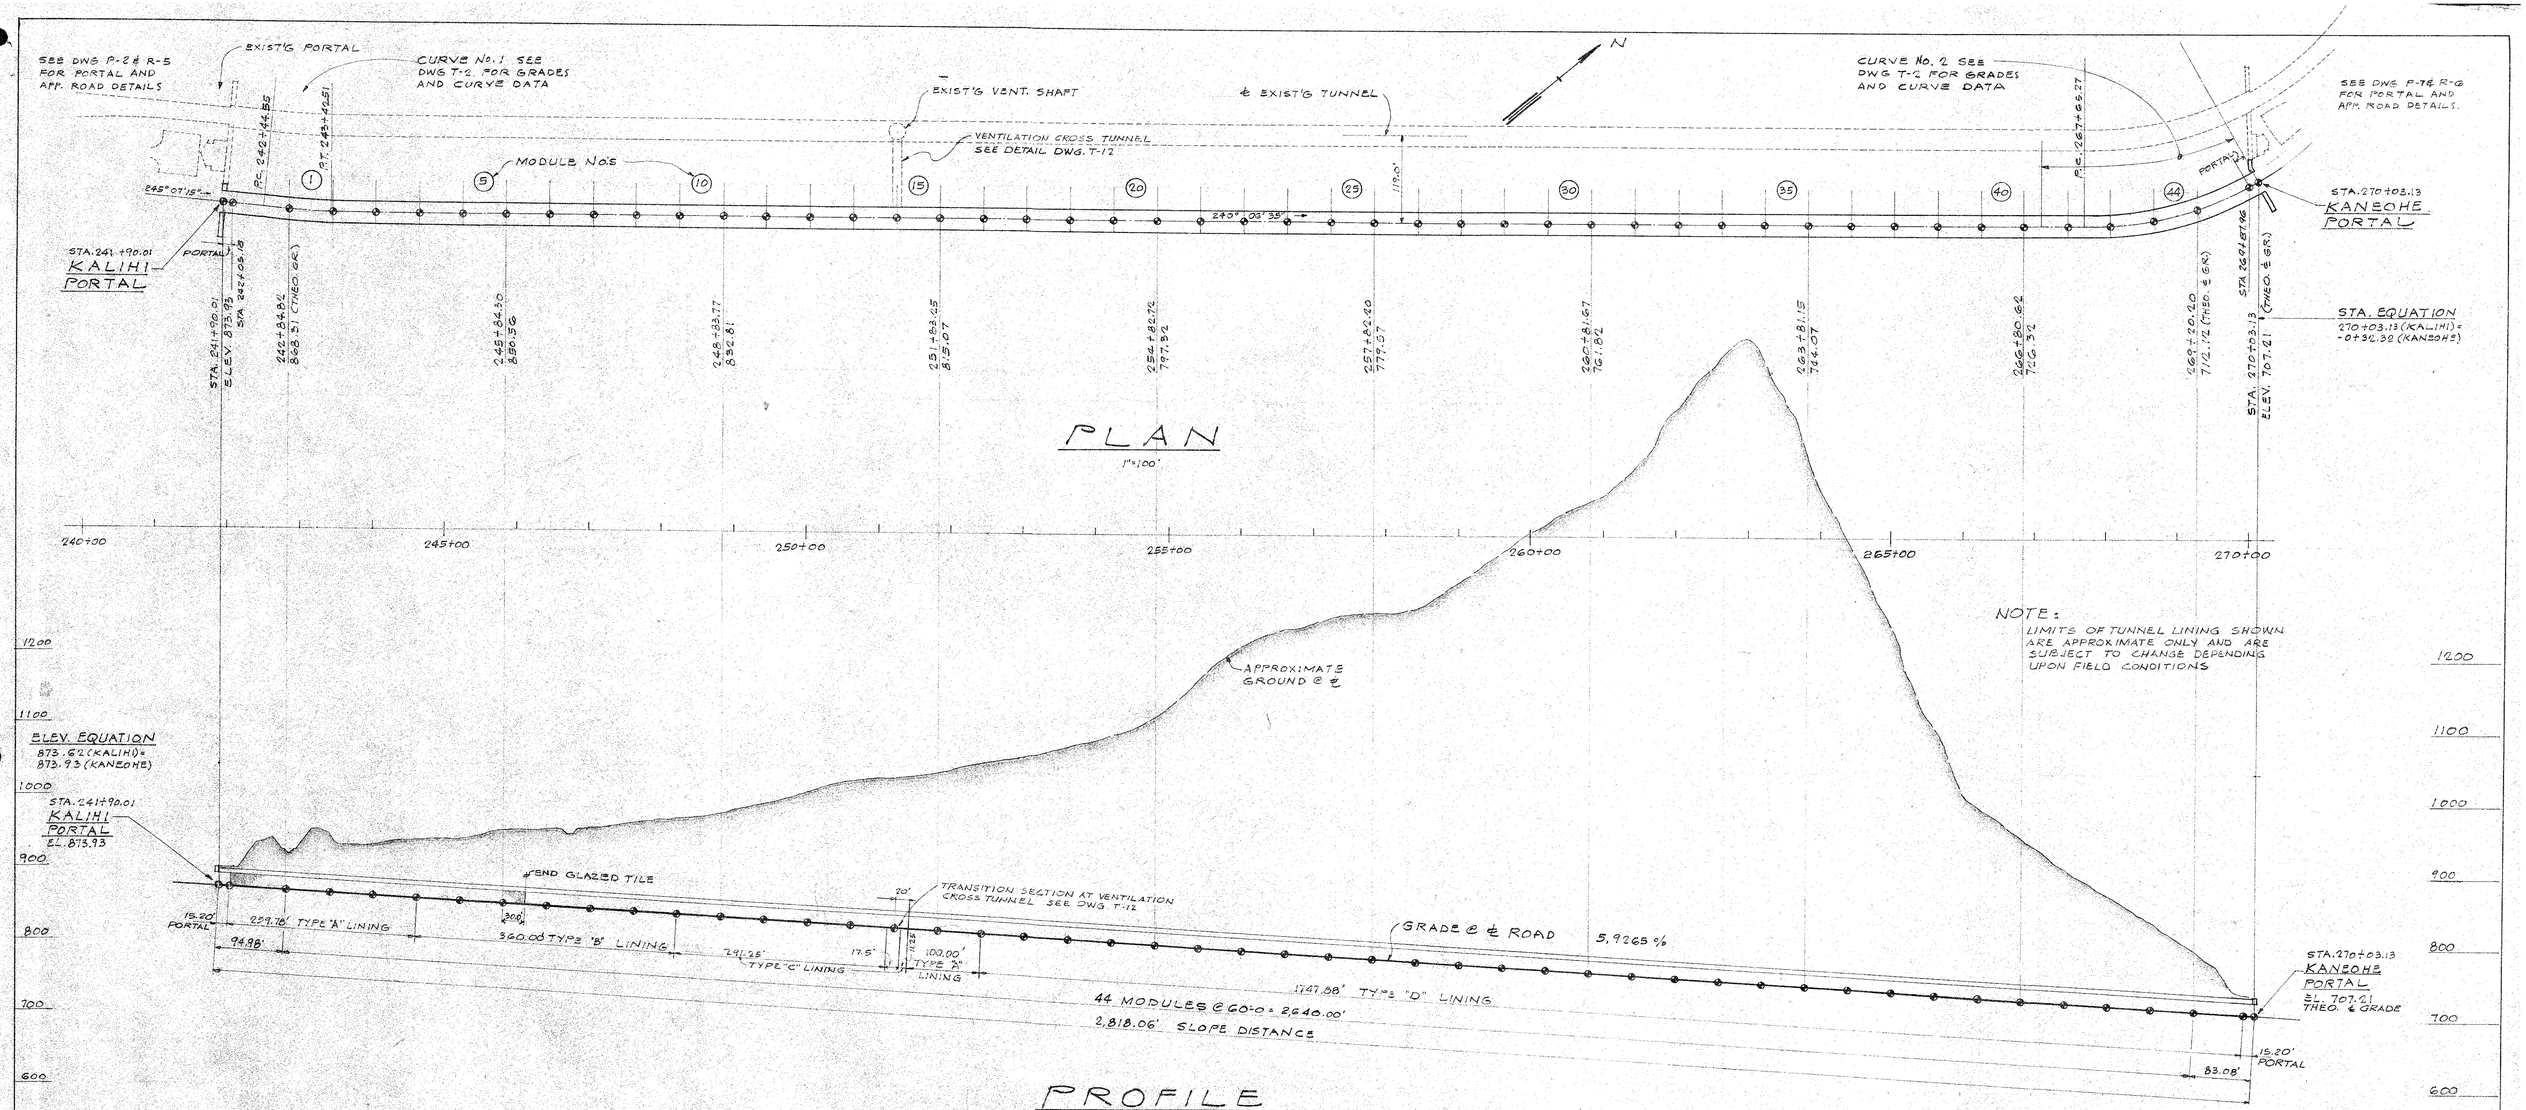

DEPARTMENT OF PUBLIC WORKS
CITY AND COUNTY OF HONOLULU
BUREAU OF PLANS

WILSON TUNNEL 2nd BORE
TUNNEL
PLAN AND PROFILE

ENGINEER W. Lum — DATE 8-8-57
DRAFTSMAN Rok — CHECKED BY Rok
SCALE — TRACER
APPROVED Arthur Kusumoto, CHIEF ENGINEER — APPROVED BUREAU ENGINEER

CONSULTANTS:
DR. RALPH B. PECK
DE LEUW, CATHER & COMPANY
J. DONOVAN JACOBS

W. S.	PROFILE	C. B.
CR. SEC.	F. B.	S. B.
W. M. BY	F. W. BY	S. BY

JOB NO. 13-57 DWG. NO. T-1

Sheet No. 9 of 46 Sheets

FILE	POCKET	FOLDER	NO.