


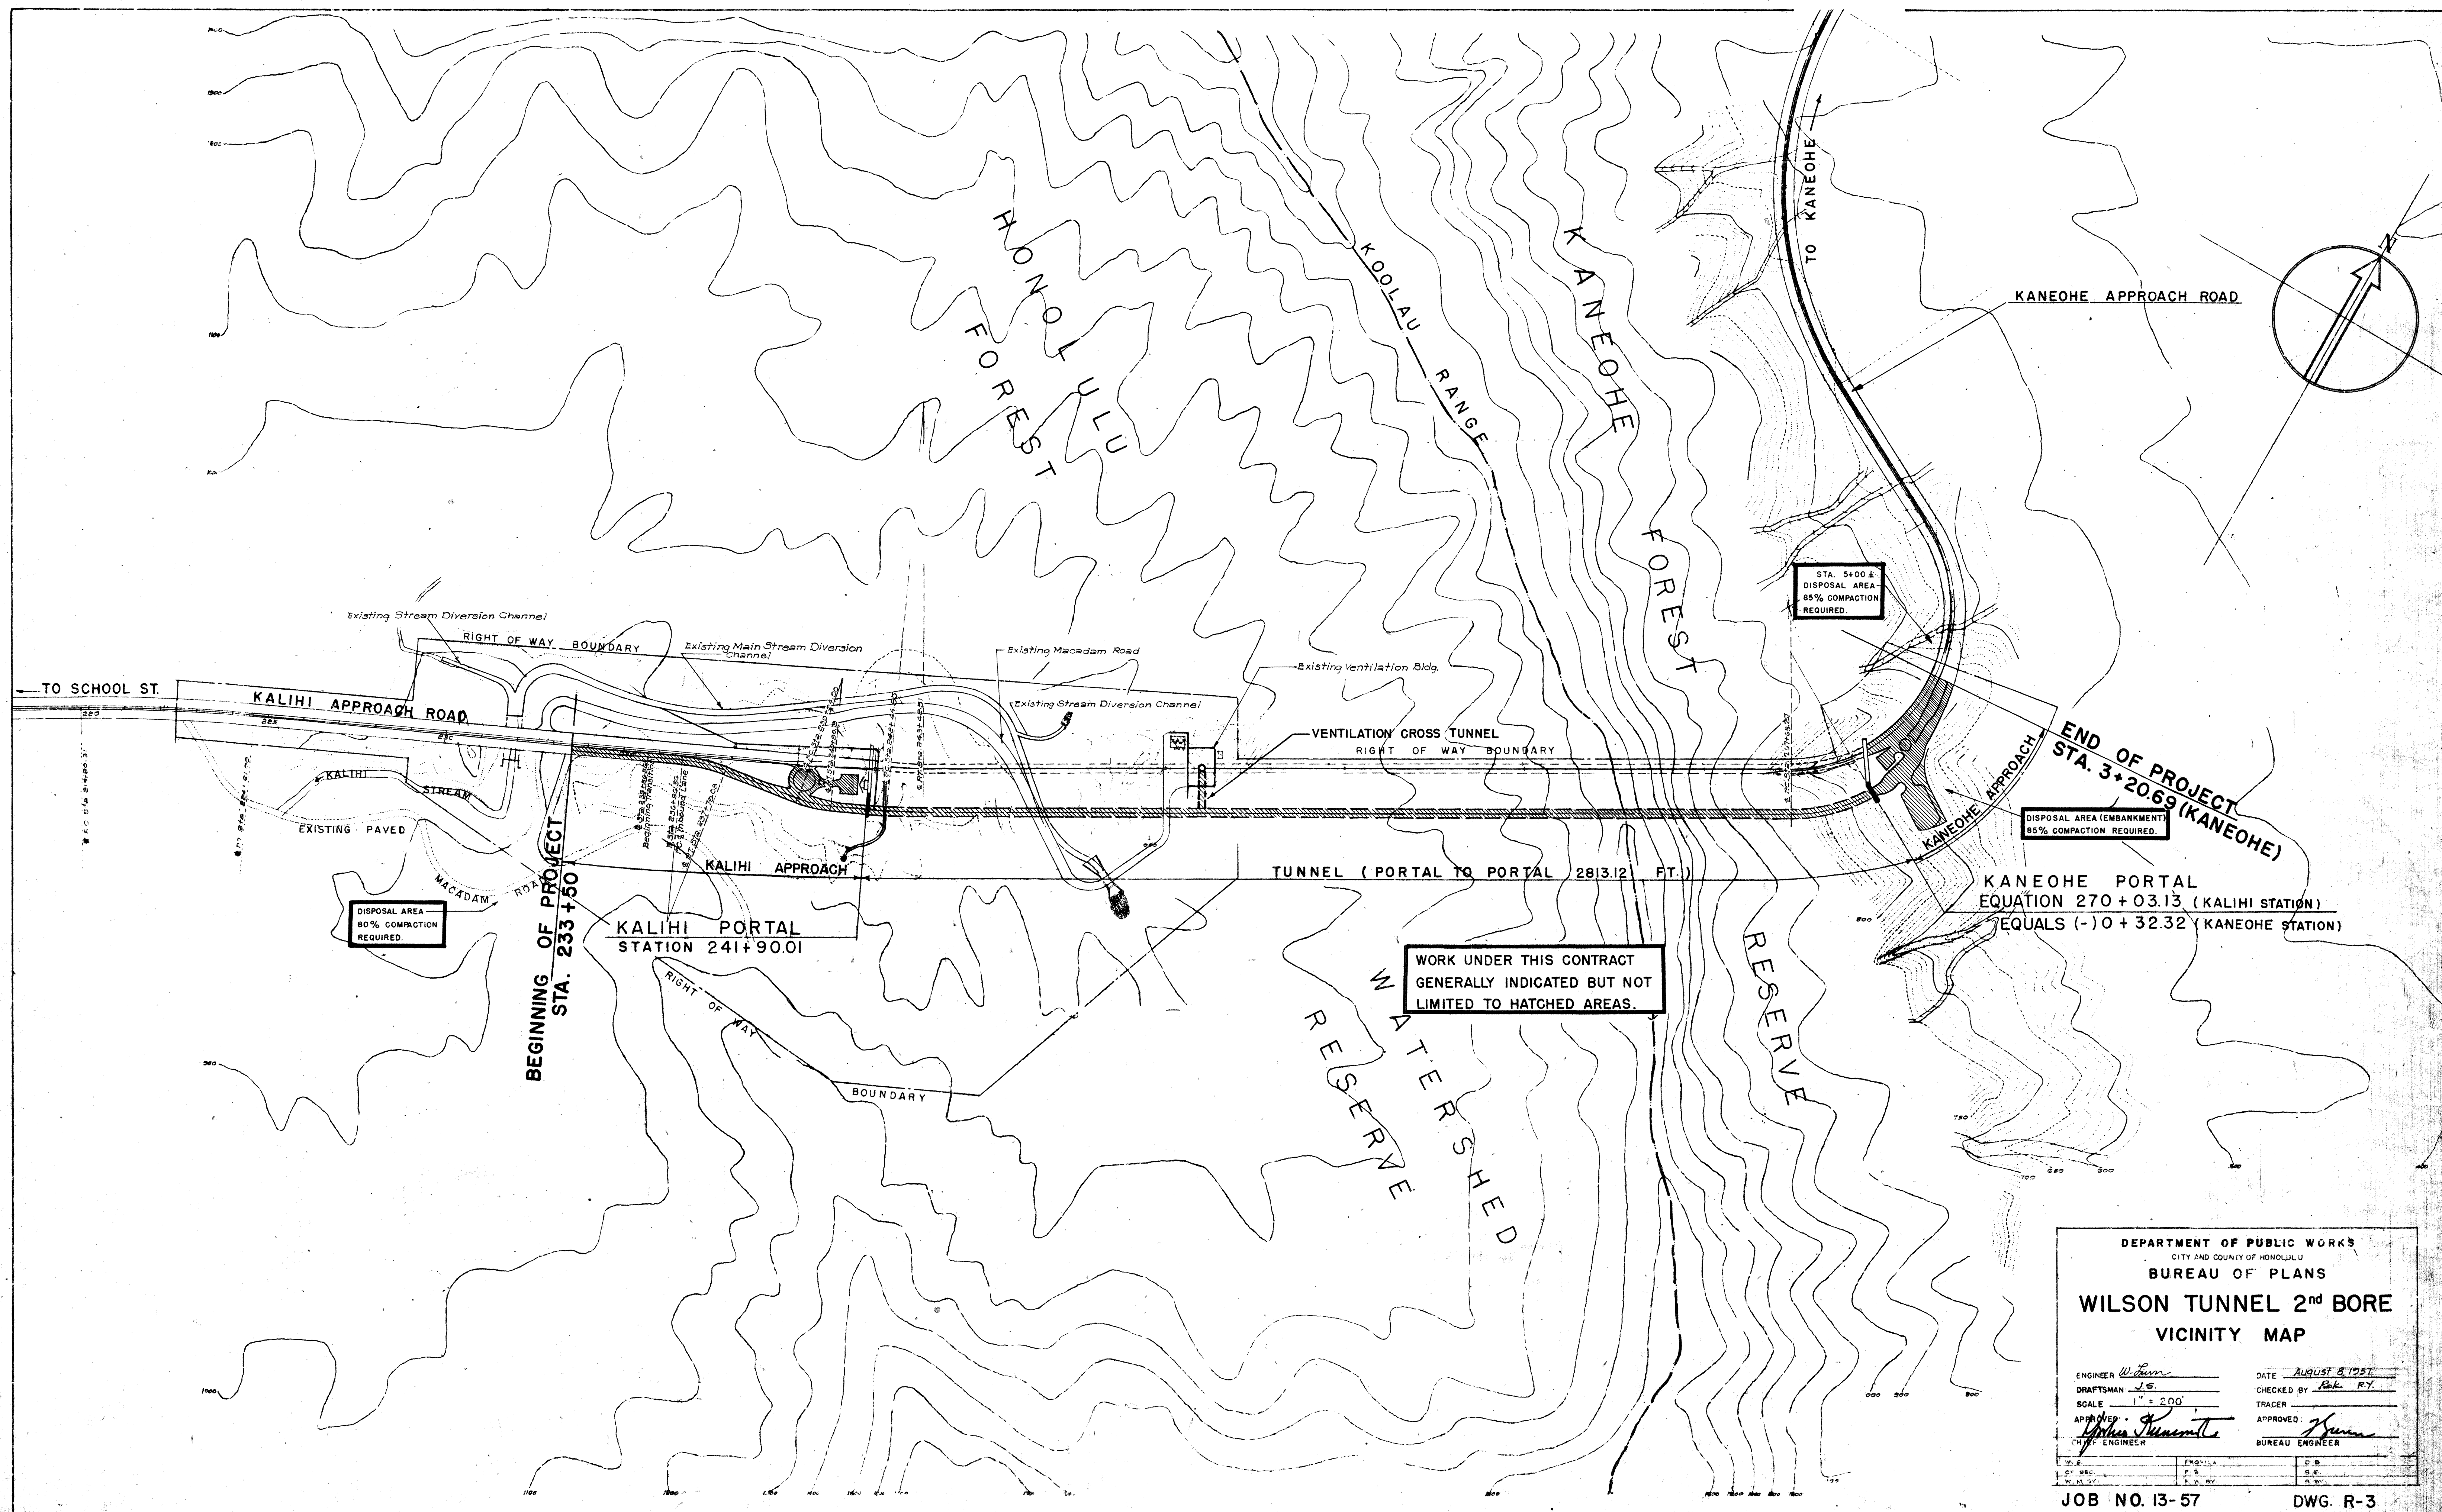

DEPARTMENT OF PUBLIC WORKS CITY AND COUNTY OF HONOLULU			
BUREAU OF PLANS			
WILSON TUNNEL 2 ND BORE			
VICINITY MAP			
ENGINEER <i>W. L. L.</i>	DATE <i>AUGUST 8, 1957</i>		
DRAFTSMAN <i>J. S.</i>	CHECKED BY <i>R. H. R. Y.</i>		
SCALE <i>1" = 200'</i>	TRACER		
APPROVED <i>Arthur H. H.</i>	APPROVED <i>H. H.</i>		
CHIEF ENGINEER	BUREAU ENGINEER		
JOB NO. 13-57 DWG. R-3			