FED. ROAD DIST. NO.	STATE	FED. AID PROJ. NO.	FISCAL YEAR	SHEET NO.	TOTAL SHEETS
HAWAII	HAW.	F-063-1(2)	1966	1	8

INDEX TO DRAWINGS

SHEET NO.	DESCRIPTION
1	TITLE SHEET
2 - 5	GUARD RAIL LAYOUT
6 - 8	STANDARD DETAILS

STATE OF HAWAII
DEPARTMENT OF TRANSPORTATION
HIGHWAYS DIVISION
HONOLULU, HAWAII

"AS BUILT"
PLANS FOR

INSTALLATION OF MEDIAN GUARDRAIL ON LIKELIKE HIGHWAY

KULA KOLEA DRIVE TOWARD KANEOHE

FEDERAL AID PROJECT No. F-063-1(2)

DISTRICTS OF HONOLULU AND KOOLAUPOKO
ISLAND OF OAHU

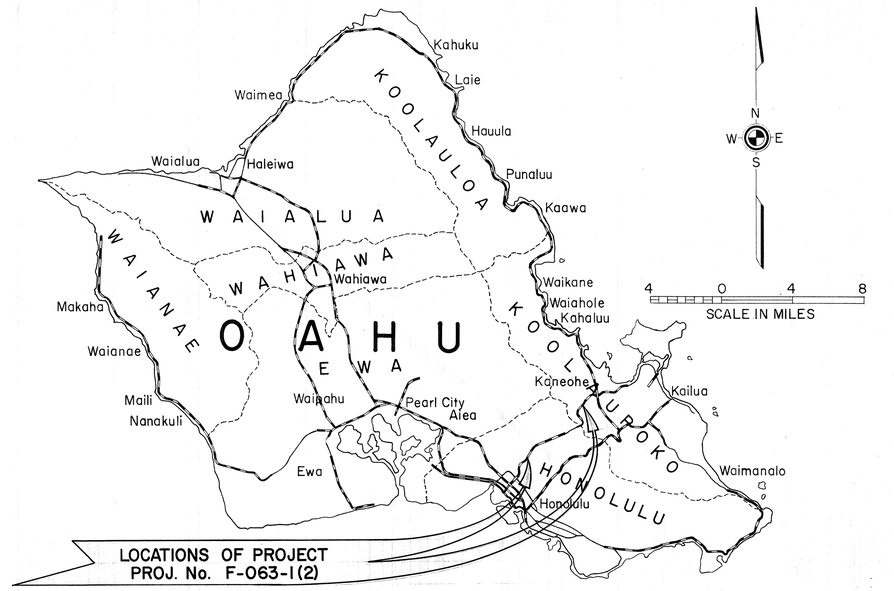

NOTE: ALL CHANGES MADE DURING CONSTRUCTION HAVE BEEN NOTED IN RED ON THESE TRACINGS AND CHECKED BY

Kazuaki Uesumi
PROJ. ENGINEER

2-20-68
DATE

DESIGN CLASSIFICATION

	SECTION "A"	SECTION "B"
ADT (1965)	19,109	19,109
DESIGN ADT (1975)	26,400	30,800
DHV	3,400	4,000
D	80/20	80/20
T	3.5%	3.0%
T_{24}	4.0%	5.0%
V	50 M.P.H.	50 M.P.H.

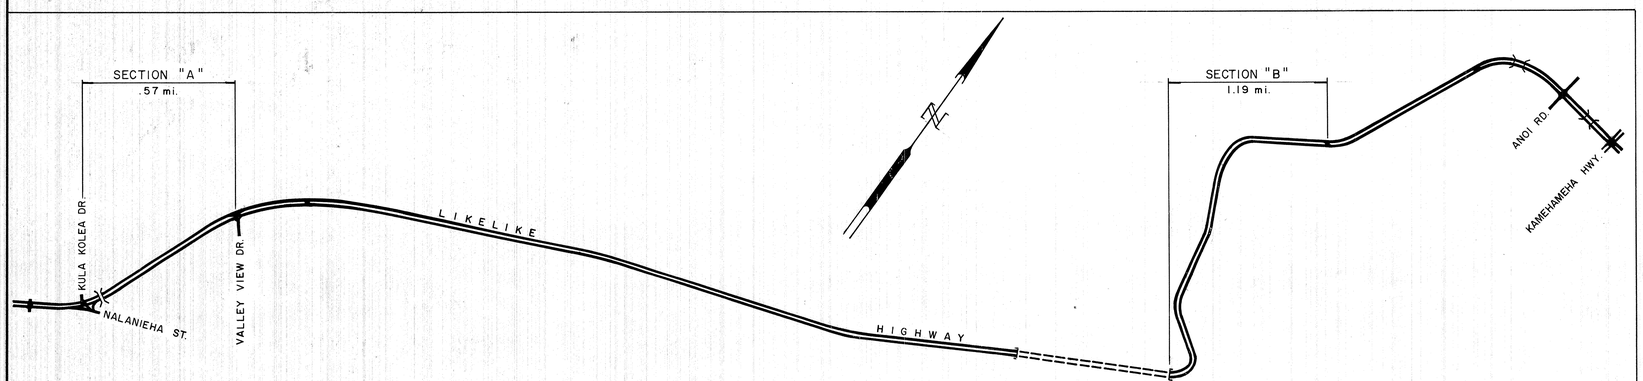

LAYOUT PLAN

NET LENGTH OF PROJECT..... 1.76 mi.

0 0.5 1
SCALE IN MILES

DEPARTMENT OF COMMERCE
BUREAU OF PUBLIC ROADS
APPROVED:
John C. Dallmann
DIVISION ENGINEER
2/21/67
DATE

DEPARTMENT OF TRANSPORTATION
STATE OF HAWAII
APPROVED:
John Mc Shea
FOR DIR. OF TRANSPORTATION
1-4-67
DATE

1