FED ROAD DIST. NO	STATE	FED. AID PROJ. NO.	FISCAL YEAR	SHEET NO.	TOTAL SHEETS
HAWAII	HAW.	F-063-1(3) F-083-1(9)	1969	1	22

INDEX TO DRAWINGS	
SHEET NO.	DESCRIPTION
1	TITLE SHEET
2-3	TYPICAL SECTIONS
4-7	GUARD RAIL LAYOUT
8-10	INTERSECTION DETAILS
11-13	CATCH BASIN RECONSTRUCTION DETAILS
14-22	STANDARD AND MISCELLANEOUS DETAILS

STATE OF HAWAII

DEPARTMENT OF TRANSPORTATION

HIGHWAYS DIVISION

HONOLULU, HAWAII

"AS BUILT" PLANS FOR

INSTALLATION OF MEDIAN GUARD RAIL ON LIKELIKE HIGHWAY

SCHOOL STREET TO KAHEKILI HIGHWAY

FEDERAL AID PROJECT NO. F-063-1(3)

AND

INSTALLATION OF MEDIAN GUARD RAIL ON LIKELIKE HIGHWAY

KAHEKILI HIGHWAY TO KANEOHE BAY DRIVE

FEDERAL AID PROJECT NO. F-083-1(9)

DISTRICTS OF HONOLULU AND KOOLAUPOKO
ISLAND OF OAHU

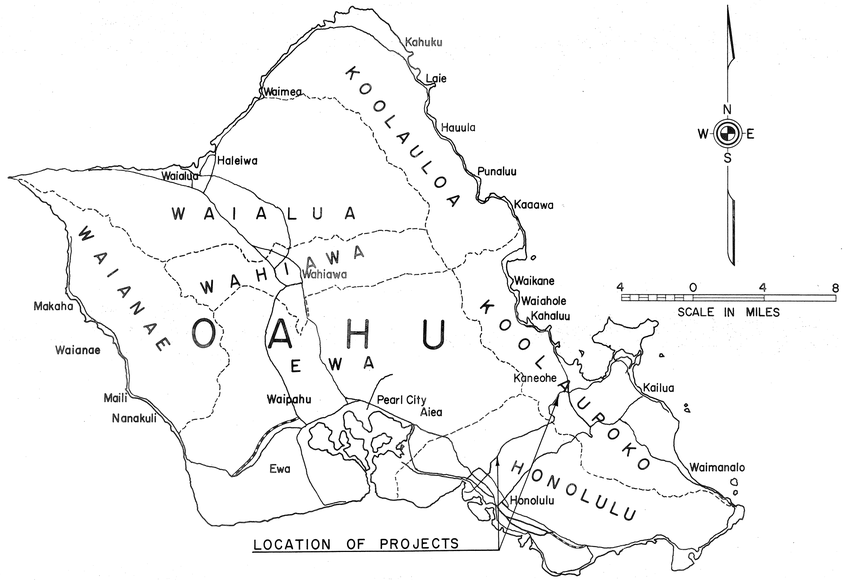

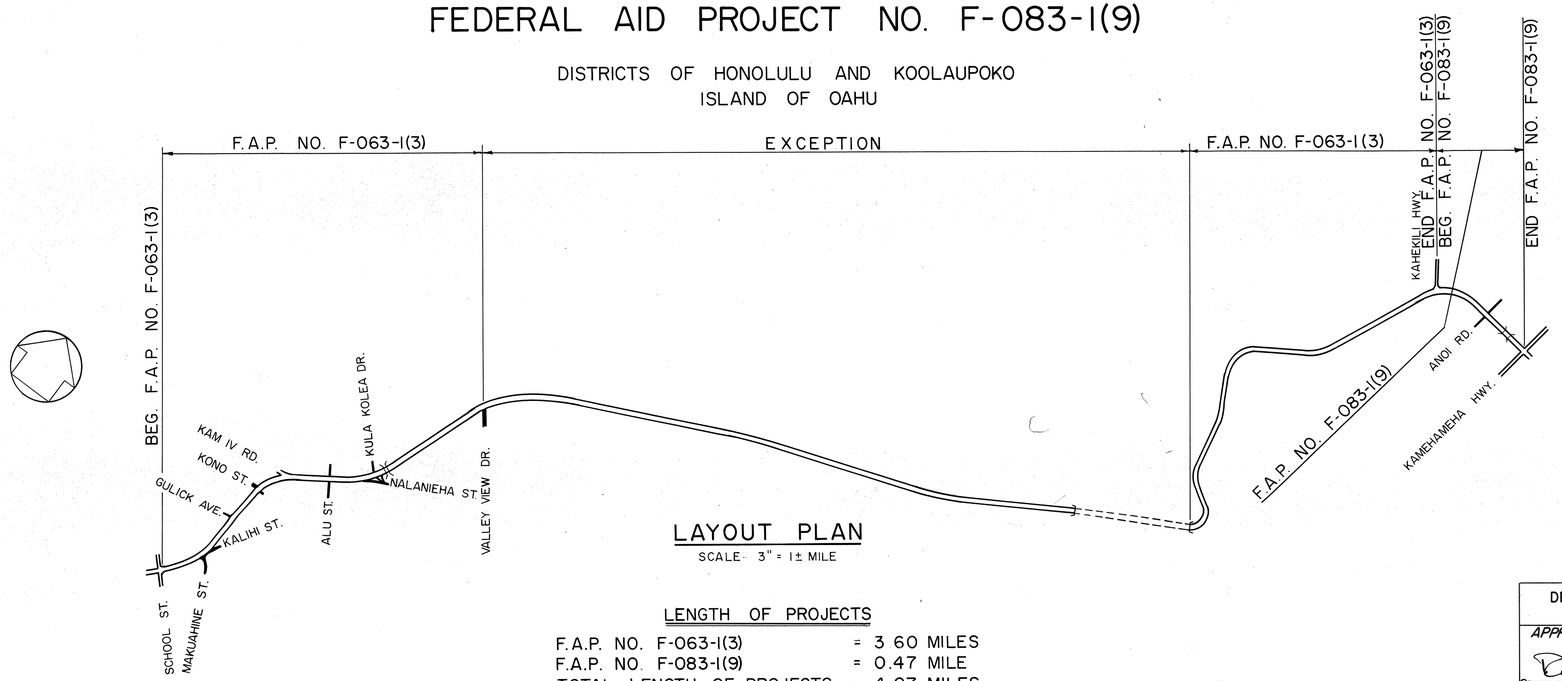

LAYOUT PLAN
SCALE- 3" = 1± MILE

LENGTH OF PROJECTS

F.A.P. NO. F-063-1(3)	= 3.60 MILES
F.A.P. NO. F-083-1(9)	= 0.47 MILE
TOTAL LENGTH OF PROJECTS	= 4.07 MILES

DESIGN ADT (1987).....32,800
CURRENT ADT (1969).....22,000

NO CHANGE WAS MADE DURING CONSTRUCTION OF THIS PROJECT.

R. T. Sanders for RESIDENT ENGINEER — 11-10-81 DATE

DEPARTMENT OF TRANSPORTATION
BUREAU OF PUBLIC ROADS
APPROVED:
Ralph T. Segawa for DIVISION ENGINEER — 7/9/69 DATE

DEPARTMENT OF TRANSPORTATION
STATE OF HAWAII
APPROVED:
E. Alvey Knight for DIR. OF TRANSPORTATION — 6/17/69 DATE

R. Terada June, 1969