FED. ROAD DIST. NO.	STATE	PROJ. NO.	FISCAL YEAR	SHEET NO.	TOTAL SHEETS
HAWAII	HAW.	63A-08-70	1969	1	8

INDEX TO DRAWINGS

SHEET NO.	DESCRIPTION
1	TITLE SHEET
2	TYPICAL SECTION AND MISCELLANEOUS DETAILS
3-5	PLANS
6	STANDARD DETAILS
7	CONSTRUCTION IDENTIFICATION SIGN
8	PROJECT INFORMATION SIGN

STATE OF HAWAII

DEPARTMENT OF TRANSPORTATION

HIGHWAYS DIVISION

HONOLULU, HAWAII

PLANS FOR

RECONSTRUCTING AND RESURFACING LIKELIKE HIGHWAY

OLD FOREST RESERVE BOUNDARY TO WILSON TUNNEL

PROJECT NO. 63A-08-70

DISTRICT OF HONOLULU

ISLAND OF OAHU

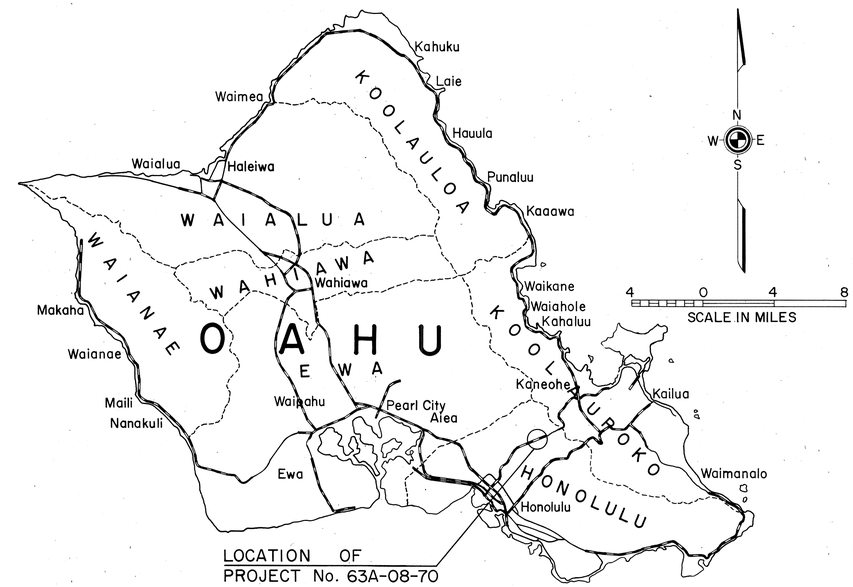

Federal Aid Projects Previously Constructed or Under Construction

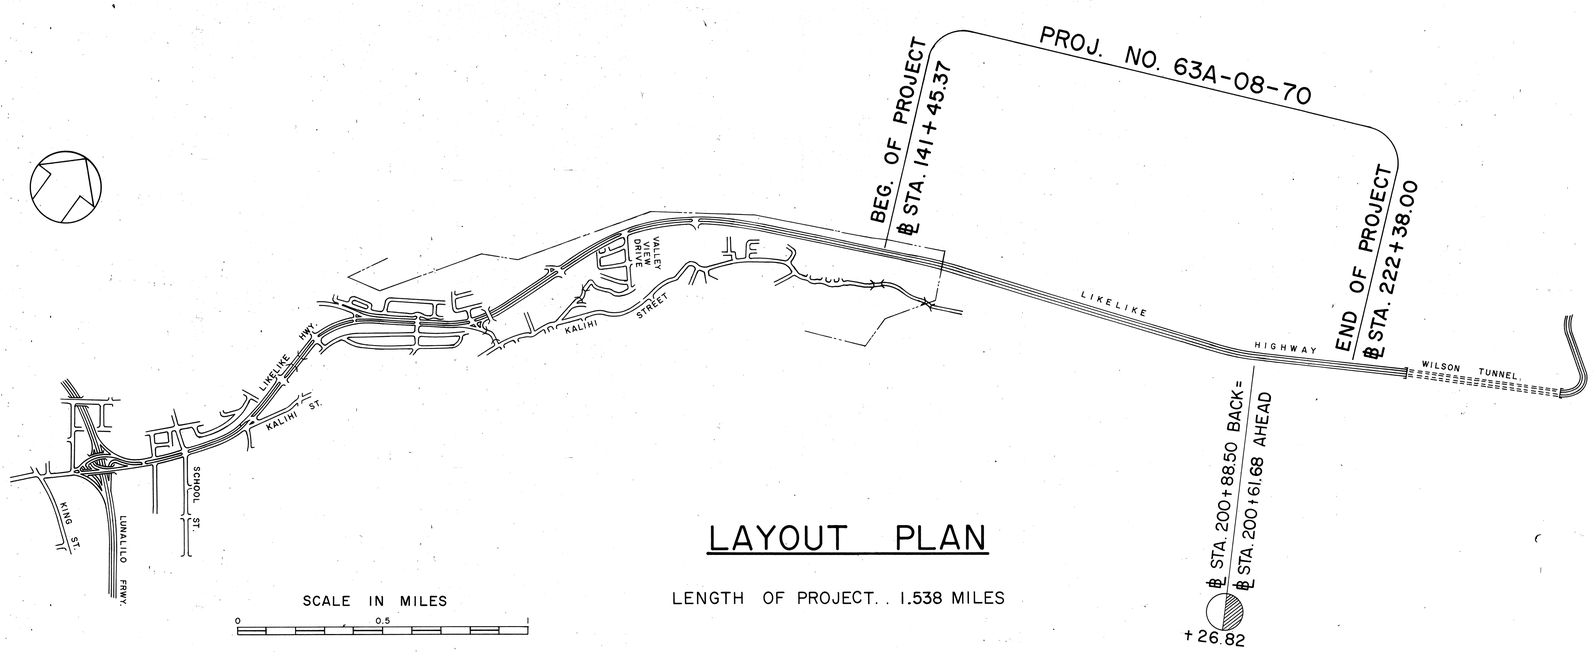

LAYOUT PLAN

LENGTH OF PROJECT. . 1.538 MILES

NO AS BUILT CHANGES

D. Bevier September, 1969

DEPARTMENT OF TRANSPORTATION
STATE OF HAWAII

APPROVED:

E. Alvey Wright 9/26/69

for DIR. OF TRANSPORTATION DATE