INDEX TO DRAWINGS	
SHEET NO.	DESCRIPTION
1	TITLE SHEET
2	PLAN
3-20	DRAINAGE DETAILS

FED. ROAD DIST. NO.	STATE	FED. AID PROJ. NO.	FISCAL YEAR	SHEET NO.	TOTAL SHEETS
HAWAII	HAW.	HES-063-1(13)	1979	1	20

STATE OF HAWAII

DEPARTMENT OF TRANSPORTATION

HIGHWAYS DIVISION

HONOLULU, HAWAII

"AS-BUILT"

PLANS FOR

ROUTE 63: LIKELIKE HIGHWAY

ELIMINATION OF ROADSIDE OBSTACLES

KALIHI STREAM TO KAHEKILI HIGHWAY

FEDERAL AID PROJECT NO. HES-063-1(13)

DISTRICTS OF HONOLULU AND KOOLAUPOKO
ISLAND OF OAHU

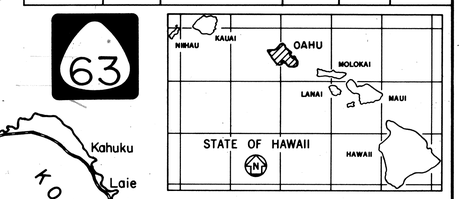

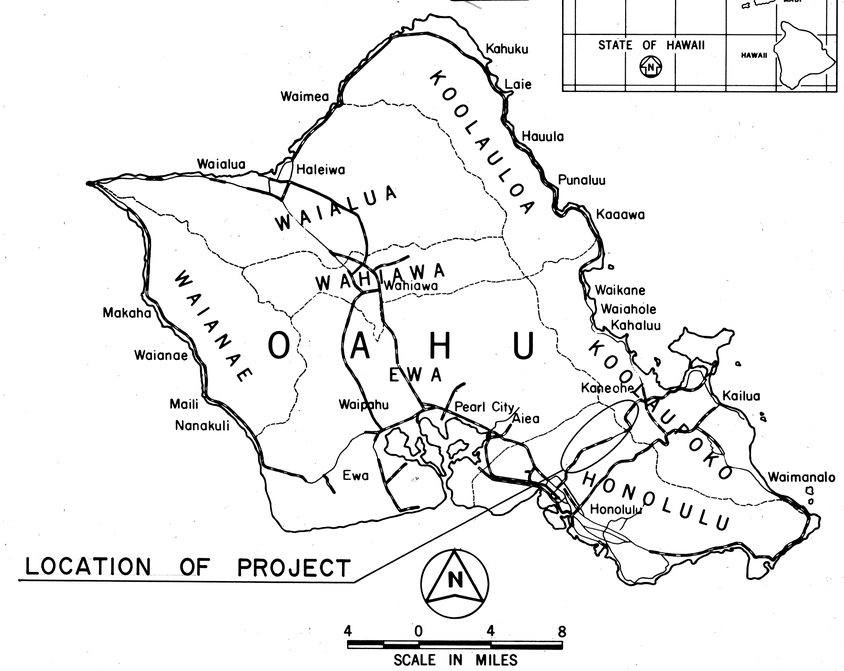

ALL CHANGES MADE DURING CONSTRUCTION HAVE BEEN INCORPORATED ON THESE PLANS IN RED EXCEPT CHANGES IN THE ORIGINAL THEORETICAL QUANTITIES. FOR ACTUAL QUANTITIES, REFER TO PROJECT LEDGER AND/OR COMPUTATION BOOK.

Phillip J. Almasato — RESIDENT ENGINEER — 1/7/81 DATE

FEDERAL AID PROJECTS PREVIOUSLY CONSTRUCTED OR UNDER CONSTRUCTION

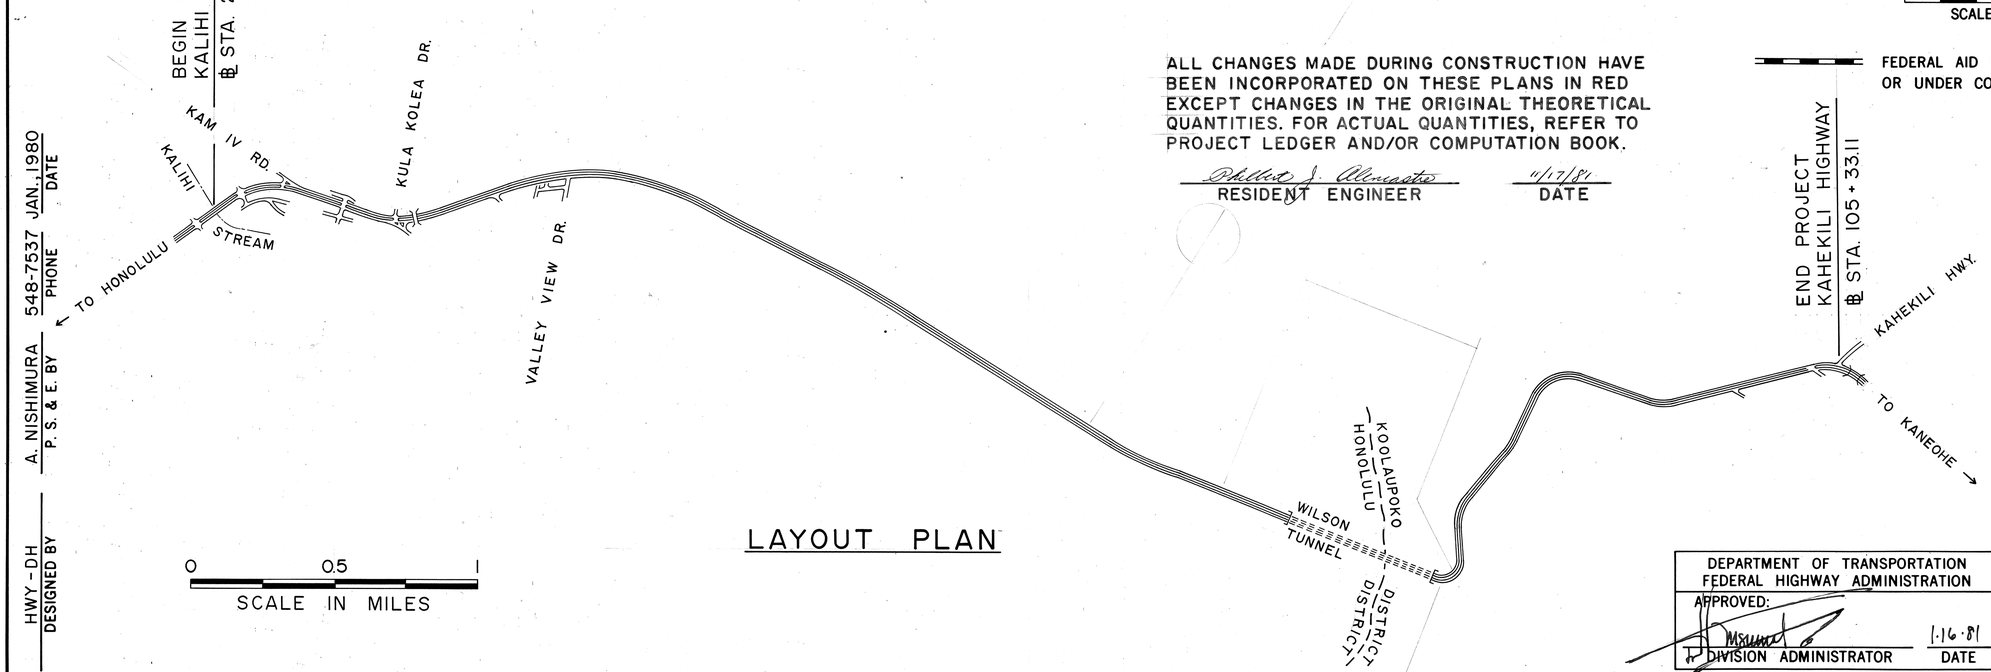

LAYOUT PLAN

HWY-DH	DESIGNED BY
A. NISHIMURA	P. S. & E. BY
548-7537	PHONE
JAN., 1980	DATE

DEPARTMENT OF TRANSPORTATION FEDERAL HIGHWAY ADMINISTRATION	
APPROVED:	
DIVISION ADMINISTRATOR	1-16-81 DATE

DEPARTMENT OF TRANSPORTATION STATE OF HAWAII	
APPROVED:	
DIR. OF TRANSPORTATION	12/24/80 DATE