FED. ROAD DIST. NO.	STATE	PROJ. NO.	FISCAL YEAR	SHEET NO.	TOTAL SHEETS
HAWAII	HAW.	63A-01-86M 63A-02-86	1986	1	58

INDEX TO DRAWINGS

	SHEET NO.	DESCRIPTION
	1	TITLE SHEET
	2	NOTES
	3-5	TYPICAL SECTIONS AND DETAILS
	6	UTILITY ADJUSTMENT SCHEDULES
①	7-17	PLANS
	18-26	ROADWAY TYPICAL AND STANDARD DETAILS
②	27-28	DRAINAGE DETAILS
	29-52	SIGNING AND PAVEMENT MARKING PLANS AND DETAILS
	53-58	CROSS SECTIONS

Plan Sht. Nos. ① CO ADD 17 S-1 ② CO 28 S-1 thru CO 28 S-9 are supplementary to this project. TOTAL SHEET COUNT after "AS BUILT" postings. 68 Sheets.

STATE OF HAWAII

DEPARTMENT OF TRANSPORTATION

HIGHWAYS DIVISION

HONOLULU, HAWAII

"AS BUILT"

PLANS FOR

KALIHI STREET AND LIKELIKE HIGHWAY RESURFACING

NIMITZ HIGHWAY TOWARDS BURMEISTER OVERPASS

PROJECT NO. 63A-01-86M

AND

WHEELCHAIR RAMPS ALONG KALIHI STREET

DILLINGHAM BOULEVARD TO SCHOOL STREET

PROJECT NO. 63A-02-86

DISTRICT OF HONOLULU

ISLAND OF OAHU

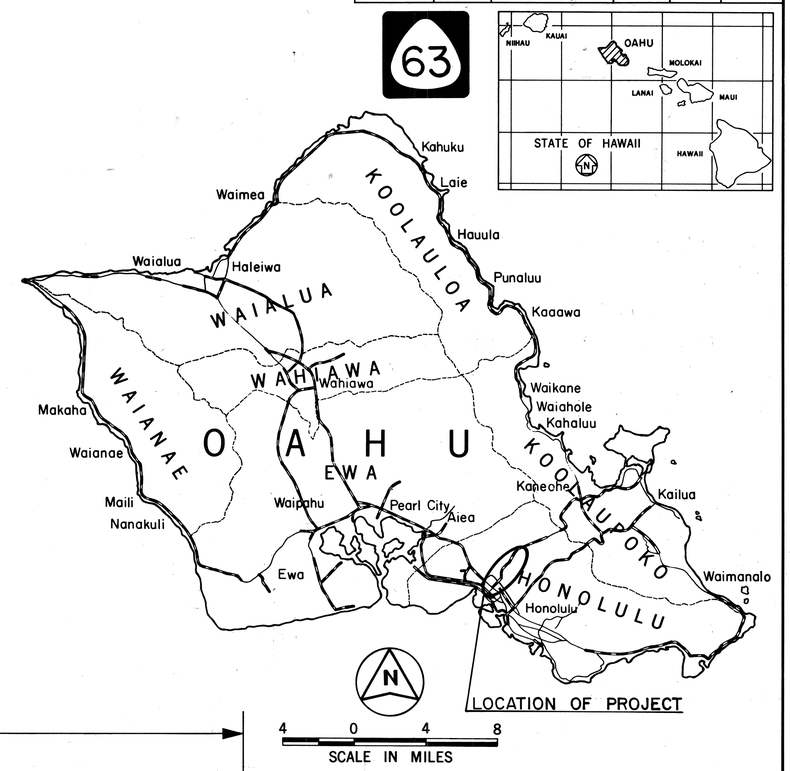

FEDERAL AID PROJECTS PREVIOUSLY CONSTRUCTED OR UNDER CONSTRUCTION

KALIHI STREET AND LIKELIKE HIGHWAY RESURFACING
PROJECT NO. 63A-01-86 M

EXCEPTION: KALIHI ST. INBOUND & OUTBOUND LANES ℄ STA. 2+85± TO ℄ STA. 14+20±

EXCEPTION: LIKELIKE HWY. INBOUND LANES ℄ STA. 7+15± TO ℄ STA. 72+00±

BEGIN PROJECT ℄ STA. 0+45±

℄ STA. 150+00± END PROJECT

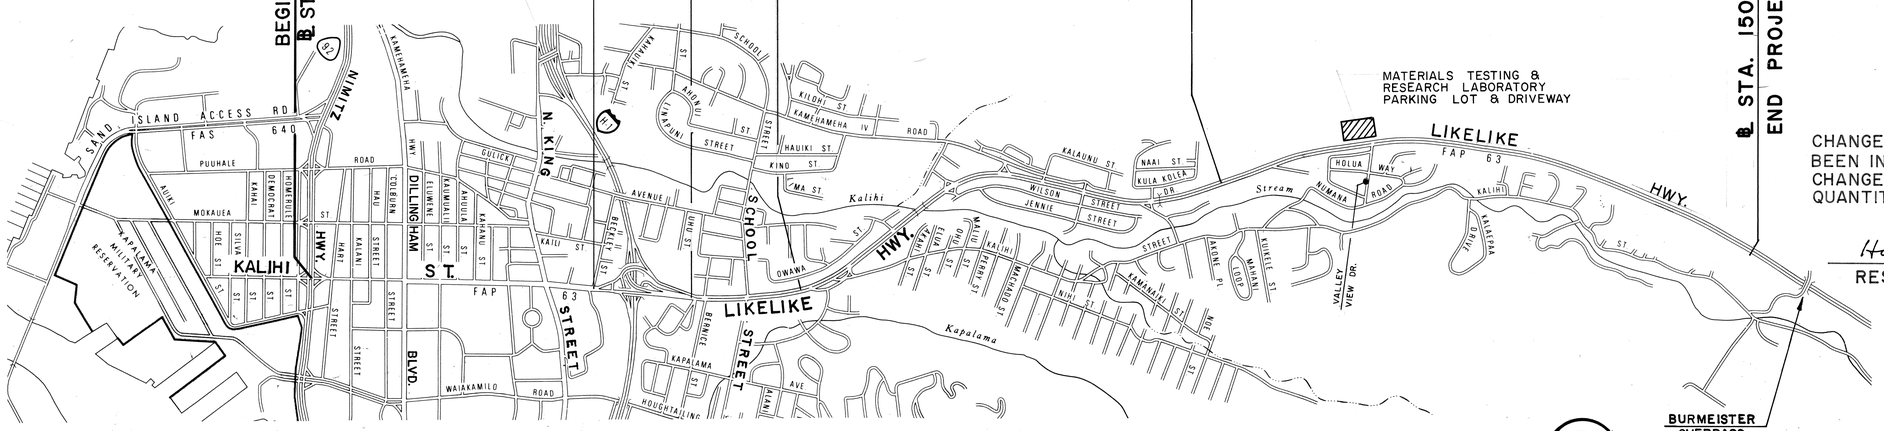

LAYOUT PLAN

GROSS LENGTH OF PROJECT ..... 3.987 MILES
LESS EXCEPTION. ..... 0.215 MILES
NET LENGTH OF PROJECT ..... 3.772 MILES

CHANGES MADE DURING CONSTRUCTION HAVE BEEN INCORPORATED ON THESE PLANS EXCEPT CHANGES IN THE ORIGINAL THEORETICAL QUANTITIES. FOR ACTUAL QUANTITIES.

Howard C.Y. Young — RESIDENT ENGINEER — 11-7-90 DATE

DEPARTMENT OF TRANSPORTATION
STATE OF HAWAII
APPROVED:
Cheryl D. Soon — DIR. OF TRANSPORTATION — 5/29/86 DATE

Roy T. Nagasako — DESIGNED BY
Roy T. Nagasako — P. S. & E. BY
548-2456 — PHONE
June, 1986 — DATE