



FED. ROAD DIST. NO.	STATE	PROJ. NO.	FISCAL YEAR	SHEET NO.	TOTAL SHEETS
HAWAII	HAW.	63A-01-94M	1995	10	11

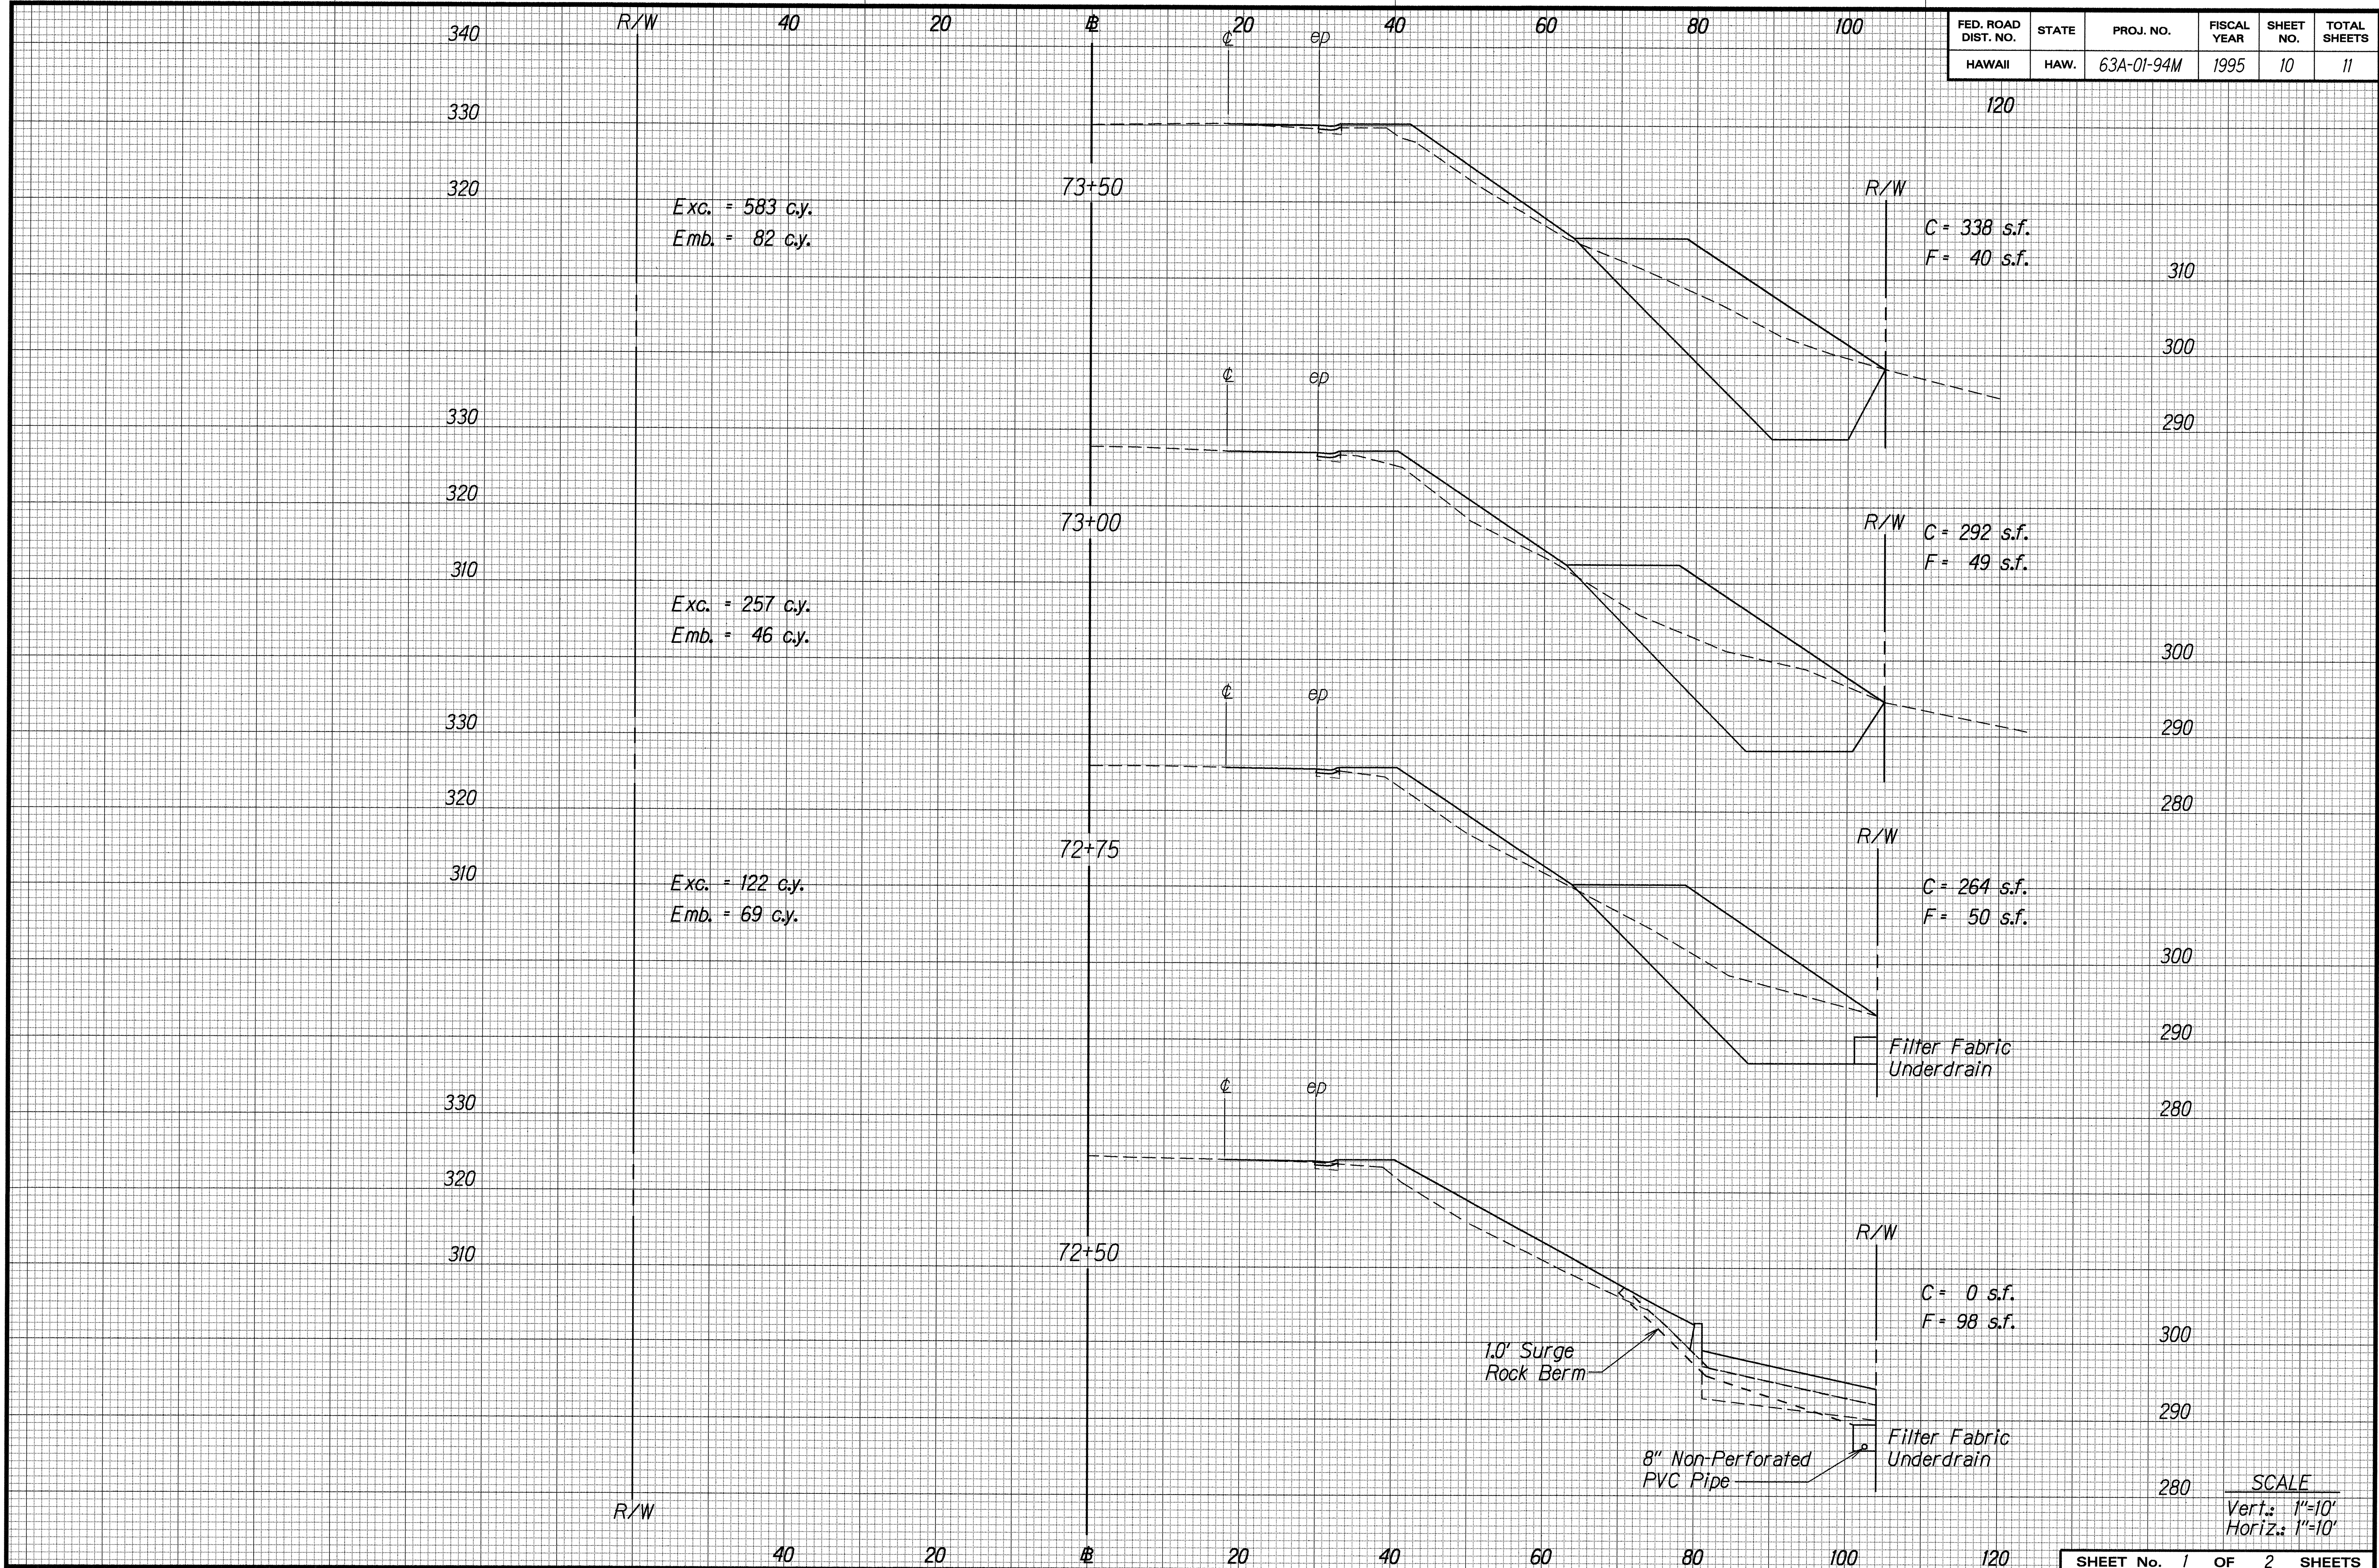

ORIGINAL PLAN	SURVEY PLOTTED BY	DATE
NOTE BOOK	DRAWN BY	12-24-92
QUANTITIES BY	DESIGNED BY	
CHECKED BY	NOTED BY	

FED. ROAD DIST. NO.	STATE	PROJ. NO.	FISCAL YEAR	SHEET NO.	TOTAL SHEETS
HAWAII	HAW.	63A-01-94M	1995	11	11

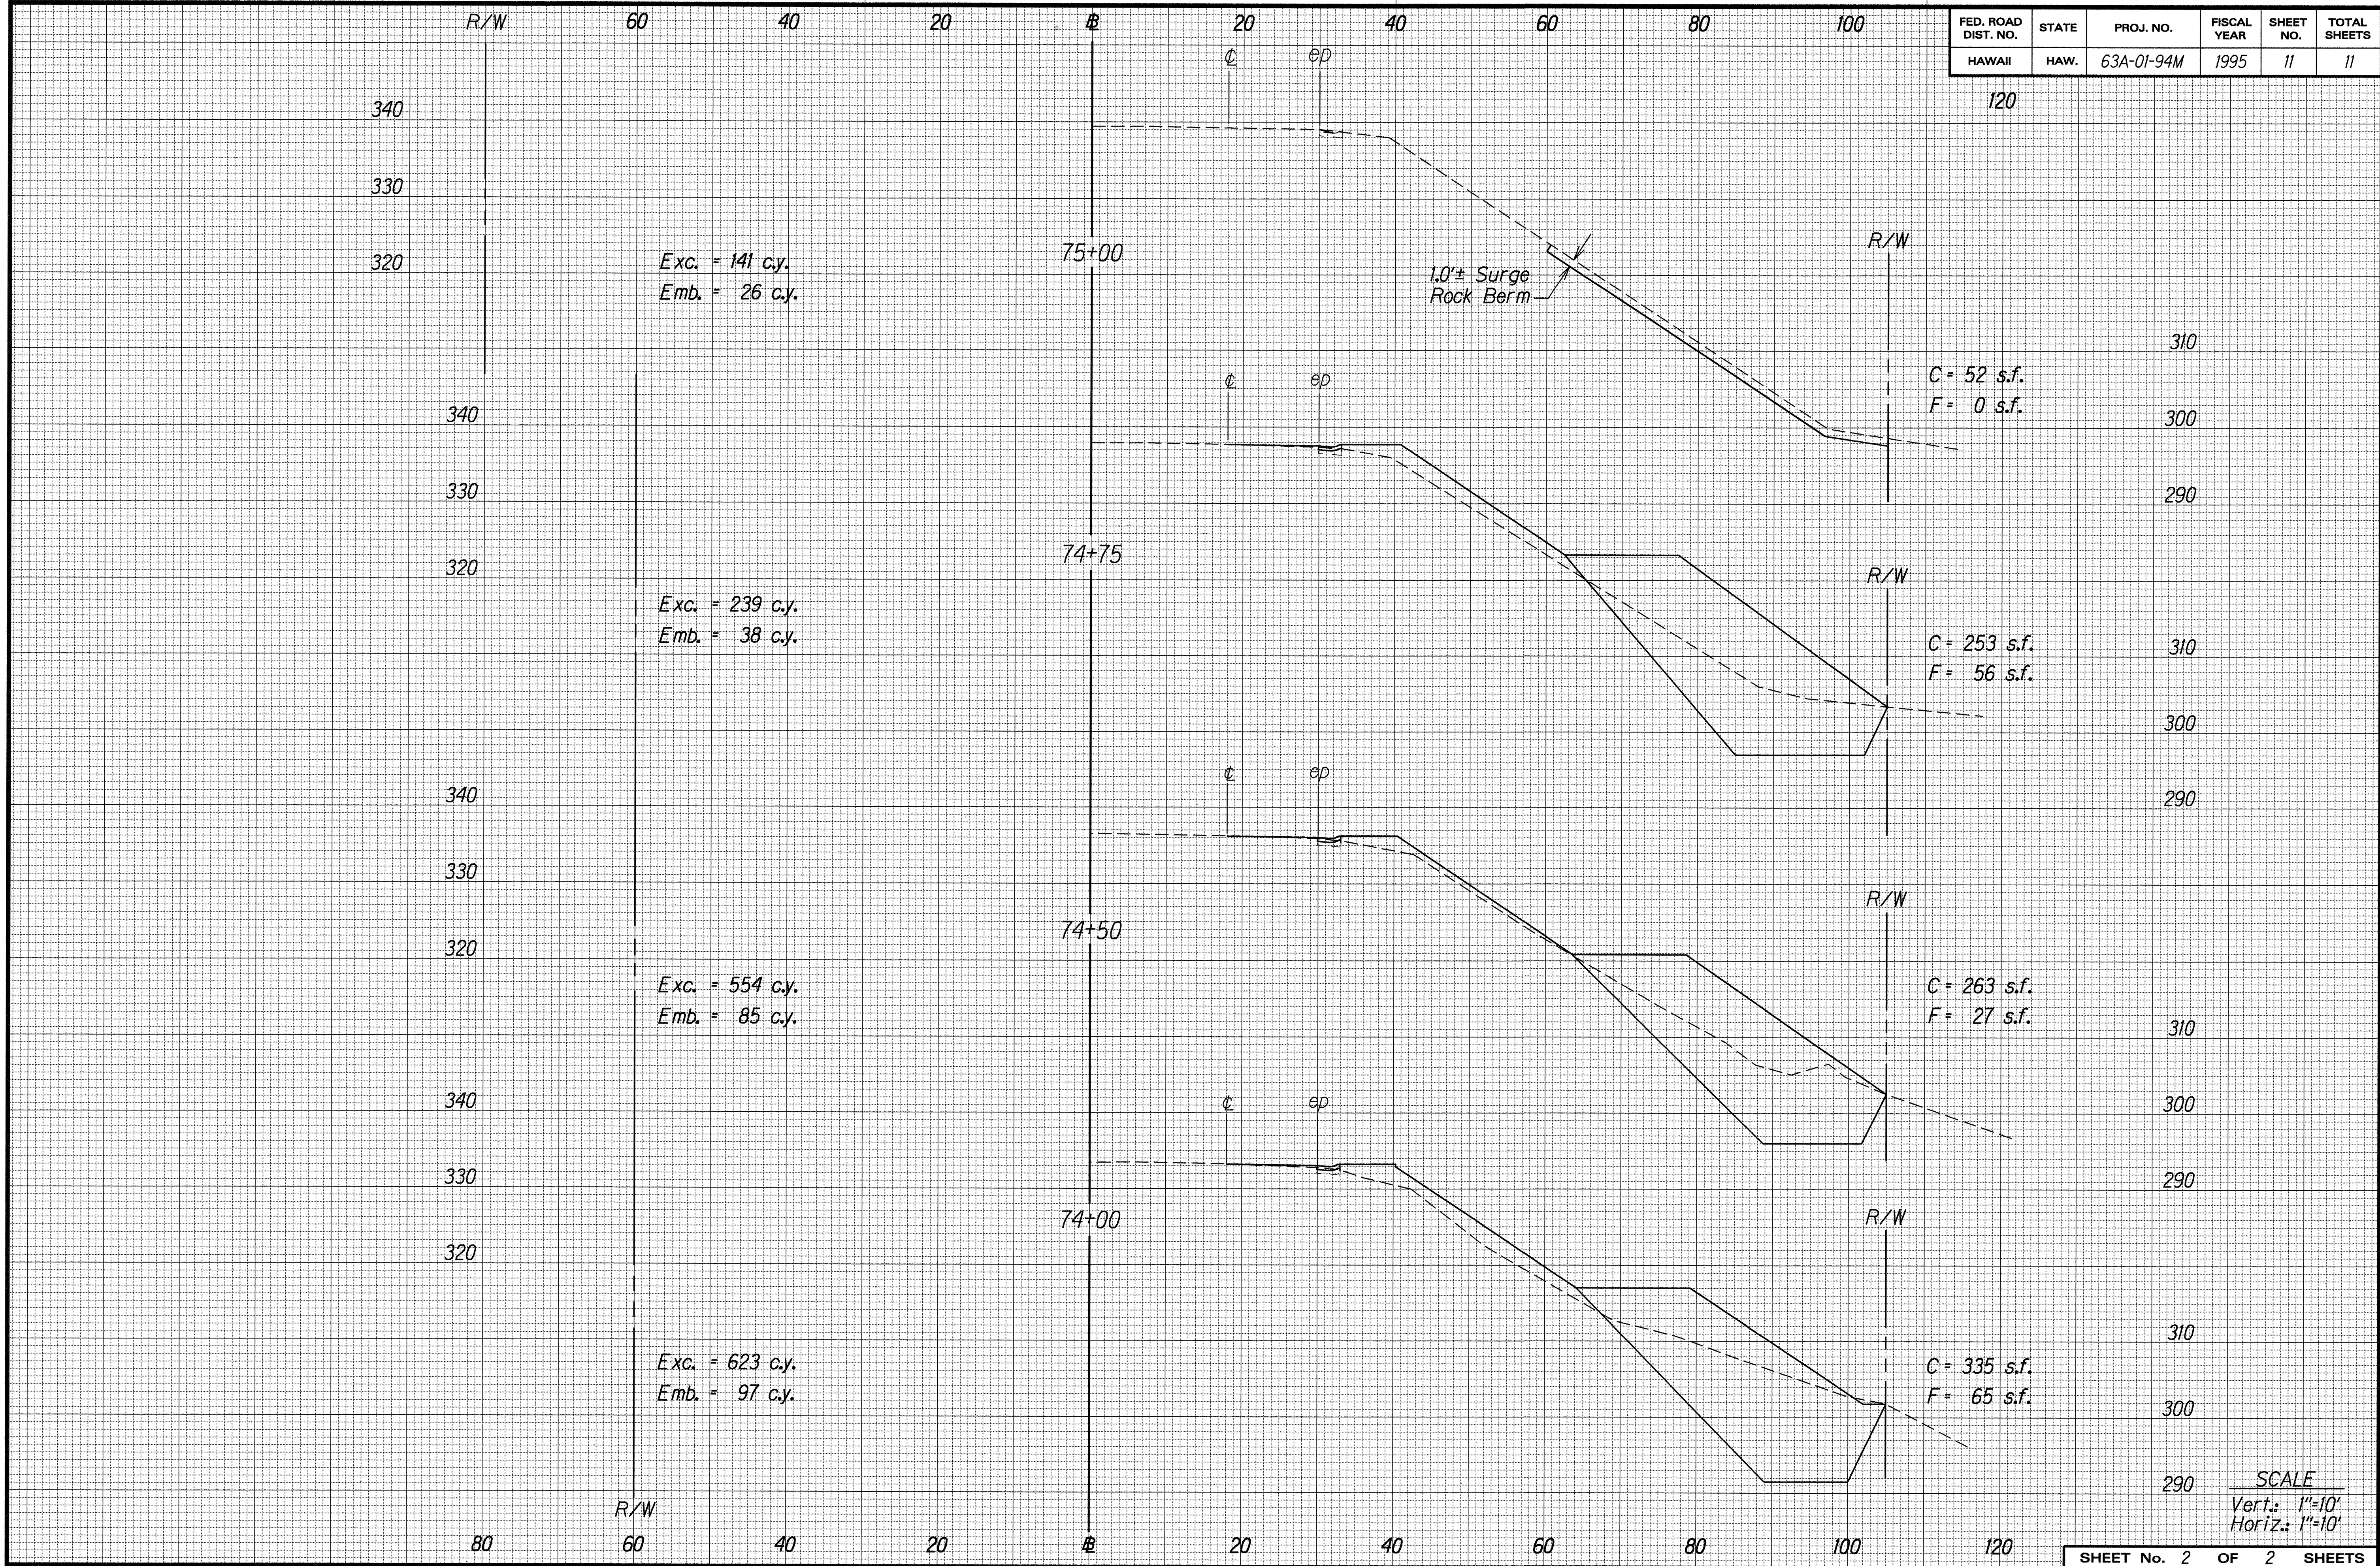

ORIGINAL PLAN	SURVEY PLOTTED BY	DATE
NOTE BOOK	DRAWN BY A. Tanihara/G. Alizola	12-24-95
QUANTITIES BY	DESIGNED BY B. Hironaka, J. Sawa	
CHECKED BY		