


FED. ROAD DIST. NO.	STATE	PROJ. NO.	FISCAL YEAR	SHEET NO.	TOTAL SHEETS
HAWAII	HAW.	63A-02-89	1991	23	23

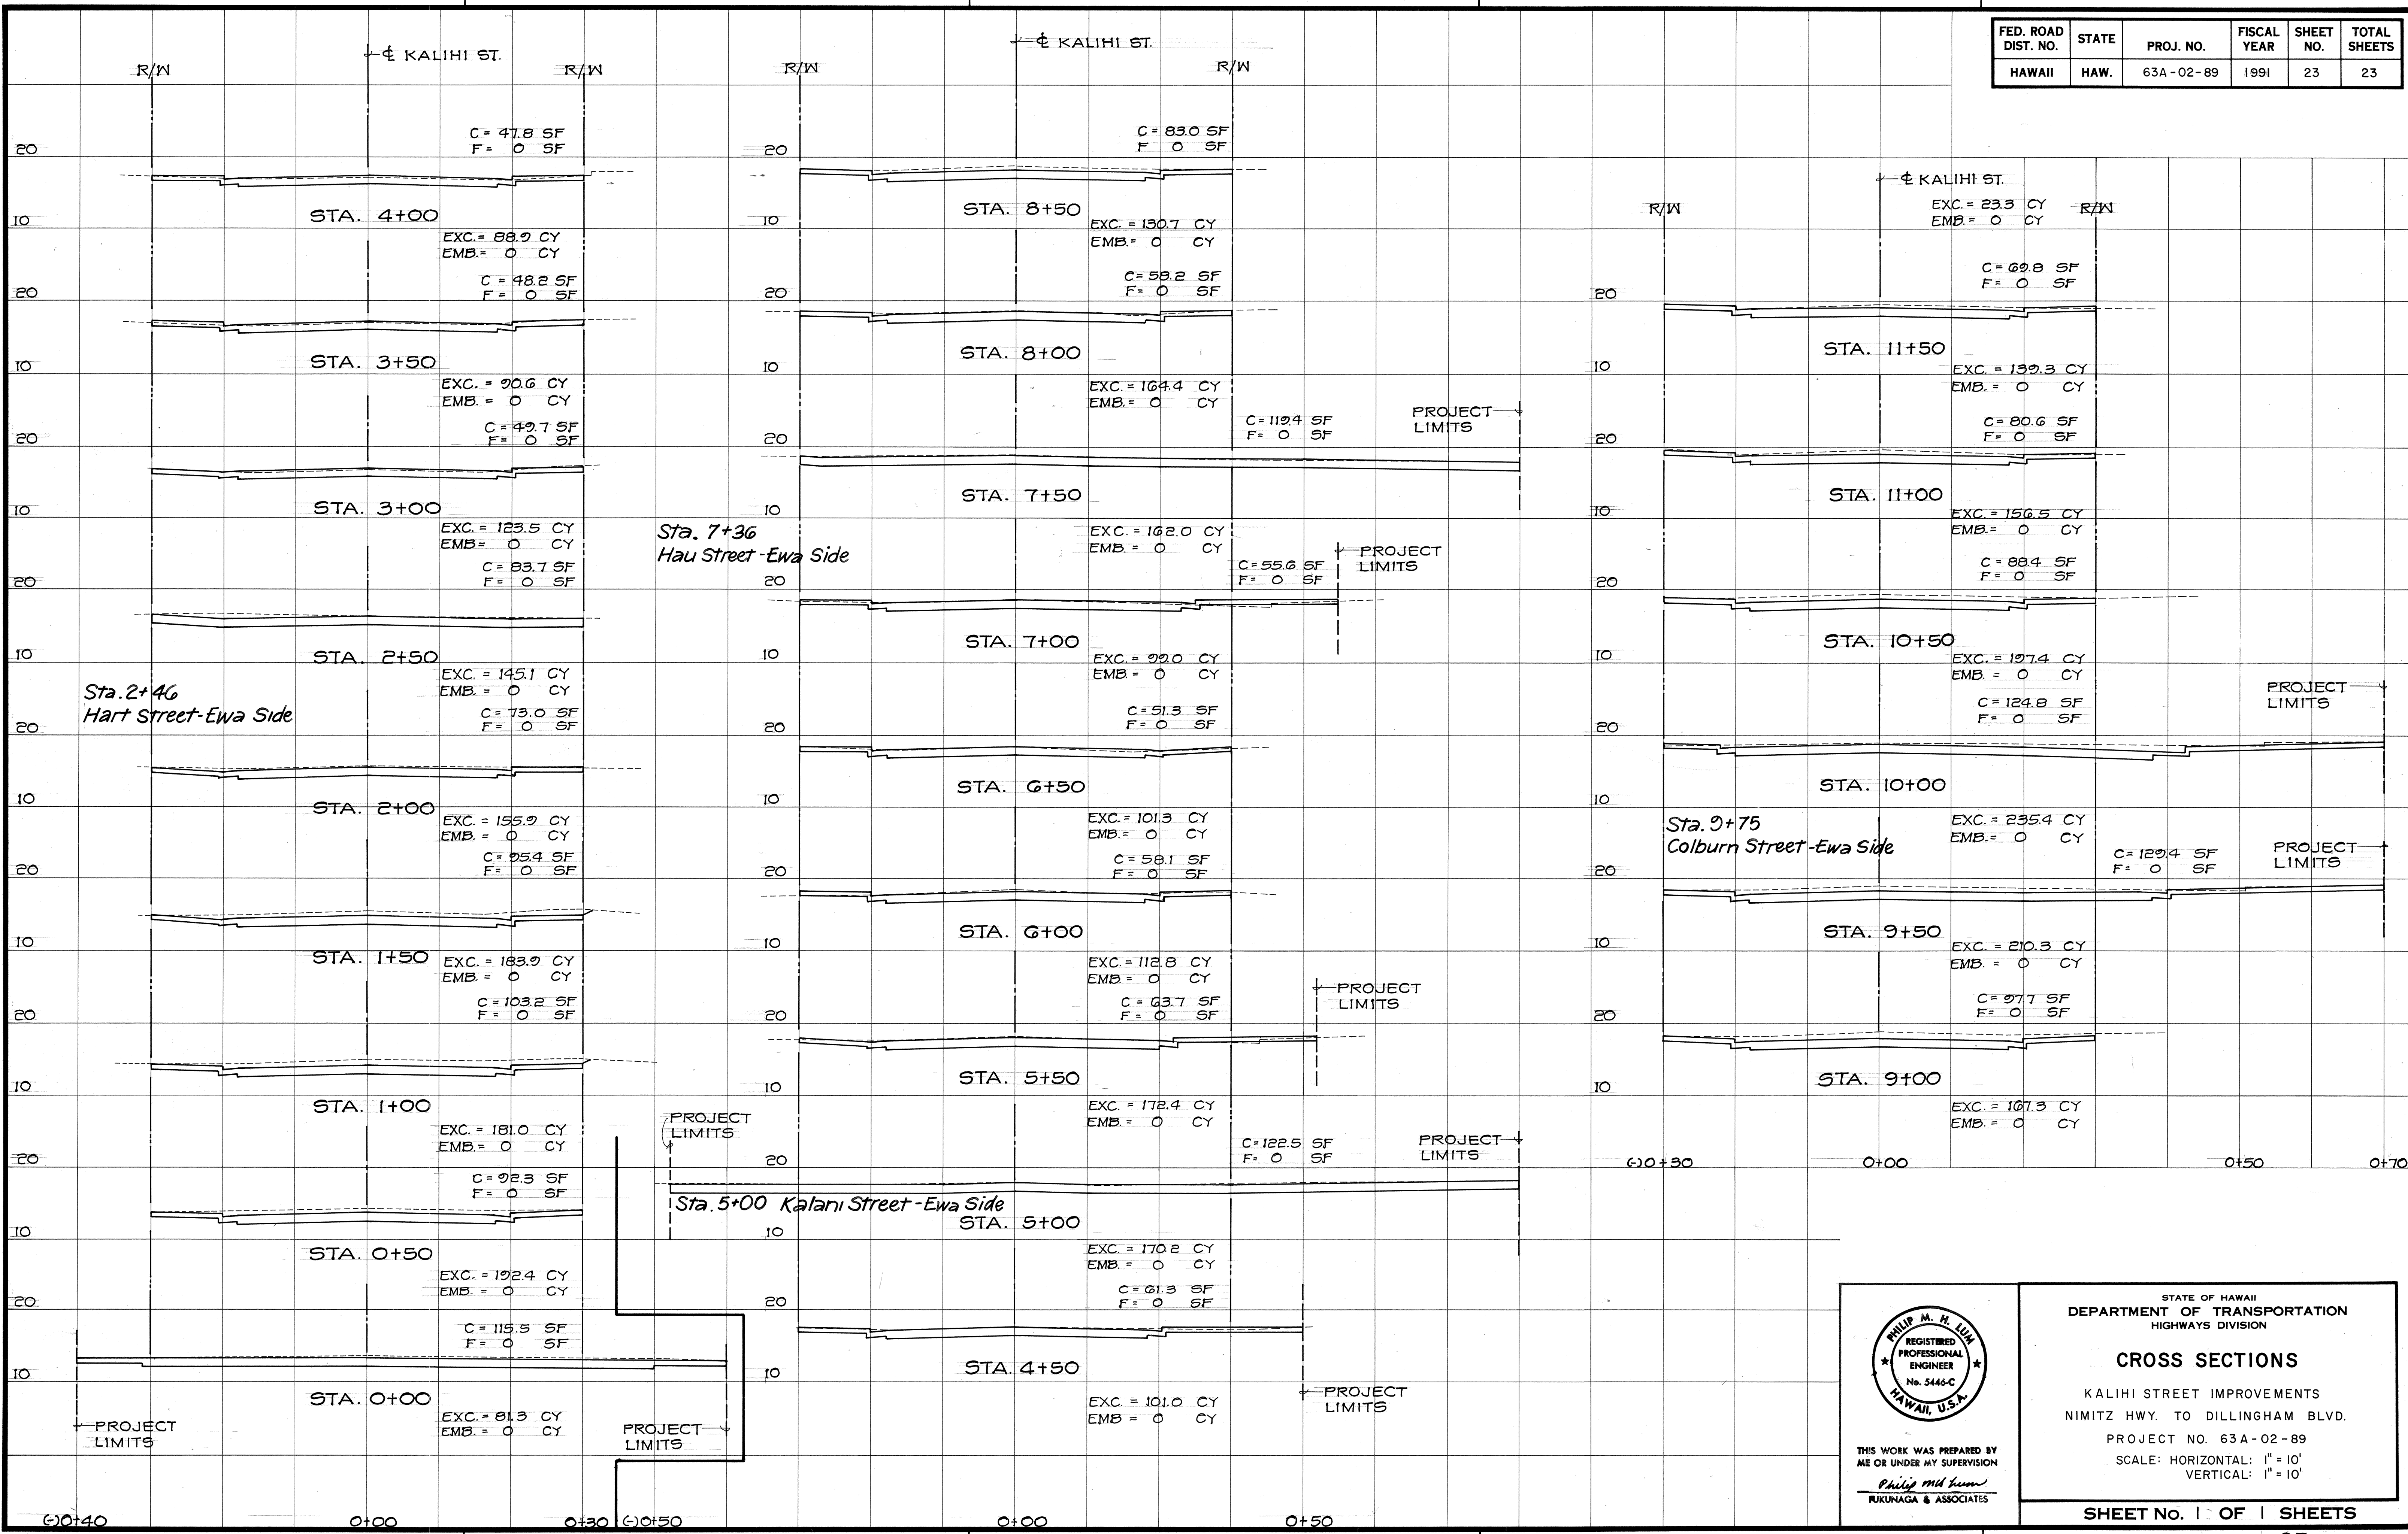

SURVEY PLOTTED BY	DATE
DRAWN BY	
DESIGNED BY	
CHECKED BY	
ORIGINAL PLAN	
NOTE BOOK	
NO.	

THIS WORK WAS PREPARED BY
ME OR UNDER MY SUPERVISION
Philip M. H. Lum
RUKUNAGA & ASSOCIATES

STATE OF HAWAII
DEPARTMENT OF TRANSPORTATION
HIGHWAYS DIVISION

CROSS SECTIONS

KALIHI STREET IMPROVEMENTS
NIMITZ HWY. TO DILLINGHAM BLVD.
PROJECT NO. 63A-02-89
SCALE: HORIZONTAL: 1" = 10'
VERTICAL: 1" = 10'

SHEET NO. 1 OF 1 SHEETS