FED. ROAD DIST. NO.	STATE	FED. AID PROJ. NO.	FISCAL YEAR	SHEET NO.	TOTAL SHEETS
HAWAII	HAW.	HES-063-1(12)	1980	1	44

INDEX TO DRAWINGS

SHT. NO.	DESCRIPTION
1	TITLE SHEET
2	TYPICAL SECTIONS
3	CONSTRUCTION NOTES & RDWY. SECTIONS
4	SITE PLAN
5	PLAN & PROFILE OF RDWY. KALIHI PORTAL
6-7	PLAN & PROFILE OF RDWY. KANEOHE PORTAL
8	KALIHI PORTAL DETAIL PLAN
9	KANEOHE PORTAL DETAIL PLAN
10	I. B. DRAINAGE DETAILS
11	O.B. DRAINAGE DETAILS
12	MISCELLANEOUS DETAILS
13-14	PHASE I & II DETOUR PLANS
15-18	PEAK HOUR DETOUR PLANS
19-37	STANDARD DETAILS
38	OVERHEIGHT DETECTOR SYSTEM
39	OVERHEIGHT DETECTOR DETAILS
40	PAV'T. MARKER & STRIPING AND CHEVRON SIGN PLAN
41-44	CROSS SECTIONS

DEPARTMENT OF PUBLIC WORKS
DIVISION OF ENGINEERING

CITY & COUNTY OF HONOLULU

JOB NO. 28-80

WILSON TUNNEL SAFETY IMPROVEMENTS

FEDERAL AID HAZARD ELIMINATION SAFETY PROGRAM PROJECT NO. HES-063-1(12)

DISTRICT OF KOOLAUPOKO
ISLAND OF OAHU

J. WANG — DESIGN BY
J. WANG — D.P.W. C&C OF HONO. — PS&E BY
523-4041 — PHONE
9/25/80 — DATE

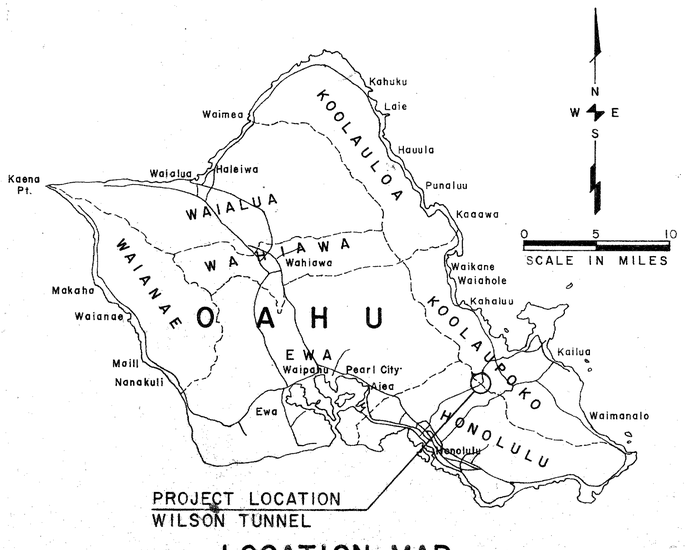

LOCATION MAP

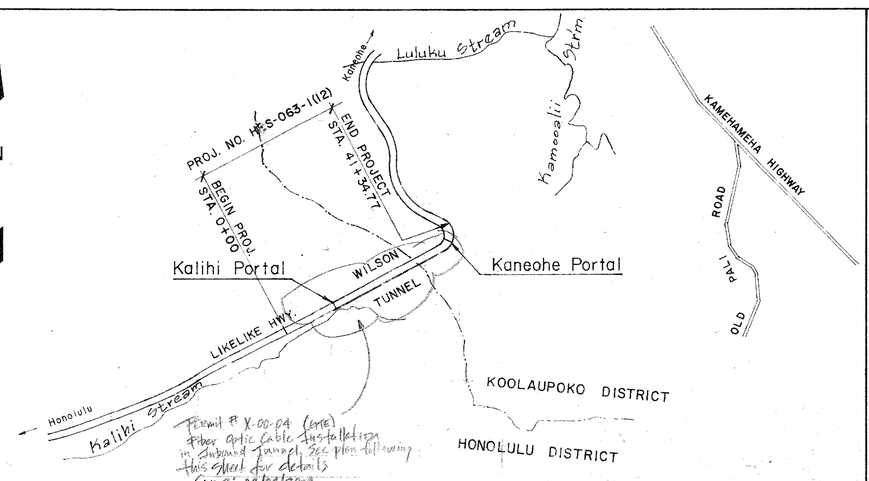

DESIGN DESIGNATION

ADT (NOV. 1978)	40,793
V	40 MPH
DHV (A.M. PEAK)	3,263
D	81.4/18.6 %
T	4.0%

LAYOUT PLAN NOT TO SCALE
LENGTH OF PROJECT 0.8 MILES

APPROVED:

DIRECTOR & CHIEF ENGINEER, DEPT. OF PUBLIC WORKS, CITY AND COUNTY OF HONOLULU	10/23/80 DATE
DIRECTOR, DEPARTMENT OF TRANSPORTATION SERVICES, CITY AND COUNTY OF HONOLULU	11/17/80 DATE
DIRECTOR, DEPARTMENT OF TRANSPORTATION STATE OF HAWAII	11/5/80 DATE
DIVISION ADMINISTRATOR, DEPARTMENT OF TRANSPORTATION, FEDERAL HIGHWAY ADMINISTRATION	11.6.80 DATE

Completed - 5/18/82

Sheet 1 of 44 Sheets

FILE	POCKET	FOLDER	NO.
8	13	2	1