INDEX TO DRAWINGS	
SHEET NO.	DESCRIPTION
1	Title Sheet
2	Typical Sections
3-7	Plan & Profile
8	Standard Details
9	" "
10	" "
11	" "
12	Culvert Details
13	Adjusting ℄ Sewer Manhole Detail
Note:	No Cross Sections

All changes made during construction have been shown in red on these tracings and checked by
Alfred. L. Rush
Resident Engineer.
Date July 11, 1945

Centerline 55
Boundary Lines, or
Fences (Noted), or
Existing Roadway
Circular Concrete Culvert
Railroad
Telephone Pole T.P.
Electric Power Line Pole E.P.
Sewer Manhole S.M.H.
Telephone Manhole T.M.H.
Fire Hydrant F.H.

TERRITORY OF HAWAII
TERRITORIAL HIGHWAY DEPARTMENT
HONOLULU - T. H.

PLANS OF

SAND ISLAND ACCESS ROAD

HAWAII PROJECT NO. DA-WR 5 (I)

HONOLULU DISTRICT
ISLAND OF OAHU

FED. ROAD DIST. NO.	STATE	FED. AID PROJ. NO.	FISCAL YEAR	SHEET NO.	TOTAL SHEETS
HAWAII	HAW	DA-WR 5(1)	1944	1	13

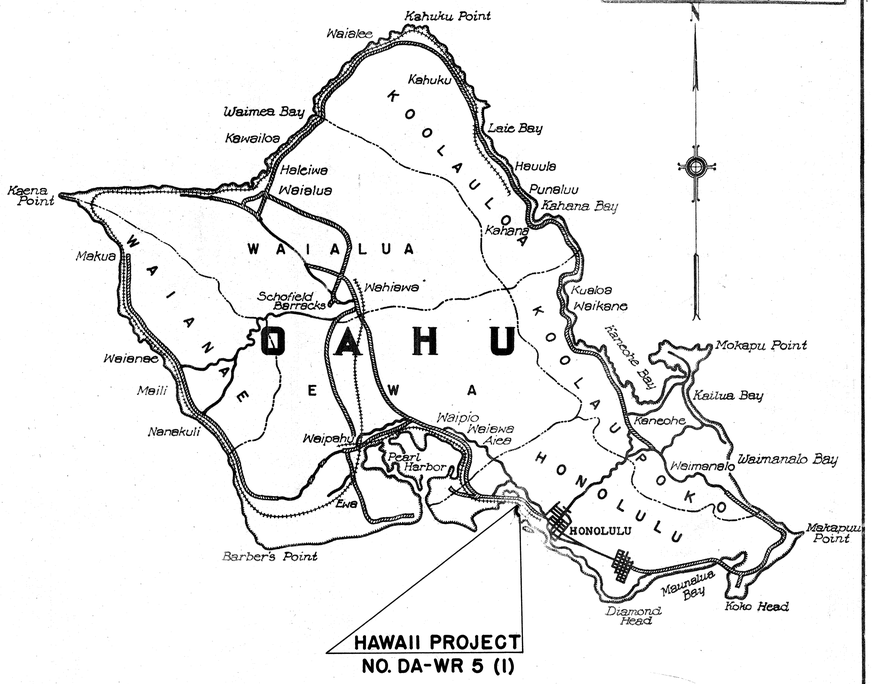

Federal Aid Projects Previously Constructed Or Under Construction

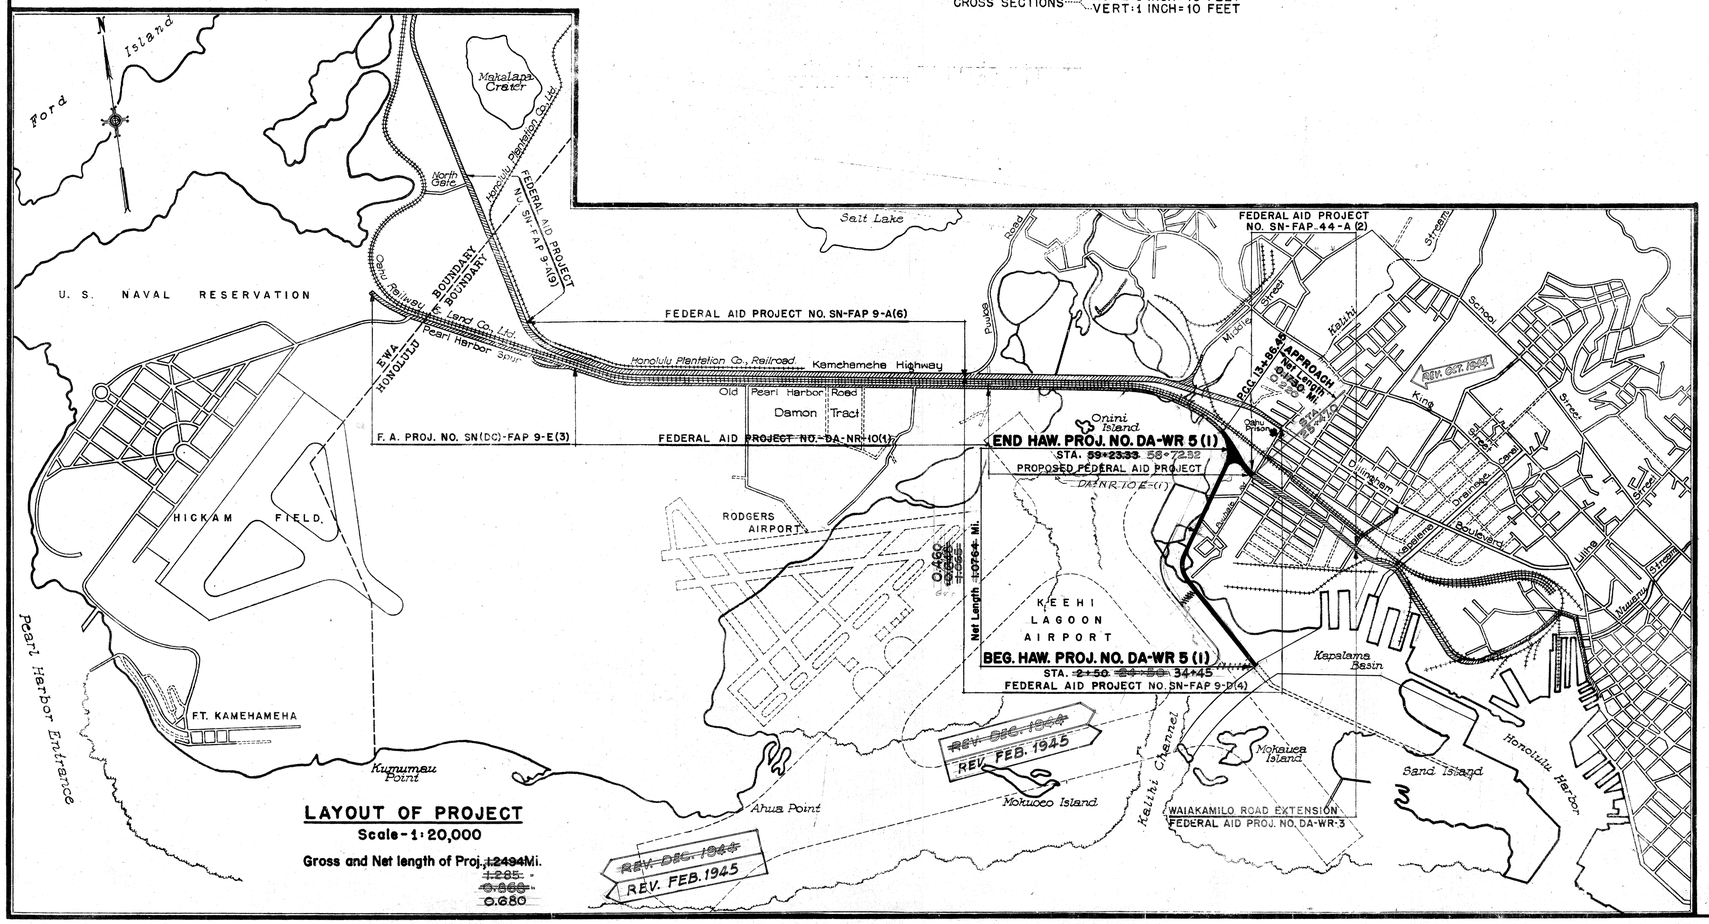

LAYOUT OF PROJECT
Scale - 1:20,000

Gross and Net length of Proj. ~~1.2494~~ Mi.
~~1.295~~
~~0.866~~
0.880

REV. DEC. 1944
REV. OCT. 1944
REV. FEB. 1945

APPROVED
B. F. Rush
Territorial Highway Engineer
Date: 7-17-44

RECOMMENDED FOR APPROVAL
• PRINCIPAL HIGHWAY ENGINEER •
Public Roads Administration,
Federal Works Agency

RECOMMENDED FOR APPROVAL
• CHIEF: WESTERN REGION •
Public Roads Administration,
Federal Works Agency

APPROVED
• • • COMMISSIONER • • •
Public Roads Administration
Federal Works Agency

5136.1