FED. ROAD DIST. NO.	STATE	PROJ. NO.	FISCAL YEAR	SHEET NO.	TOTAL SHEETS
HAWAII	HAW.	64A-01-82M	1982	1	14

INDEX TO DRAWINGS

SHEET NO.	DESCRIPTION
1	TITLE SHEET
2	TYPICAL SECTIONS
3	GENERAL NOTES & LEGEND
4 - 6	ROADWAY PLANS
7	MISCELLANEOUS DETAILS
8 - 11	PAVEMENT MARKINGS PLANS
12 - 14	STANDARD DETAILS

STATE OF HAWAII

DEPARTMENT OF TRANSPORTATION

HIGHWAYS DIVISION

HONOLULU, HAWAII

"AS BUILT" PLANS FOR

SAND ISLAND ACCESS ROAD RESURFACING

Sand Island Park to Nimitz Highway (Bascule Bridge to Nimitz Highway)

PROJECT NO. 64A-01-82M

DISTRICT OF HONOLULU

ISLAND OF OAHU

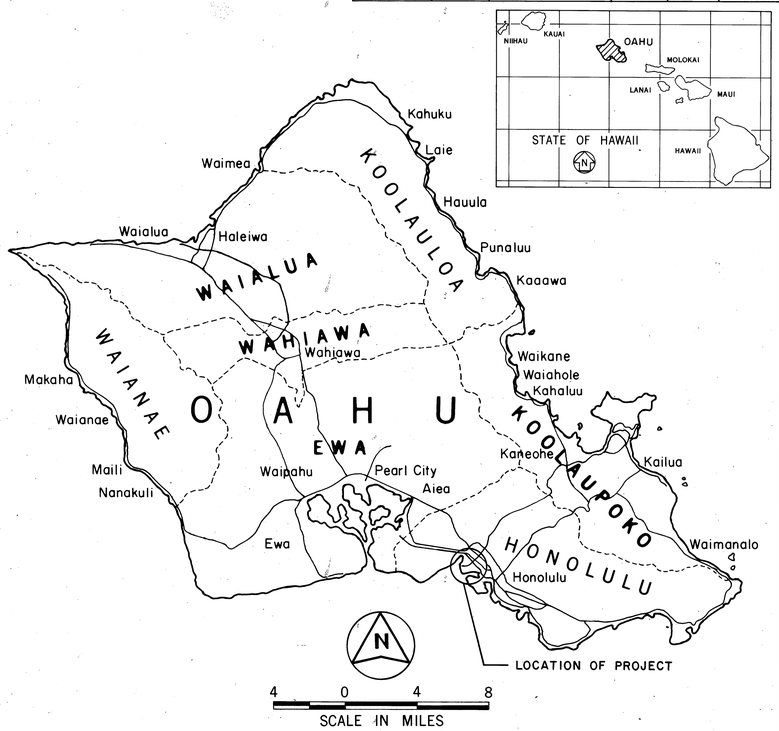

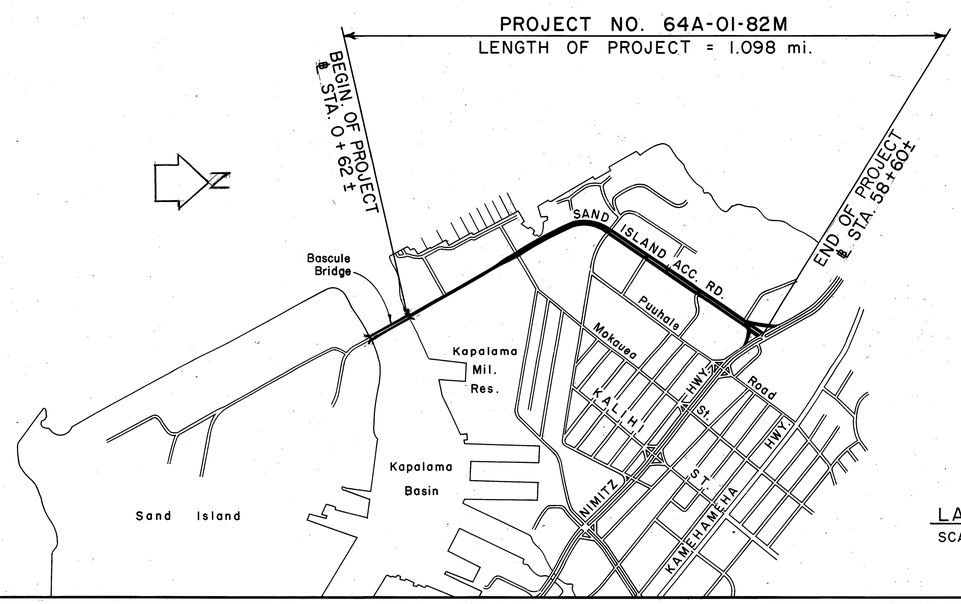

LAYOUT PLAN

SCALE: 1" = 1,000'

"ALL CHANGES MADE DURING CONSTRUCTION HAVE BEEN INCORPORATED ON THESE PLANS EXCEPT CHANGES IN THE ORIGINAL THEORETICAL QUANTITIES."

David Yamashiro — RESIDENT ENGINEER — 5/17/83 DATE

DEPARTMENT OF TRANSPORTATION
STATE OF HAWAII

APPROVED:

James R. Carroll — DIR. OF TRANSPORTATION — 4/14/82 DATE

Unit "E" — DESIGNED BY

A. Yamaguchi — P. S. & E. BY

548-4125 — PHONE

DATE

1