FED ROAD DIST. NO	STATE	FED. AID PROJ. NO.	FISCAL YEAR	SHEET NO.	TOTAL SHEETS
HAWAII	HAW.	S-0630(11) S-0630(7)	1968	1	83

Revised: June 23, 1969

INDEX TO DRAWINGS

COMPOSITE AND SET SHT. NO.	DESCRIPTION
1	TITLE SHEET
2-3	TYPICAL ROADWAY SECTIONS
4-8 *	PLAN & PROFILE, DRAINAGE PLANS
9	SUPERELEVATION DIAGRAM
10	BORING LOGS
11	INTERSECTION DETAILS
12-18, 18A, 18B	MISCELLANEOUS AND STANDARD ROADWAY DETAILS
19-36, 36A	DRAINAGE DETAILS
37-39	RETAINING WALL PLAN AND DETAILS
40-52	UTILITY PLANS AND DETAILS
53-62 *	TRAFFIC SIGNS, LANDSCAPING AND PAVEMENT MARKERS PLANS AND DETAILS
63-83	CROSS SECTIONS
* C.O. 7 S-1	PLAN & PROFILE
* C.O. 62 S-1-C.O. 62 S-8	SPRINKLER SYSTEM

STATE OF HAWAII

DEPARTMENT OF TRANSPORTATION

HIGHWAYS DIVISION

HONOLULU, HAWAII

"AS BUILT"

PLANS FOR

CONSTRUCTION OF

MOKAPU SADDLE ROAD

(KAILUA INTERCHANGE TO MOKAPU ROAD EXTENSION)

FEDERAL AID SECONDARY PROJECT NO. S-0630(11)

AND

FEDERAL AID SECONDARY PROJECT NO. S-0630(7)

DISTRICT OF KOOLAUPOKO

ISLAND OF OAHU

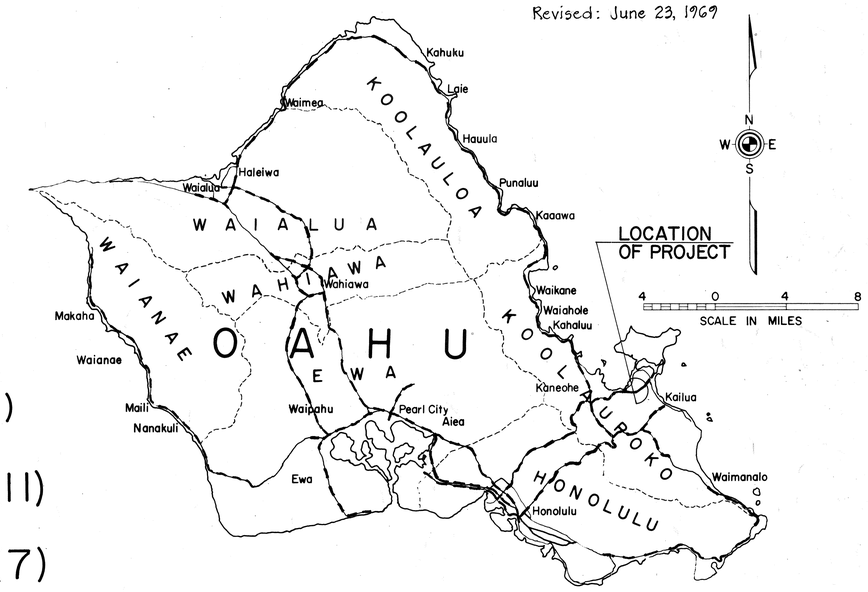

NOTE:

ALL CHANGES MADE DURING CONSTRUCTION HAVE BEEN INCORPORATED ON THESE PLANS IN RED EXCEPT CHANGES IN THE ORIGINAL THEORETICAL QUANTITIES.

Dennis T. Hirai — PROJECT ENGINEER — 12-6-74 DATE

NOTE:

THIS PROJECT ADVERTISED AND CONSTRUCTED WITH F.A.I. PROJECT NO. I-H3-1(7):13

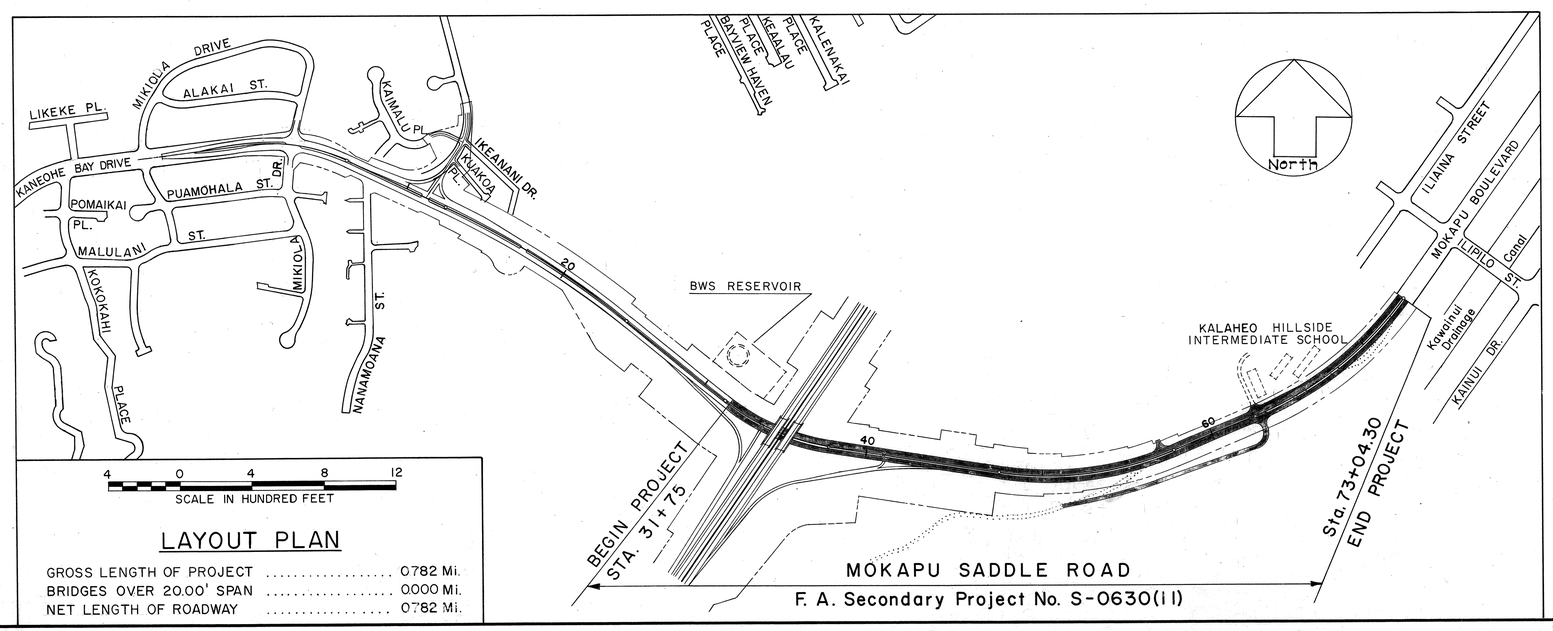

LAYOUT PLAN

GROSS LENGTH OF PROJECT	0.782 Mi.
BRIDGES OVER 20.00' SPAN	0.000 Mi.
NET LENGTH OF ROADWAY	0.782 Mi.

DESIGN CLASSIFICATION

ADT 1966	8100	D	65/35
DESIGN ADT (1986)	9600	T	3%
DHV	1100	V	50 M.P.H.

DEPARTMENT OF TRANSPORTATION
BUREAU OF PUBLIC ROADS
APPROVED:
Joseph T. Sugawara for DIVISION ENGINEER — 7/1/69 DATE

DEPARTMENT OF TRANSPORTATION
STATE OF HAWAII
APPROVED:
E. Dewey Wright for DIR. OF TRANSPORTATION — 4/8/69 DATE

S. F. Yuen — DESIGN ENG'R. | "B" — HWY DESIGN UNIT | 548-2211 Local 301 — PHONE | April, 1969 — DATE