FED. ROAD DIST. NO.	STATE	PROJ. NO.	FISCAL YEAR	SHEET NO.	TOTAL SHEETS
HAWAII	HAW.	HWY-0-03-72	1972	1	5

INDEX TO DRAWINGS

SHEET NO.	DESCRIPTION
1	TITLE SHEET
2 - 4	PLANS
5	ST'D. DET. - PAVEMENT MARKERS

STATE OF HAWAII

DEPARTMENT OF TRANSPORTATION
HIGHWAYS DIVISION

HONOLULU, HAWAII

"AS BUILT"
PLANS FOR

LIKELIKE HIGHWAY AND KANEOHE BAY DRIVE RESURFACING AND RECONSTRUCTION

PROJECT NO. HWY-0-03-72

DISTRICT OF KOOLAUPOKO
ISLAND OF OAHU

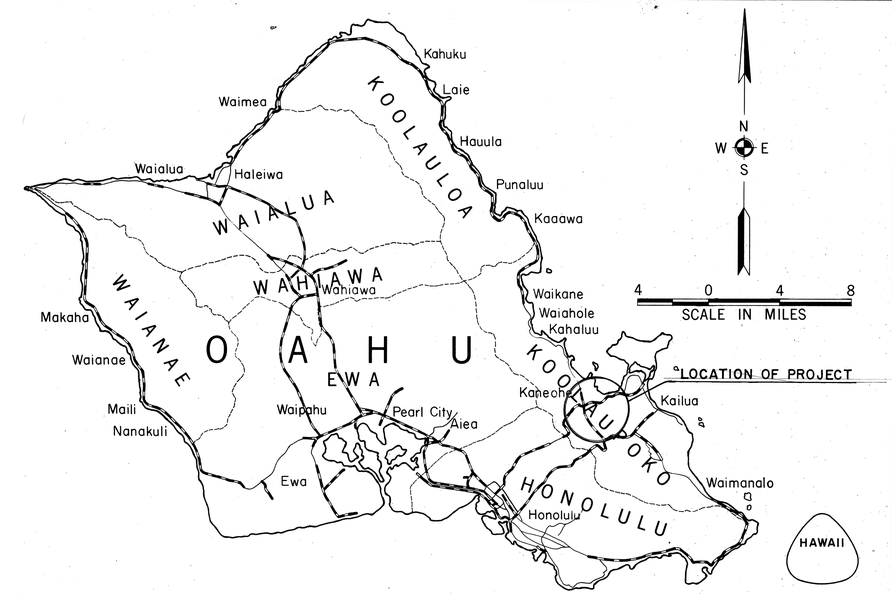

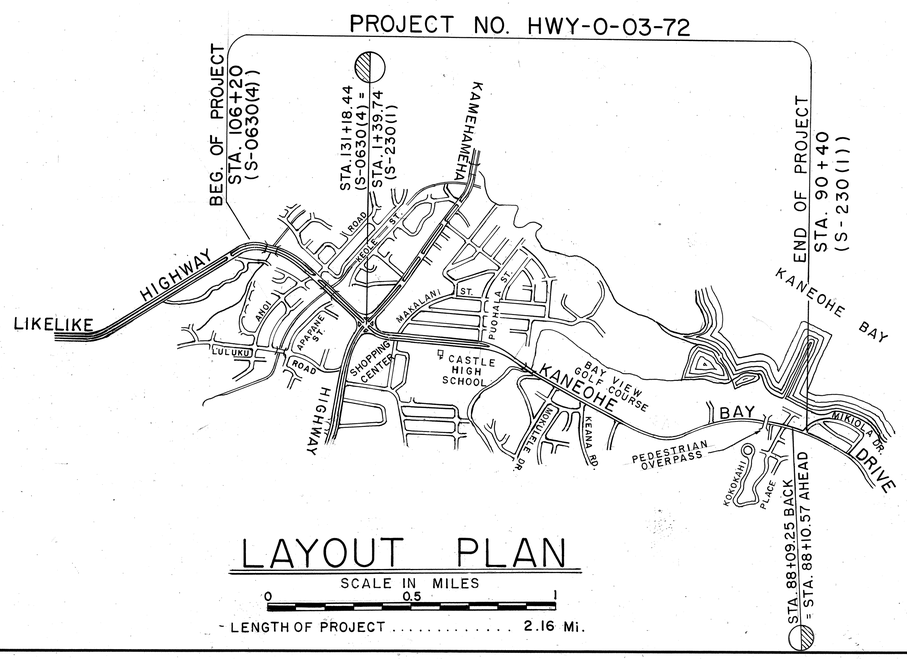

LAYOUT PLAN

SCALE IN MILES
0 0.5 1

LENGTH OF PROJECT ..... 2.16 Mi.

NOTE:

ALL CHANGES MADE DURING CONSTRUCTION HAVE BEEN NOTED IN RED ON THESE TRACINGS AND CHECKED BY:

H. Hamuke
PROJECT ENGINEER

11/12/73
DATE

FOR ACTUAL QUANTITES, REFER PROJECT LEDGER AND/OR COMPUTATION BOOK

DEPARTMENT OF TRANSPORTATION
STATE OF HAWAII

APPROVED:

Mummy Lee
For DIR. OF TRANSPORTATION

6/8/72
DATE

DESIGNED BY D. Bevier P. S. & E. BY 548-7537 PHONE June 1972 DATE