FED. ROAD DIST. NO.	STATE	FED. AID PROJ. NO.	FISCAL YEAR	SHEET NO.	TOTAL SHEETS
HAWAII	HAW.	U-0630(12)	1975	2	8

LEGEND

- 12" Signal Standard On Type I Standard
- 12" Signals On Type II-B Standard 20' Mast Arm w/Signals 12' Apart
- 12" Pedestrian Signal
- New Type B Pull Box
- New Type A Pull Box
- Loop Detector No. & Size As Indicated
- New Conduit No., Size And Cable As Noted
- Controller Type G

NOTE: See Sheet No. 3 for Construction Notes.

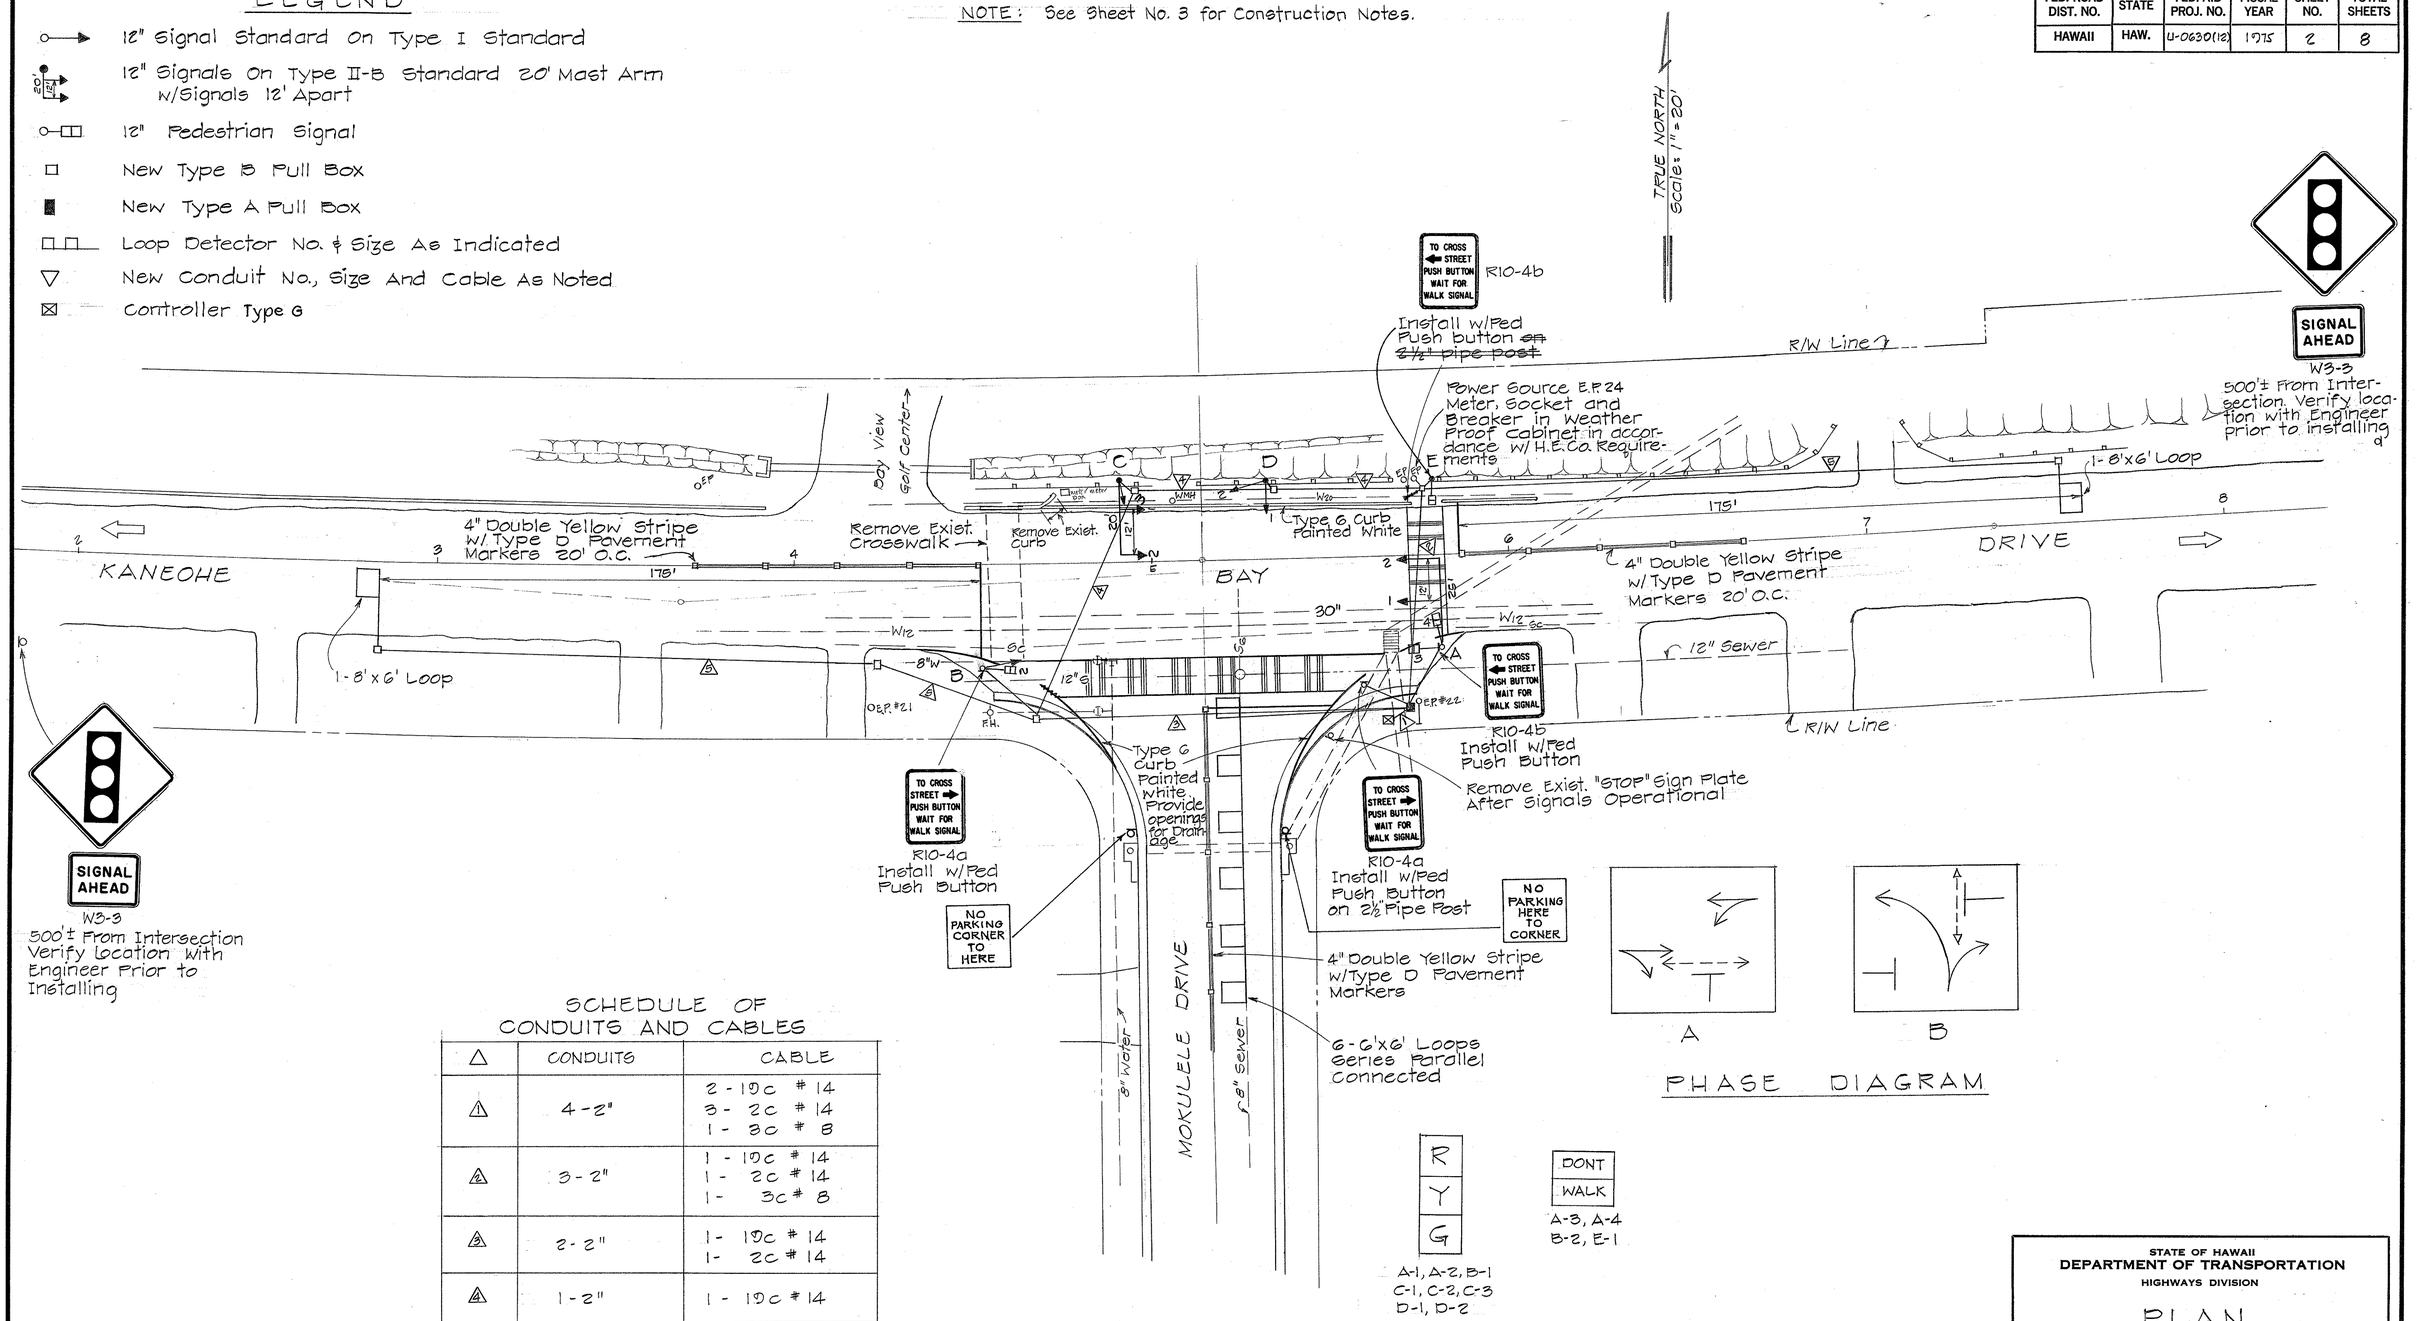

SCHEDULE OF CONDUITS AND CABLES

△	CONDUITS	CABLE
1	4-2"	2-19c #14 3-2c #14 1-3c #8
2	3-2"	1-19c #14 1-2c #14 1-3c #8
3	2-2"	1-19c #14 1-2c #14
4	1-2"	1-19c #14
5	1-2"	1-2c #14

PHASE DIAGRAM

A-1, A-2, B-1
C-1, C-2, C-3
D-1, D-2

A-3, A-4
B-2, E-1

SIGNAL INDICATIONS

STATE OF HAWAII
DEPARTMENT OF TRANSPORTATION
HIGHWAYS DIVISION

PLAN

TRAFFIC SIGNAL SYSTEM
SIGNS, PAVEMENT MARKINGS

F.A.P. No. U-0630 (12)

Scale: As Shown Date June 1975

SHEET No. 1 OF 1 SHEETS

ORIGINAL PLAN
NOTE BOOK No.
SURVEY PLOTTED BY DATE
DRAWN BY "
TRACED BY "
DESIGNED BY "
QUANTITIES BY "
CHECKED BY "

2

0-5-12