FED. ROAD DIST. NO.	STATE	PROJ. NO.	FISCAL YEAR	SHEET NO.	TOTAL SHEETS
HAWAII	HAW.	FR-0300(11) 6300A-01-80M	1980	1	21

INDEX TO DRAWINGS

SHEET NO.	DESCRIPTION
1	TITLE SHEET
2-3	TYPICAL SECTION
4	TYPICAL STREET SURVEY MONUMENT ADJUSTMENT AND DETAILS OF COLD PLANE AREAS
5	BUS PULLOUT DETAILS
6-9	PLANS
10-15	PAVEMENT MARKINGS
16	MISCELLANEOUS DETAILS
17	VEHICLE LOOP DETECTORS
18-21	STANDARD DETAILS

STATE OF HAWAII

DEPARTMENT OF TRANSPORTATION

HIGHWAYS DIVISION

"AS BUILT"

PLANS FOR

LIKELIKE HIGHWAY RESURFACING

LULUKU ROAD TO KAMEHAMEHA HIGHWAY

FEDERAL AID PROJECT NO. FR-0300(11)

DISTRICT OF KOOLAUPOKO

AND

KANEOHE BAY DRIVE RESURFACING

KAMEHAMEHA HIGHWAY TO MOKAPU SADDLE ROAD

PROJECT NO. 6300A-01-80M

DISTRICT OF KOOLAUPOKO

ISLAND OF OAHU

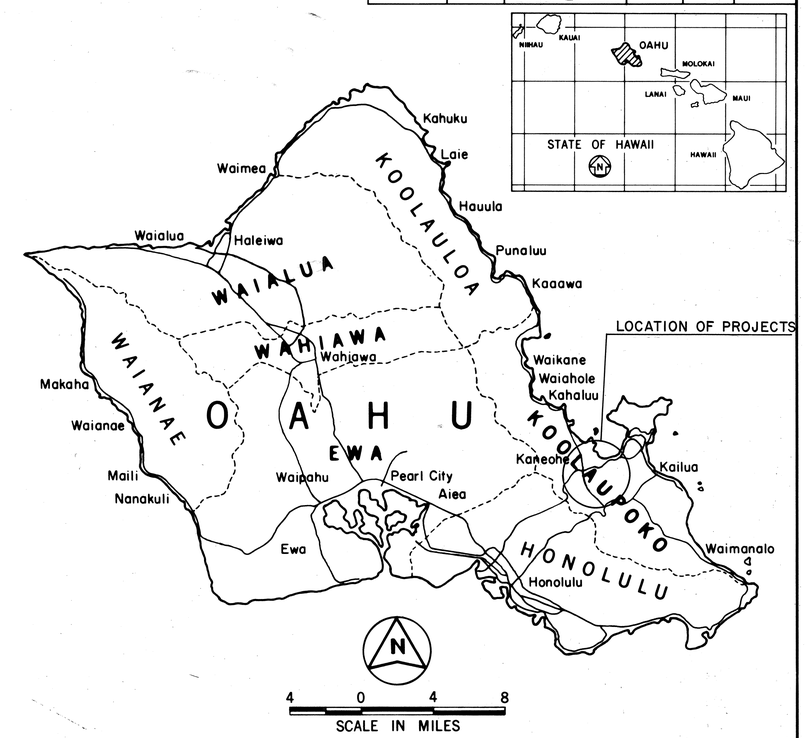

DESIGN CLASSIFICATION

CURRENT ADT (1980)	40,500
DESIGN ADT (2000)	69,200
DHV	4,500
T_{24}	4 %

ALL CHANGES MADE DURING CONSTRUCTION HAVE BEEN INCORPORATED ON THESE PLANS EXCEPT CHANGES IN THE ORIGINAL THEORETICAL QUANTITIES.

Robert Y. Muronaka — 7/15/81

PROJECT ENGINEER — DATE

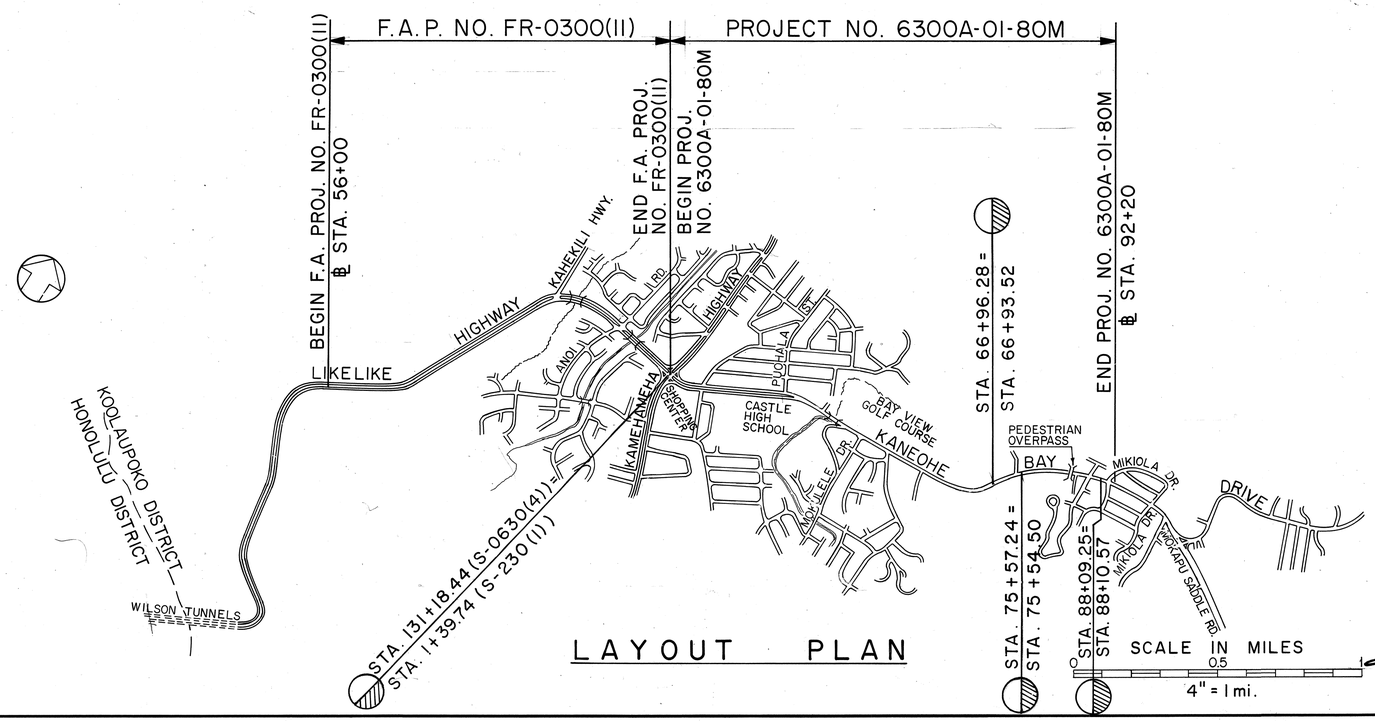

LAYOUT PLAN

DEPARTMENT OF TRANSPORTATION FEDERAL HIGHWAY ADMINISTRATION	
APPROVED:	
For DIVISION ADMINISTRATOR	2-7-80 DATE

DEPARTMENT OF TRANSPORTATION STATE OF HAWAII	
APPROVED:	
James R. Carvas For DIR. OF TRANSPORTATION	1/26/80 DATE

DESIGN UNIT "A" — DESIGNED BY: R. Mikami — P. S. & E. BY: 548-7534 — PHONE: Feb 7, 1980 — DATE