FED. ROAD DIST. NO.	STATE	FED. AID PROJ. NO.	FISCAL YEAR	SHEET NO.	TOTAL SHEETS
HAWAII	HAW.	HES-6300(I)	1984	1	23

INDEX TO DRAWINGS

SHEET NO.	DESCRIPTION
1	TITLE SHEET
2	TYPICAL SECTION, DETAILS AND GENERAL NOTES
3 - 4	PLAN
5 - 6	SPRINKLER PLAN AND DETAILS
7	SIGNING & PAV'T MARKING PLAN
8	TRAFFIC SIGNAL PLAN
9 - 10	TYPICAL DETAILS
11 - 23	STANDARD DETAILS

STATE OF HAWAII

DEPARTMENT OF TRANSPORTATION

HIGHWAYS DIVISION

HONOLULU, HAWAII

"AS-BUILT"

PLANS FOR

MOKAPU BOULEVARD

MODERNIZATION OF TRAFFIC SIGNALS AT ONEAWA STREET

FEDERAL AID PROJECT NO. HES-6300(I)

DISTRICT OF KOOLAUPOKO
ISLAND OF OAHU

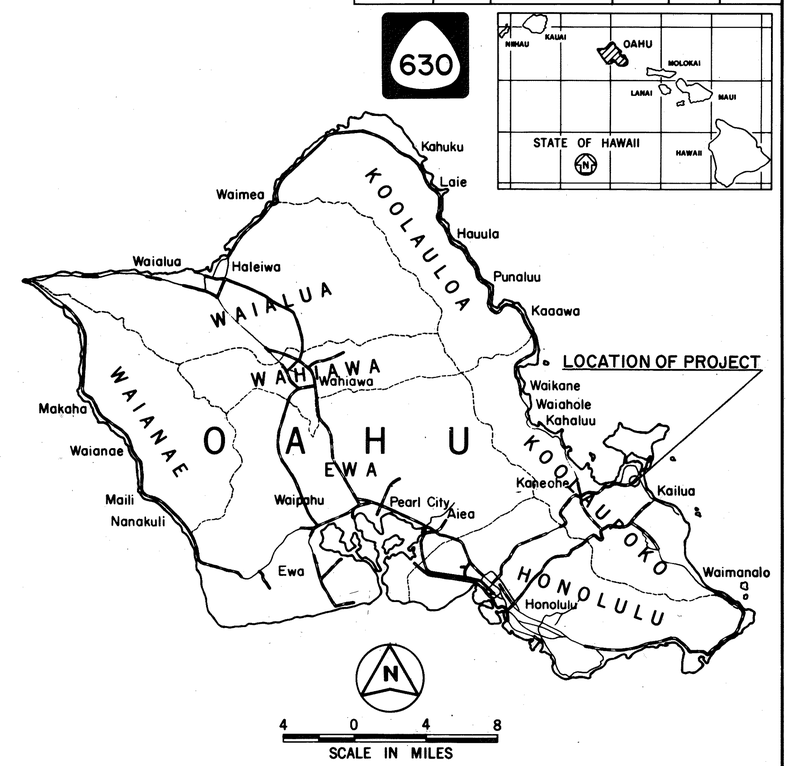

FEDERAL AID PROJECTS PREVIOUSLY CONSTRUCTED OR UNDER CONSTRUCTION

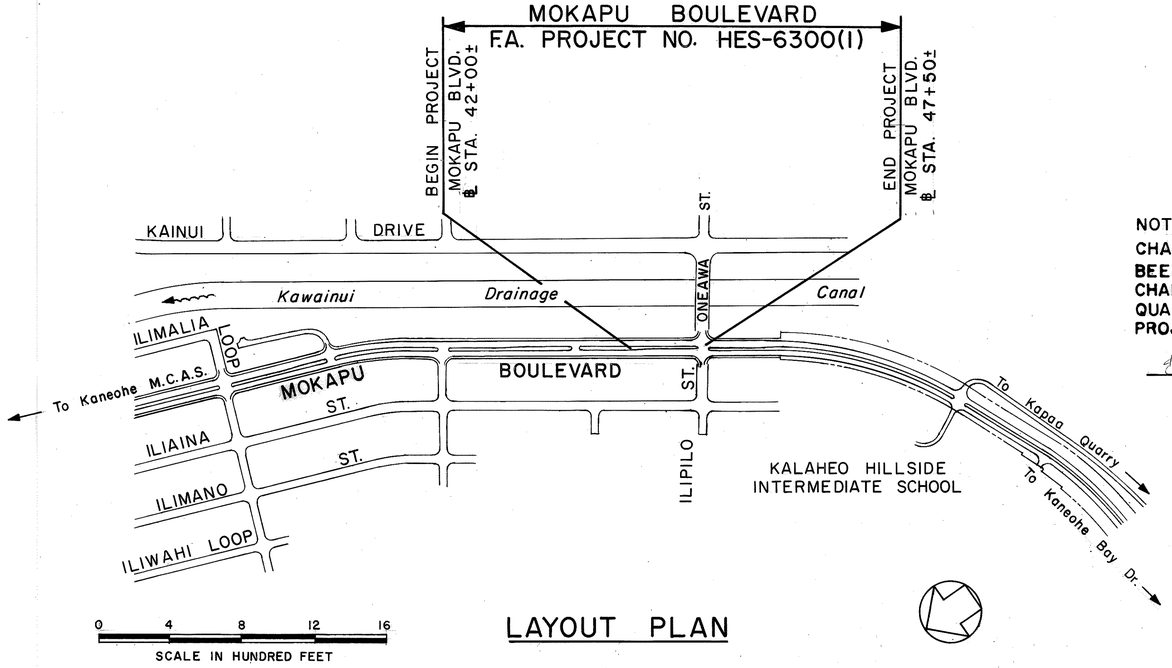

LAYOUT PLAN

NOTE:
CHANGES MADE DURING CONSTRUCTION HAVE BEEN INCORPORATED ON THESE PLANS EXCEPT CHANGES IN THE ORIGINAL THEORETICAL QUANTITIES. FOR ACTUAL QUANTITIES, REFER TO PROJECT LEDGER AND/OR COMPUTATION BOOK.

Dennis T. Higa — RESIDENT ENGINEER — 6/13/88 DATE

DESIGN DESIGNATION

CURRENT ADT (1983)	9,778
DESIGN ADT (2003)	11,538
DHV	1,731
D	60/40
T	4%
V	30 MPH

DEPARTMENT OF TRANSPORTATION
FEDERAL HIGHWAY ADMINISTRATION
APPROVED:
for DIVISION ADMINISTRATOR — 4/5/84 DATE

DEPARTMENT OF TRANSPORTATION
STATE OF HAWAII
APPROVED:
for DIR. OF TRANSPORTATION — 2/27/84 DATE

R. TSUZUKI — DESIGNED BY
R. TSUZUKI — P. S. & E. BY
548-2456 — PHONE
JAN. 1984 — DATE