| FED. ROAD DIST. NO. | STATE | PROJ. NO. | FISCAL YEAR | SHEET NO. | TOTAL SHEETS |
|---|---|---|---|---|---|
| HAWAII | HAW. | 65A-01-89 | 1989 | 1 | 9 |

INDEX TO DRAWINGS

| SHEET NO. | DESCRIPTION |
|---|---|
| 1 | TITLE SHEET |
| 2 | STANDARD PLAN SUMMARY |
| 3 | GENERAL NOTES & LEGEND |
| 4 - 5 | TYPICAL SECTIONS & DETAILS |
| 6 | PLAN |
| 7 - 9 | SIGNING & PAVEMENT MARKING PLANS & DETAILS |

STATE OF HAWAII

# DEPARTMENT OF TRANSPORTATION

HIGHWAYS DIVISION

HONOLULU, HAWAII

"AS-BUILT"

PLANS FOR

# KANEOHE BAY DRIVE
# LEFT TURN LANES AT KOKOKAHI PLACE,
# LIKEKE PLACE AND MIKIOLA DRIVE
# PROJECT NO. 65A-01-89

**DISTRICT OF KOOLAUPOKO**
**ISLAND OF OAHU**

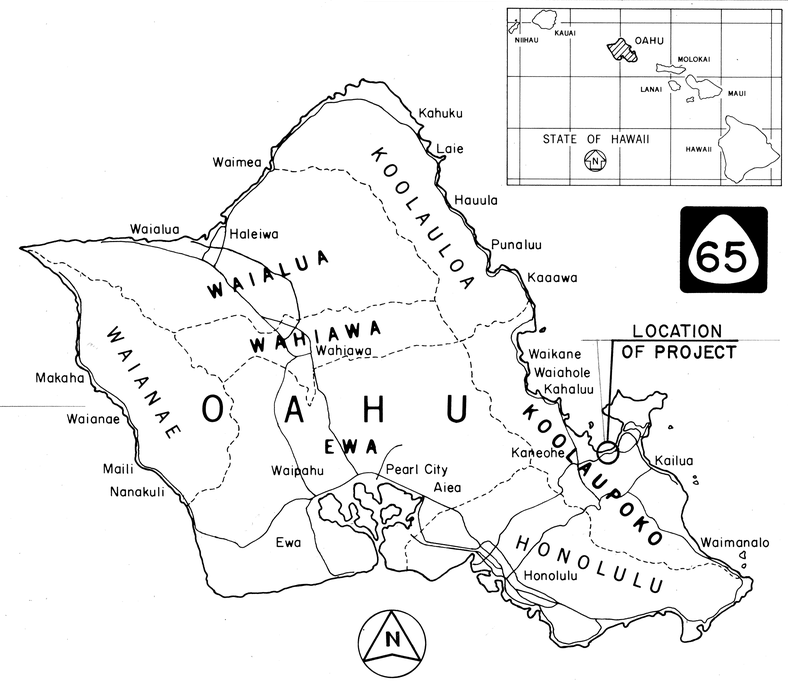


MILE POST 1.50 TO MILE POST 1.77

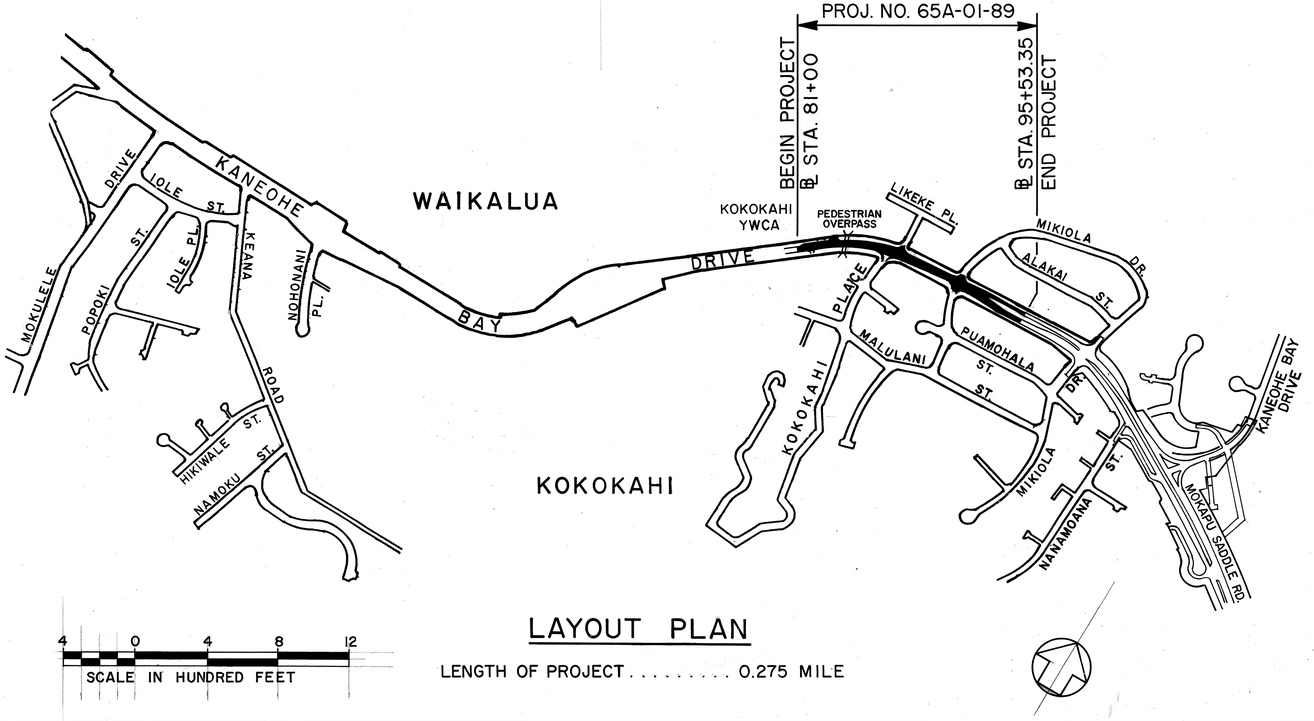


## LAYOUT PLAN

LENGTH OF PROJECT..... 0.275 MILE

CHANGES MADE DURING CONSTRUCTION HAVE BEEN INCORPORATED ON THESE PLANS EXCEPT CHANGES IN THE ORIGINAL THEORETICAL QUANTITIES. FOR ACTUAL QUANTITIES, REFER TO PROJECT LEDGER AND/OR COMPUTATION BOOK.

Glenn Pang — 10/6/90
RESIDENT ENGINEER — DATE

| DATE | REVISION |
|---|---|
| 6/29/90 | Title change as per Addendum No.1. |

DEPARTMENT OF TRANSPORTATION
STATE OF HAWAII

APPROVED:

Dan I. Kochi — 6/12/90
DIR. OF TRANSPORTATION — DATE

ALLAN NISHIMURA — DESIGNED BY
P. S. & E. BY
548-7490 — PHONE
JUNE, 1990 — DATE

ADD.1